

UNITED STATES  
DEPARTMENT OF THE INTERIOR  
BUREAU OF LAND MANAGEMENTFORM APPROVED  
OMB NO. 1004-0135  
Expires: July 31, 2010**SUNDRY NOTICES AND REPORTS ON WELLS**  
*Do not use this form for proposals to drill or to re-enter an abandoned well. Use form 3160-3 (APD) for such proposals.*5. Lease Serial No.  
NMNM67980

6. If Indian, Allottee or Tribe Name

**SUBMIT IN TRIPLICATE - Other instructions on reverse side.**

7. If Unit or CA/Agreement, Name and/or No.

1. Type of Well

☒ Oil Well ☐ Gas Well ☐ Other

8. Well Name and No.

SANTA FE FEDERAL 1

2. Name of Operator

RKI EXPLORATION&amp;PRODUCTION LLC

Contact: JESSICA M DEMARCE

E-Mail: jessica.demarce@wpenergy.com

9. API Well No.

30-015-25590

3a. Address

3500 ONE WILLIAMS CENTER MD35  
TULSA, OK 74172

3b. Phone No. (include area code)

Ph: 539-573-3521

10. Field and Pool, or Exploratory

DELAWARE

4. Location of Well (Footage, Sec., T., R., M., or Survey Description)

Sec 35 T22S R28E 2080FNL 2080FEL

11. County or Parish, and State

EDDY COUNTY, NM

## 12. CHECK APPROPRIATE BOX(ES) TO INDICATE NATURE OF NOTICE, REPORT, OR OTHER DATA

TYPE OF SUBMISSION	TYPE OF ACTION			
<input type="checkbox"/> Notice of Intent	<input type="checkbox"/> Acidize	<input type="checkbox"/> Deepen	<input type="checkbox"/> Production (Start/Resume)	<input type="checkbox"/> Water Shut-Off
<input checked="" type="checkbox"/> Subsequent Report	<input type="checkbox"/> Alter Casing	<input type="checkbox"/> Fracture Treat	<input type="checkbox"/> Reclamation	<input type="checkbox"/> Well Integrity
<input type="checkbox"/> Final Abandonment Notice	<input type="checkbox"/> Casing Repair	<input type="checkbox"/> New Construction	<input type="checkbox"/> Recomplete	<input checked="" type="checkbox"/> Other
	<input type="checkbox"/> Change Plans	<input type="checkbox"/> Plug and Abandon	<input type="checkbox"/> Temporarily Abandon	Site Facility Diagram/Security Plan
	<input type="checkbox"/> Convert to Injection	<input type="checkbox"/> Plug Back	<input type="checkbox"/> Water Disposal	

13. Describe Proposed or Completed Operation (clearly state all pertinent details, including estimated starting date of any proposed work and approximate duration thereof. If the proposal is to deepen directionally or recomplete horizontally, give subsurface locations and measured and true vertical depths of all pertinent markers and zones. Attach the Bond under which the work will be performed or provide the Bond No. on file with BLM/BIA. Required subsequent reports shall be filed within 30 days following completion of the involved operations. If the operation results in a multiple completion or recompletion in a new interval, a Form 3160-4 shall be filed once testing has been completed. Final Abandonment Notices shall be filed only after all requirements, including reclamation, have been completed, and the operator has determined that the site is ready for final inspection.)

Attached are updated SFD from 10/19/2016 and updated ABSM from 10/19/2016.

ENTERED 02/03/17  
INTO AFMSSSC 4-11-17  
Accepted for record - NMOCDAccepted for Record Purposes.  
Approval Subject to Onsite Inspection.  
Date: 02/03/17


14. I hereby certify that the foregoing is true and correct. Electronic Submission #355524 verified by the BLM Well Information System For RKI EXPLORATION&PRODUCTION LLC, sent to the Carlsbad Committed to AFMSS for processing by DEBORAH MCKINNEY on 10/21/2016 ()		BUREAU OF LAND MANAGEMENT ARTESIA DISTRICT APR 10 2017 RECEIVED
Name (Printed/Typed) JESSICA M DEMARCE	Title REGULATORY TECHNICIAN	
Signature (Electronic Submission)	Date 10/21/2016	

## THIS SPACE FOR FEDERAL OR STATE OFFICE USE

Approved By <u>Sherry J. L. L.</u>	Title <u>EPS/LIC</u>	Date <u>2.3.17</u>
Conditions of approval, if any, are attached. Approval of this notice does not warrant or certify that the applicant holds legal or equitable title to those rights in the subject lease which would entitle the applicant to conduct operations thereon.		Office


Title 18 U.S.C. Section 1001 and Title 43 U.S.C. Section 1212, make it a crime for any person knowingly and willfully to make to any department or agency of the United States any false, fictitious or fraudulent statements or representations as to any matter within its jurisdiction.

**\*\* OPERATOR-SUBMITTED \*\* OPERATOR-SUBMITTED \*\* OPERATOR-SUBMITTED \*\***

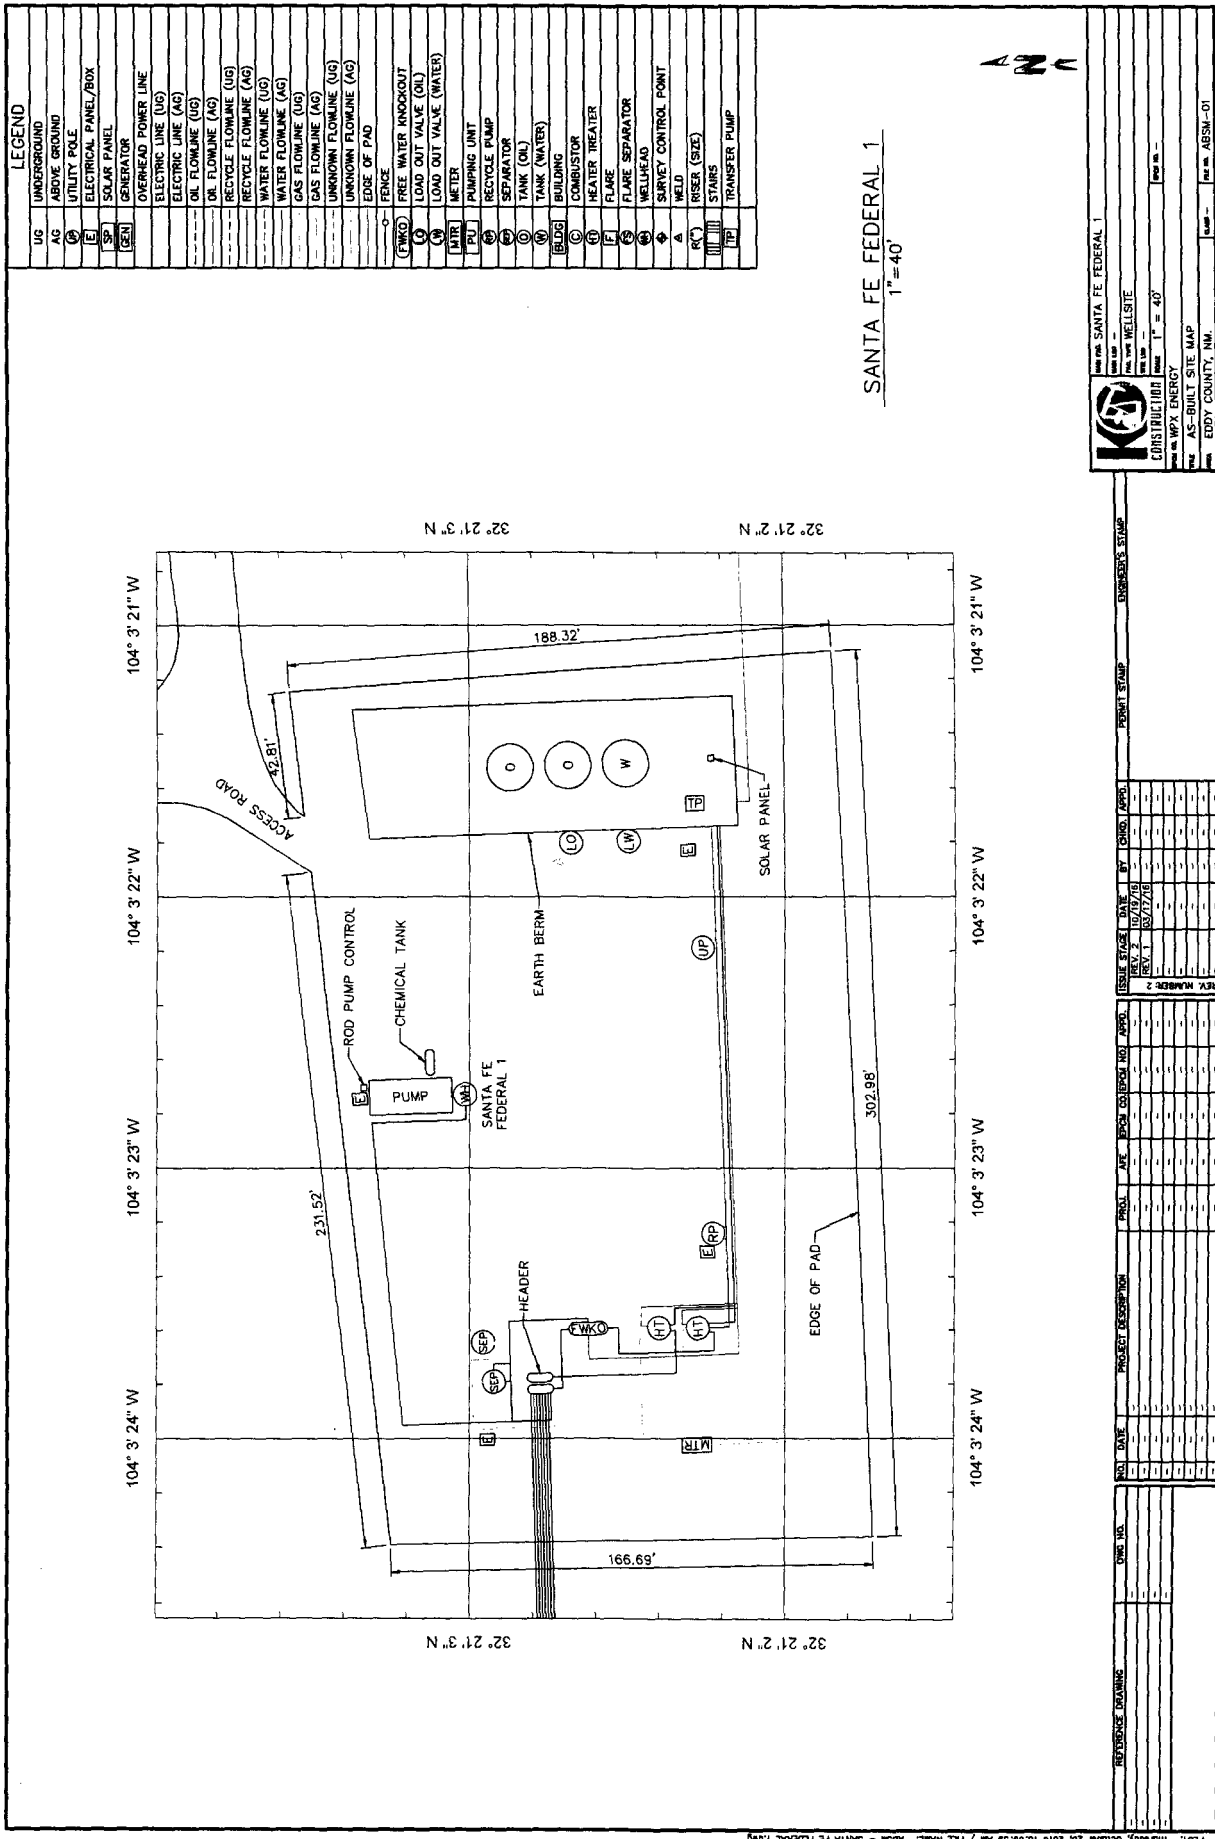

LEGEND	
UG	UNDERGROUND
AG	ABOVE GROUND
U	UTILITY POLE
E	ELECTRICAL PANEL/BOX
SP	SOLAR PANEL
GEN	GENERATOR
	OVERHEAD POWER LINE
	ELECTRIC LINE (UG)
	OIL FLOWLINE (AG)
	OIL FLOWLINE (UG)
	RECYCLE FLOWLINE (AG)
	RECYCLE FLOWLINE (UG)
	WATER FLOWLINE (AG)
	WATER FLOWLINE (UG)
	GAS FLOWLINE (AG)
	GAS FLOWLINE (UG)
	UNKNOWN FLOWLINE (UG)
	EDGE OF PAD
	FENCE
(FWKO)	FREE WATER KNOCKOUT
(LO)	LOAD OUT VALVE (OIL)
(LA)	LOAD OUT VALVE (WATER)
(MTR)	METER
(PU)	PUMPING UNIT
(S)	SEPARATOR
(T)	TANK (OIL)
(TW)	TANK (WATER)
(BUD)	BUILDING
(C)	COMBUSTOR
(HT)	HEATER TREATER
(F)	FLARE
(S)	FLARE SEPARATOR
(W)	WELLHEAD
(SC)	SURVEY CONTROL POINT
(A)	WELD
(R)	RISER (SIZE)
(ST)	STAIRS
(TP)	TRANSFER PUMP

SANTA FE FEDERAL 1  
1"=40'

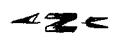

K&S CONSTRUCTION

AS-BUILT SITE MAP

EDDY COUNTY, NM

DATE: 10/17/15

REV. 1: 10/17/15

REV. 2: 10/17/15

SCALE: 1"=40'


PROJECT: SANTA FE FEDERAL 1

CLIENT: WPX ENERGY

DESIGNER: K&S CONSTRUCTION

CHECKED: [Signature]

APPROVED: [Signature]

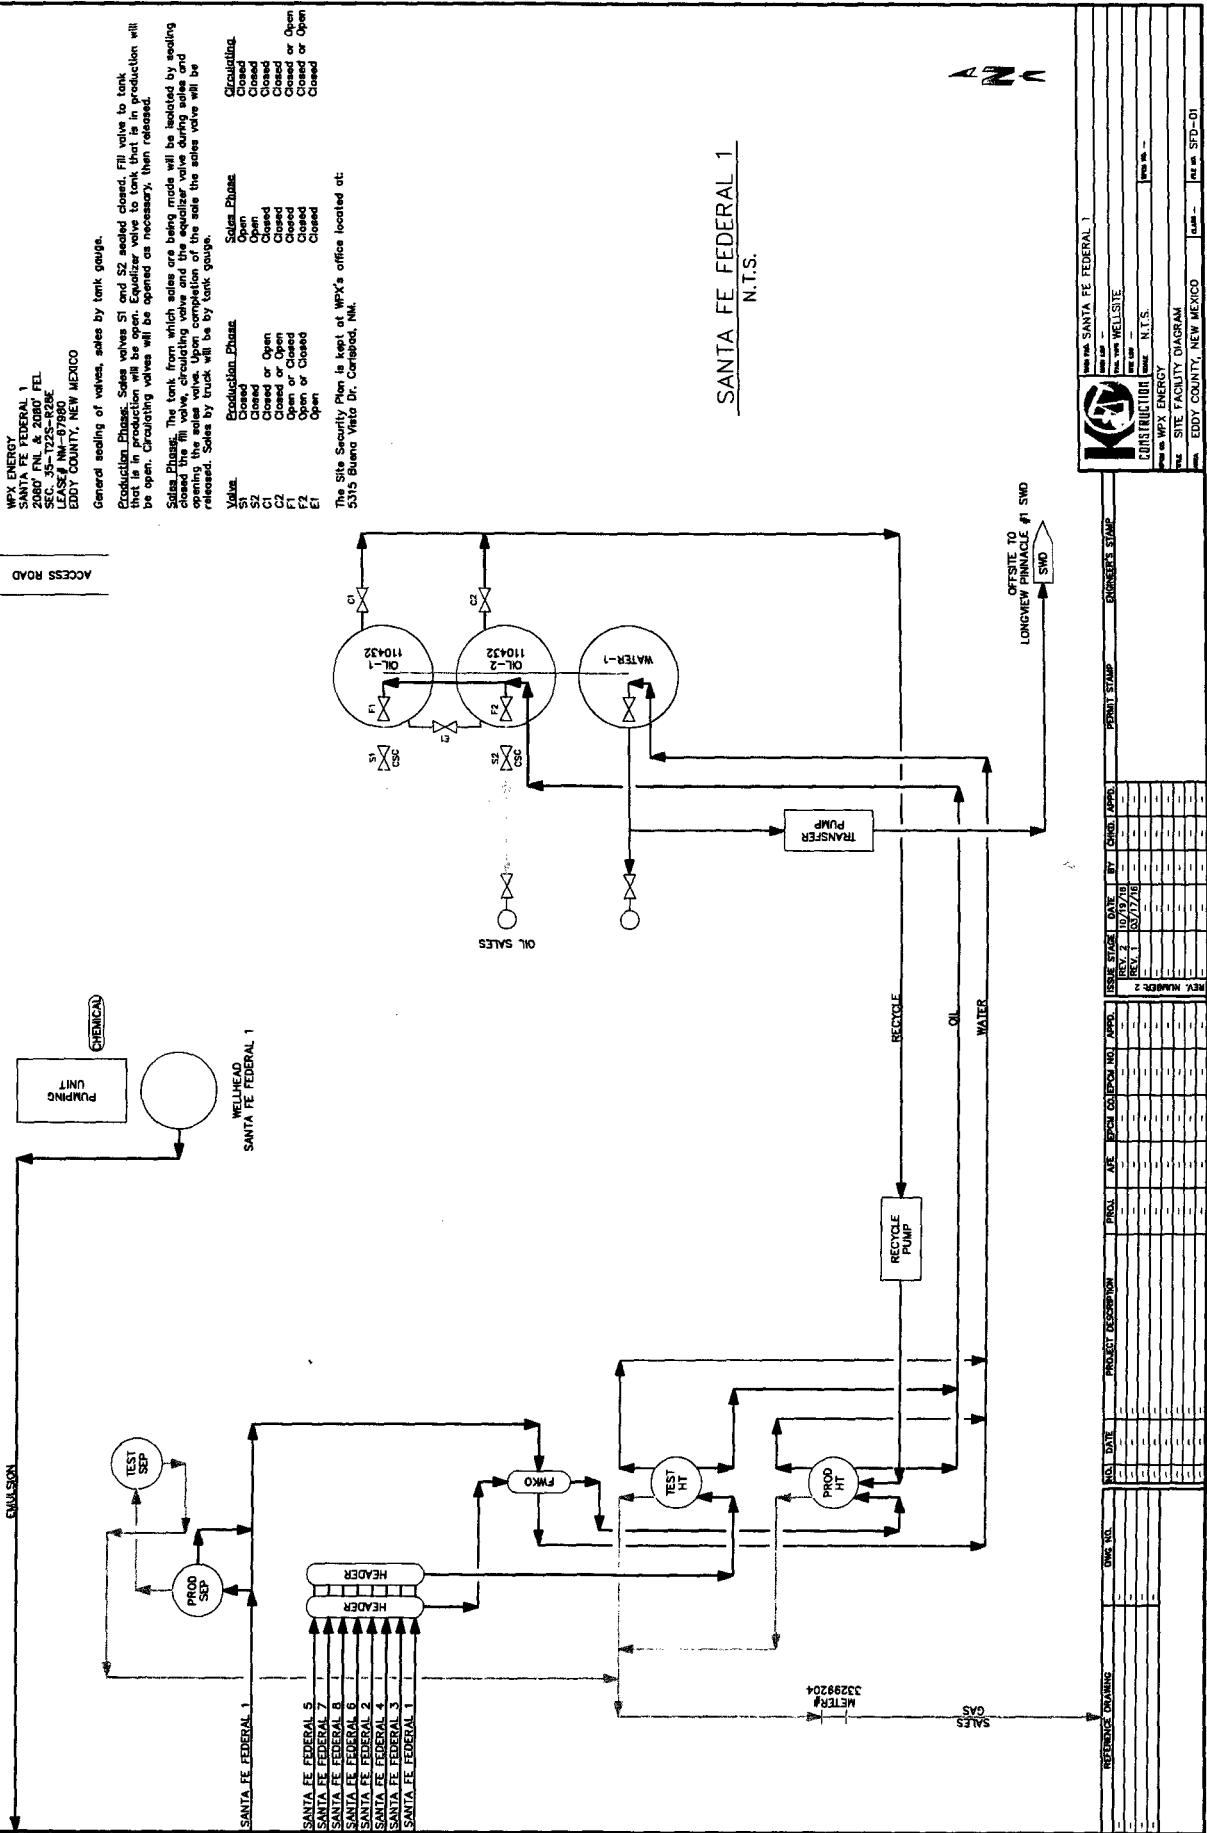

WPK ENERGY  
SANTA FE FEDERAL 1  
SANTA FE FEDERAL 1  
SEC. 35-725-8286  
LEASE# NM-87880  
EDDY COUNTY, NEW MEXICO

General setting of valves, sales by tank gauge.

Production Phase: Sales valves S1 and S2 sealed closed. Fill valve to tank that is in production will be open. Equalizer valve to tank that is in production will be open. Circulating valves will be opened as necessary. Then released.

Sales Phase: The tank from which sales are being made will be isolated by sealing closed the fill valve, circulating valve and equalizer valve during sales and opening the sales valve. Sales by truck will be by tank gauge.

Valves: S1, S2, C1, C2, F1, F2, E1, E2, E3, E2169, E2