

2860.5'

DISTRICT I 1625 N. FRENCH DR., HOBBS, NM 88240 E Phone: (575) 393-0101 Fax: (575) 393-0720 DISTRICT II 811 S. FIRST ST., ARTESIA, NM 88210 Phone: (575) 748-1283 Fax: (575) 748-9720 DISTRICT III 1000 RIO BRAZOS RD., AZTEC, NM 8741(Phone: (505) 334-6178 Fax: (505) 334-6171	OIL CONSERV. 1220 SOUTH Santa Fe, Ne	of New Mexico Iral Resources Department ATION DIVISION ST. FRANCIS DEISTRICTI AFTES W Mexico 87505	D 0 (00
DISTRICT IV 1220 S. ST. FRANCIS DR., SANTA FE, NM 87503			□ AMENDED REPORT
1220 S. ST. FRANCIS DR., SANTA FE, NM 8750 Phone: (505) 476-3460 Fax: (505) 476-3482	WELL LOCATION AND	ACREAGE DEDICATION PLAT	
API Number	Pool Code	Pool Name	
30-015-45166	98220	Purple Sage; Wolfca	amp Gas
Property Code	Prop	erty Name	Well Number
322243	LITTLEFIELD :	33 FEDERAL COM	805H
OGRID No.	Oper	ator Name	Elevation

COG OPERATING, LLC

229137

Surface Location


UL or lot No.	Section	Township	Range	Lot Idn	Feet from the	North/South line	Feet from the	East/West line	County
10	33	26-S	29-E		300	SOUTH	2466	WEST	EDDY

Bottom Hole Location If Different From Surface

UL or lot No.	Section	Township	Range	Lot Idn	Feet from the	North/South line	Feet from the	East/West line	County
С	28	26-S	29-E		201	NORTH	2546	WEST	EDDY
Dedicated Acres Joint or Infill Consolidation Code				Code Or	der No.	<u> </u>	L		L
463.13									

NO ALLOWABLE WILL BE ASSIGNED TO THIS COMPLETION UNTIL ALL INTERESTS HAVE BEEN CONSOLIDATED OR A NON-STANDARD UNIT HAS BEEN APPROVED BY THE DIVISION

SEE PAGE 2 PAGE 1 OF 2 W.O. #19-1205 DRAWN BY: WN

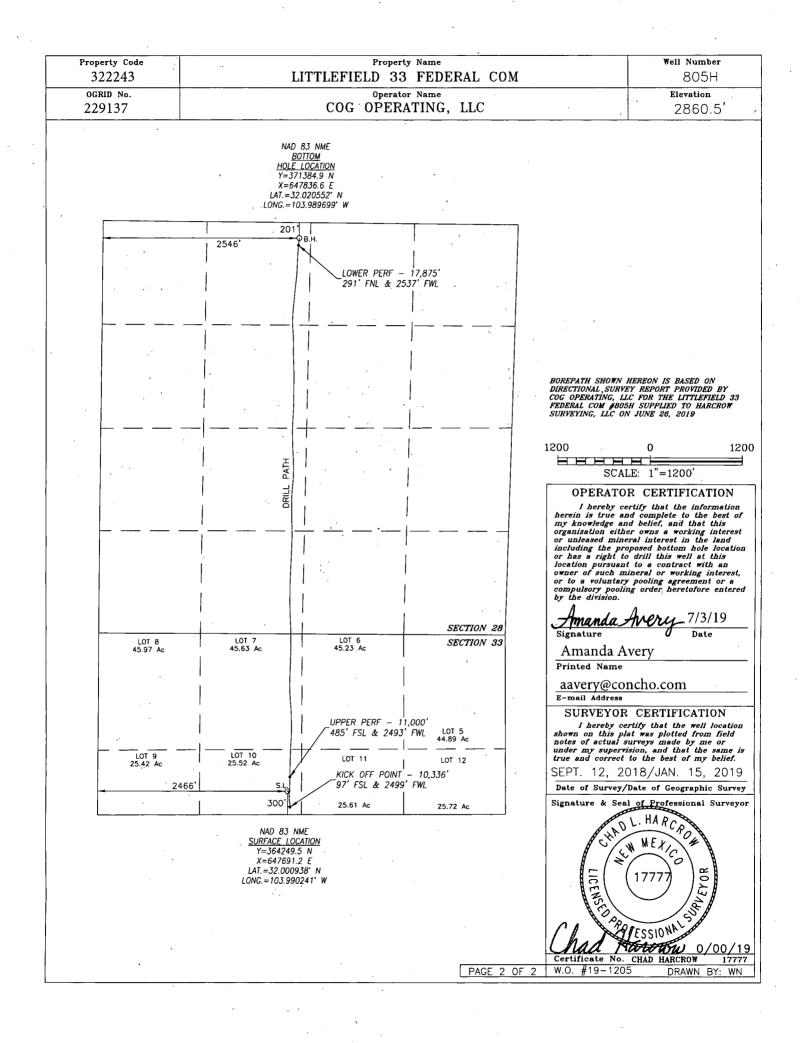

Intent As Drilled X		
API # 30-015-45166		
Operator Name:	Property Name:	Well Number
COG OPERATING, LLC	LITTLEFIELD 33 FEDERAL COM	805H

Kick Off Point (KOP)

UL 10	Section 33	Township 26S	Range 29E	Lot	Feet 97	From N/S SOUTH	Feet 2499	From E/W WEST	County EDDY
	Latitude 32.000379					1138	NAD 83		
102.0	52.000579				-103.990	-103.990138			05

First Take Point (FTP)

UL 100	Section 33	Township 26S	Range 29E	Lot	Feet 485	From N/S SOUTH	Feet 2494	From E/W WEST	County EDDY		
	Latitude 32.001446				Longitude -103.99	Longitude -103.990145				,	· .

Last Take Point (LTP)

UL C	Section 28	Township 26S	Range 29E	Lot	Feet 291	From N/S NORTH	Feet 2537	From E/W WEST	County EDDY
Latitu	Latitude					de		NAD	
32.0	32.020303				-103.	989731		83	

Is this well the defining well for the Horizontal Spacing Unit? No

Is this well an infill well?

Yes

If infill is yes please provide API if available, Operator Name and well number for Defining well for Horizontal Spacing Unit.

API # 30-015-45163		
Operator Name:	Property Name:	Well Number
COG Operating LLC	Littlefield 33 Federal Com	706H

KZ 06/29/2018