Form 3160-5 (June 1990)

N.M. Oil Cons. DIV-Dist 2

UNITED STATESW. Grand Avenue DEPARTMENT OF TAPING STAIL NIM 88210

FORM APPROVED Budget Bureau No. 1004-0135 Expires: March 31, 1993

BUREAU OF LAND MANAGEMENT

5. Lease Designation and Serial No. **SUNDRY NOTICES AND REPORTS ON WELLS** NM 556590 Do not use this form for proposals to drill or deepen or reentry to a different reservior. 6. If Indian, Allottee or Tribe Name Use "APPLICATION FOR PERMIT-" for such proposals SUBMIT IN TRIPLICATE 7. If Unit or CA, Agreement Designation 1. Type of well Other 8. Well Name and No. **T**Oil X Gas Federal 33 Com Well No. 3 2. Name of Operator CHEVRON U.S.A. PRODUCTION CO., INC. 9. API Well No. API No. 30-015-32180 3. Address and Telephone No. 15 SMITH ROAD, MIDLAND, TX 79705 Attn: Reggie Holzer (432) 687-7182 10. Field and Pool, or Exploratory Area 4. Location of Well (Footage, Sec., T., R., M., or Survey Description) Indian Basin Section 33, T21S - R23E 11. County or Parish, State 1,880' FSL - 1,980' FWL Eddy County, NM CHECK APPROPRIATE BOX(S) TO INDICATE NATURE OF NOTICE, REPORT, OR OTHER DATA TYPE OF ACTION TYPE OF SUBMISSION 12 X Notice of Intent Abandonment Change of Plans Recompletion New Construction Subsequent Report Plugging Back Non-Routine Fracturing Casing Repair Water Shut-Off Final Abandonment Notice Altering Casing Conversion to Injection Dispose Water Other Report results of multiple completion on Well

13. Decribe Proposed or Completed Operations (Clearly state all pertinent details, and give pertinent dates, including estimate date of starting any proposed work. If well is directionally drilled give subsurface locations and measured and true vertical depths for all markers and zones pertinent to this work.)*

Produced water from the subject well is collected at the Federal 33 Com #1 compressor station as shown on the attached drawings NMC-H33F331GU-00-01 and NMC-H33F33-3GU-00-01. The water is then truck hauled to the Bogle Flats Unit #2 Salt Water Disposal station located in Section 4, T22S, R23E, Eddy County, NM.

> RECEIVED OCT 2 9 2004 OCD-ARTESIA


APPROVAL SUBJECT TO GENERAL REQUIREMENTS AND SPECIAL STIPULATIONS ATTACHED

	MARCED					
14. I hereby certify that the forgoing is true and correction. Signed	Title Facilities Engineering Team Leader	Date October 5, 2004				
(This space for Federal or State of use) Approved by Conditions of approval, if any:	Title	Date				
Title 18 U.S.C. Section 1001, makes it a crime for any person kn	owingly and willfully to make to any department or agency of the United	States any false, fictitious or fraudulent statements				

C1 C2 II

COMPRESSOR #1 COMPRESSOR #2 OIL (WATER TANK (CONE ROOF)

OX 2019 THE
OX 2019 THE V1.
2 PHASE SEPARATOR
46° 00 x 18'-0" \$/\$
WARP 300 PSI @ 2507

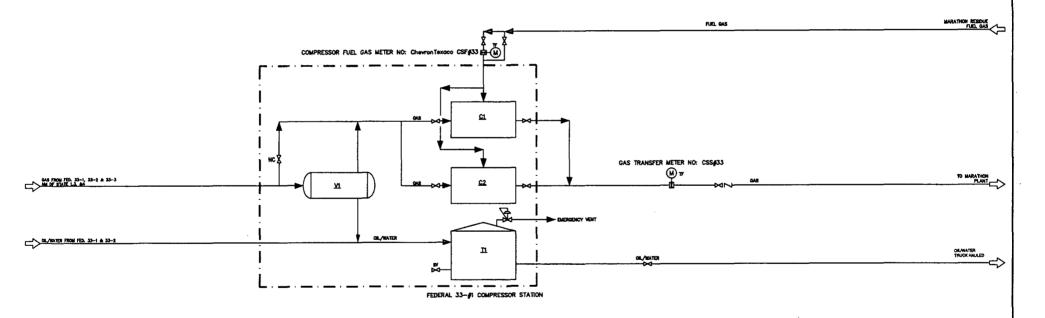

OPERATORS ADDRESS:
CHEVRONTEXACO INC.
P.O. BOX 1747
CARUSBAD, NM B8220
LEASE EN: NMM055858

\Box		REVISIONS				
ME	DATE	DESCRIPTION .	l PY	90	Æ	1
_	10/07/02	ISSUED FOR APPROVAL	BWD	**		
•	11/14/02	REVISED PER BLU COMMENTS	MAC			<u> </u>
T	10/20/03	ADDED BILET SEPARATOR AS PER REDITS COMMENTS	***			
2	8/5/04	ADDED WELL PED 33-3	*			
Г					Г	
Г			П	Г		EDOY C
$\overline{}$			-	_		DIGNETT

ChevronTexaco Permian Business Unit

NMCARISBAD
INDIAN BASIN FIELD
FEDERAL 33-1 COMPRESSOR STATION FOR FED 33-1
SECTION 33, 1830 FEL, 1830 FSL, T21S, R23E
PROCESS FLOW DIAGRAM


NOTES:

1. T-TURBER TYPE LIQUID METER (SEALED)

2. TH-TOTAL FLOW GAS METER

3. ALL VALVES OPEN DURBER PRODUCTION PHASE
(SEALE NOT RECOMED UNILES MOTED)

4. SH-SOLED CLESS MALVES DURBER PRODUCTION PHASE
(VALVES OPEN DURBER TRUCKS HALLAND)

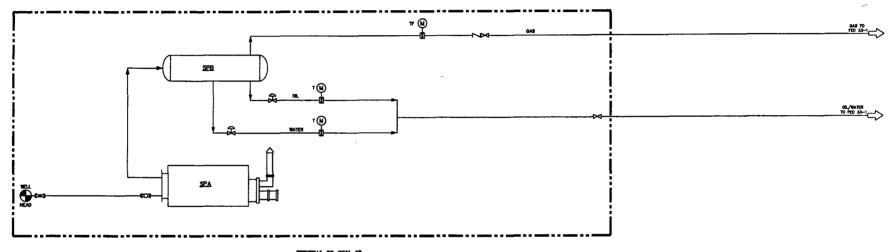

FEDERAL 33 COM 43 GAS METER NO'S: MARATHON 233C; Chevrontexago FED 33 COM3

NOTES
1. C-COUNTER TYPE LIQUID METER (SEALED)
2. T- TURBINE METER (LIQUID)
3. TFTOTAL FLOW METER (ASS)
4. ALL WALVES OPEN DURING PRODUCTION PHASE
(SEALS NOT REQUIRED UNLESS NOTED)
5. SY-SEALED CLOSED WALVES DURING PRODUCTION PHASE
(WALVES OPEN DURING TRUCK HAULING)
6. NC-NORMALLY CLOSED WALVE

SITE SECURITY PLAN LOCATED AT CHEVRON U.S.A. PRODUCTION CO. HCR 60 BOX 423 LOYINGTON, NM 88260

	TEVEROVS					ChaveanTavasa		
	MIR		×	9	3	L Contexaco		
•	8/11/04	AS BUILT	760			ChevronTexaco Permian Business Unit		
1	1/21/04	REVENORS AS PER RESIDE MARKUPS	*	Г		HIICARLSBAD		
Г				Г		INDIAN BASIN FEDERAL 33 COM #3		
Г				П		H33F33-3GU		
г						SECTION 33 , T215 , R23E ; 1880 FSL , 1980 FWL , UNIT ! PROCESS FLOW DIAGRAM		
Н	-					EDDY COUNTY NEW MEDICS.		
⊢	+		_	Н		SHORESHIP SHE DATE DATE DATE NONE		
⊢	-		-	Η.	Н	OPERATIONS: DRAWN: ON SY! SHEET OF		
H			-	┢	Н	NMCH33F33-3GU0001 NMC-H33F33-3GU-00-01		



Bureau of Land Management Roswell Field Office

2909 West Second Street Roswell, New Mexico 88201 505-627-0272

Guidelines for Approval of Water Disposal Methods

The following information must be included with any application for approval of your method of water disposal:

- 1) A formal request (Sundry Notice Form 3160-5 or letter) for approval to dispose of water.
- 2) Name(s) of formation(s) producing water on the lease.
- 3) Amount of water produced from each formation in barrels per day.
- 4) How water is stored on the lease.
- 5) How water is moved to the disposal facility.
- 6) Operator's name; lease name or well name and number of disposal well; location by ¼ ¼, Section, Township, and Range of the disposal system.
- 7) The appropriate NMOCD permit number.

The following information is needed for pit approvals:

- 1) The pit size and location.
- 2) Evaporation rate of the area compensated for annual rainfall.
- 3) Estimated percolation rate based on the soil characteristics under and adjacent to the pit.
- 4) Depth and areal extent of all useable water aquifers in the area (i.e., less than 10,000 ppm total dissolved solids).
- A water analysis of produced water from each zone showing at least the total dissolved solids, ph, and the concentrations of chlorides and sulfates.

guide.waterdisposal.doc