

UNITED STATES  
DEPARTMENT OF THE INTERIOR  
BUREAU OF LAND MANAGEMENT

OCD Artesia

FORM APPROVED  
OMB NO. 1004-0135  
Expires: July 31, 2010**SUNDRY NOTICES AND REPORTS ON WELLS***Do not use this form for proposals to drill or to re-enter an abandoned well. Use form 3160-3 (APD) for such proposals.*5. Lease Serial No.  
NMNM100558

6. If Indian, Allottee or Tribe Name

7. If Unit or CA/Agreement, Name and/or No.

8. Well Name and No.  
RDX FEDERAL 10 79. API Well No.  
30-015-4157710. Field and Pool, or Exploratory  
BRUSHY DRAW DELAWARE E11. County or Parish, and State  
EDDY COUNTY, NM**SUBMIT IN TRIPLICATE - Other instructions on reverse side.**

## 1. Type of Well

☒ Oil Well ☐ Gas Well ☐ Other2. Name of Operator  
RKI EXP & PROD, LLCContact: JESSICA M DEMARCE  
E-Mail: jessica.demarce@wpenergy.com3a. Address  
3500 ONE WILLIAMS CENTER MD35  
TULSA, OK 741723b. Phone No. (include area code)  
Ph: 539-573-35214. Location of Well (Footage, Sec., T., R., M., or Survey Description)  
Sec 10 T26S R30E 990FSL 990FEL**12. CHECK APPROPRIATE BOX(ES) TO INDICATE NATURE OF NOTICE, REPORT, OR OTHER DATA**

TYPE OF SUBMISSION	TYPE OF ACTION			
<input type="checkbox"/> Notice of Intent	<input type="checkbox"/> Acidize	<input type="checkbox"/> Deepen	<input type="checkbox"/> Production (Start/Resume)	<input type="checkbox"/> Water Shut-Off
<input checked="" type="checkbox"/> Subsequent Report	<input type="checkbox"/> Alter Casing	<input type="checkbox"/> Fracture Treat	<input type="checkbox"/> Reclamation	<input type="checkbox"/> Well Integrity
<input type="checkbox"/> Final Abandonment Notice	<input type="checkbox"/> Casing Repair	<input type="checkbox"/> New Construction	<input type="checkbox"/> Recomplete	<input checked="" type="checkbox"/> Other
	<input type="checkbox"/> Change Plans	<input type="checkbox"/> Plug and Abandon	<input type="checkbox"/> Temporarily Abandon	Site Facility Diagram/Security Plan
	<input type="checkbox"/> Convert to Injection	<input type="checkbox"/> Plug Back	<input type="checkbox"/> Water Disposal	

13. Describe Proposed or Completed Operation (clearly state all pertinent details, including estimated starting date of any proposed work and approximate duration thereof. If the proposal is to deepen directionally or recompleat horizontally, give subsurface locations and measured and true vertical depths of all pertinent markers and zones. Attach the Bond under which the work will be performed or provide the Bond No. on file with BLM/BIA. Required subsequent reports shall be filed within 30 days following completion of the involved operations. If the operation results in a multiple completion or recompleat in a new interval, a Form 3160-4 shall be filed once testing has been completed. Final Abandonment Notices shall be filed only after all requirements, including reclamation, have been completed, and the operator has determined that the site is ready for final inspection.)

SFD DATED 6/15/2016 ABSM DATED 6/15/2016 ATTACHED

**NM OIL CONSERVATION**  
ARTESIA DISTRICT

NOV 14 2016

RECEIVED

Accepted for Record Purposes.

Approval Subject to Onsite Inspection.

Date: 09.28.16

14. I hereby certify that the foregoing is true and correct.

Electronic Submission #348355 verified by the BLM Well Information System  
For RKI EXP & PROD, LLC, sent to the Carlsbad  
Committed to AFMSS for processing by DEBORAH MCKINNEY on 08/24/2016 ()

Name (Printed/Typed) JESSICA M DEMARCE

Title REGULATORY TECH

Signature (Electronic Submission)

Date 08/18/2016

**THIS SPACE FOR FEDERAL OR STATE OFFICE USE**

Approved By

Title


Date

Conditions of approval, if any, are attached. Approval of this notice does not warrant or certify that the applicant holds legal or equitable title to those rights in the subject lease which would entitle the applicant to conduct operations thereon.

Office

Title 18 U.S.C. Section 1001 and Title 43 U.S.C. Section 1212, make it a crime for any person knowingly and willfully to make to any department or agency of the United States any false, fictitious or fraudulent statements or representations as to any matter within its jurisdiction.


**\*\* OPERATOR-SUBMITTED \*\* OPERATOR-SUBMITTED \*\* OPERATOR-SUBMITTED \*\***

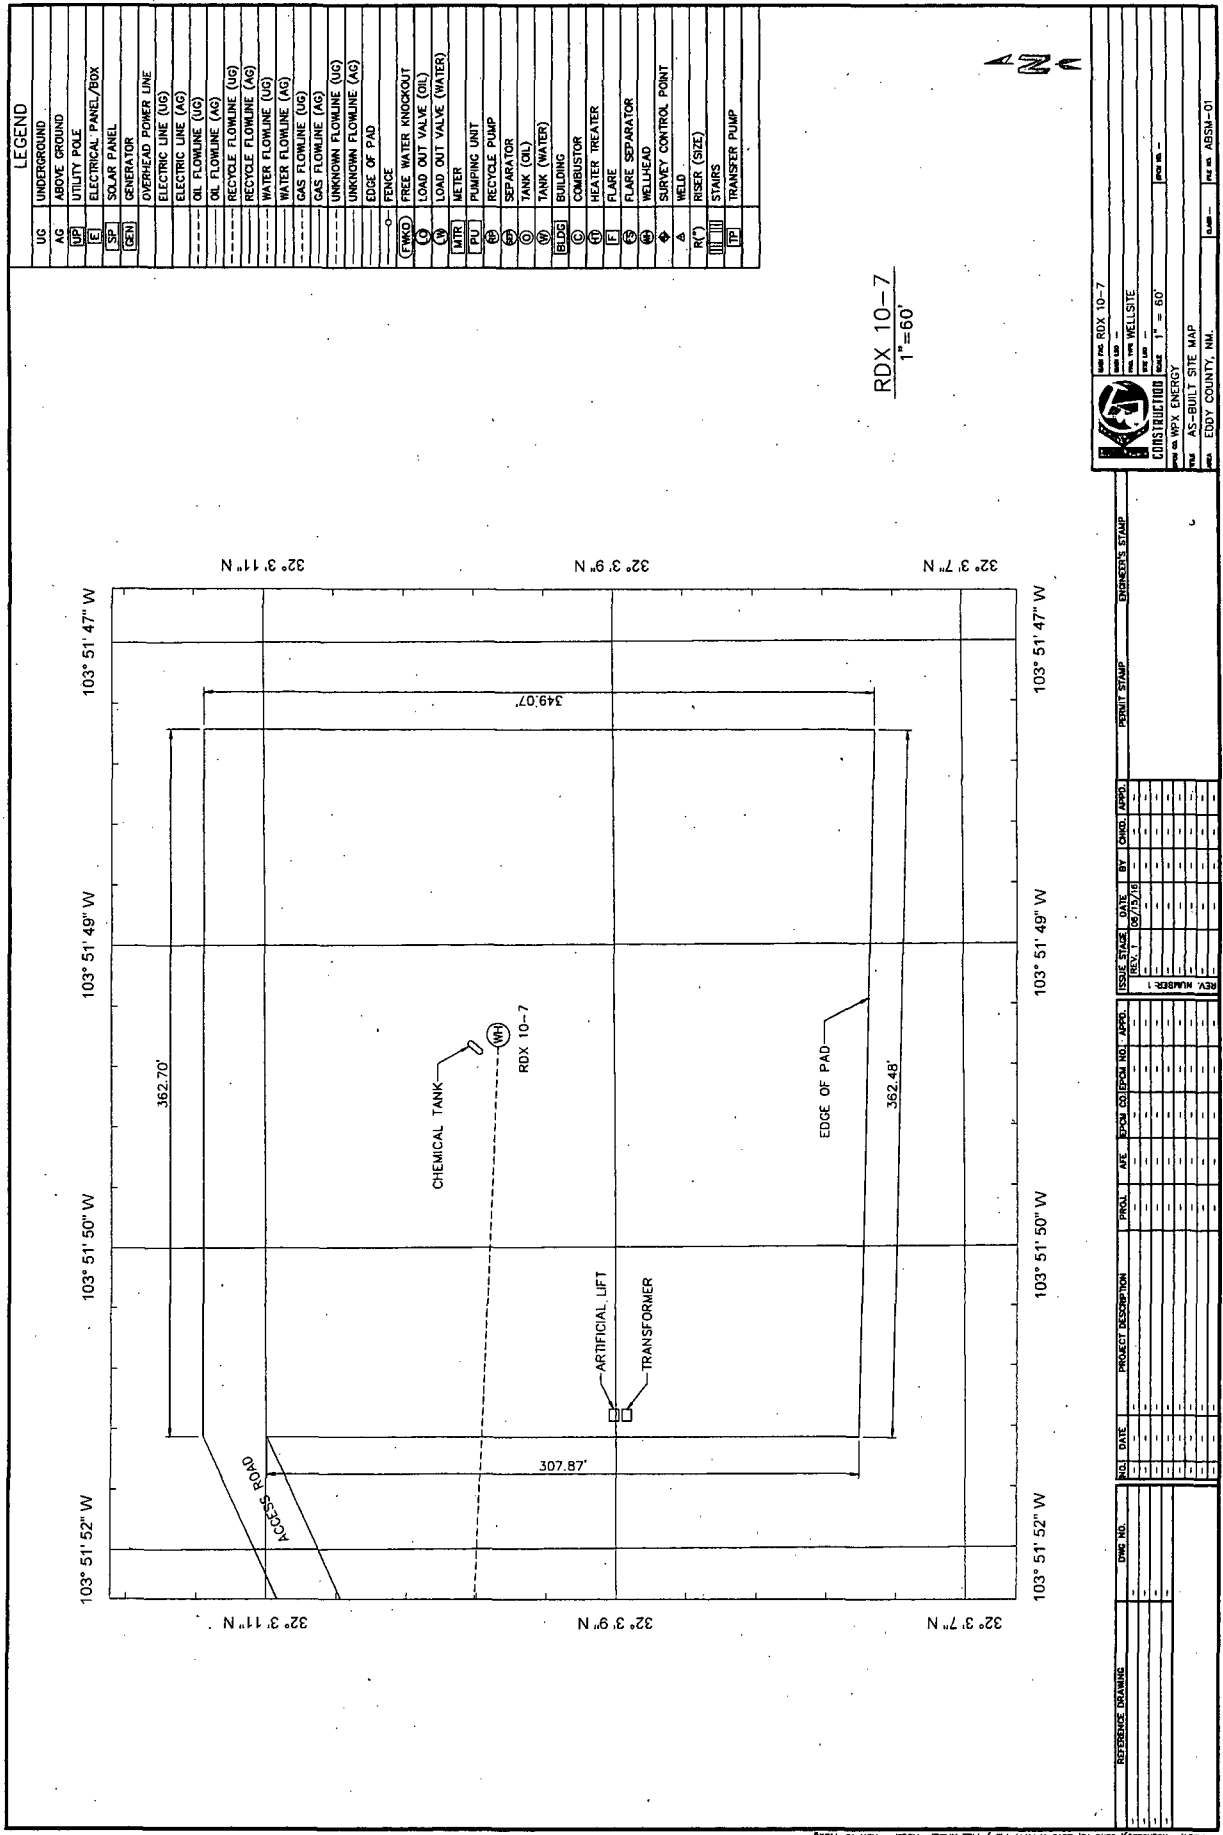

**LEGEND**

UG	UNDERGROUND
AG	ABOVE GROUND
UP	UTILITY POLE
E	ELECTRICAL PANEL/BOX
SP	SOLAR PANEL
GEN	GENERATOR
	OVERHEAD POWER LINE
	ELECTRIC LINE (UG)
	ELECTRIC LINE (AG)
	OIL FLOWLINE (UG)
	OIL FLOWLINE (AG)
	RECYCLE FLOWLINE (UG)
	RECYCLE FLOWLINE (AG)
	WATER FLOWLINE (UG)
	WATER FLOWLINE (AG)
	GAS FLOWLINE (UG)
	GAS FLOWLINE (AG)
	UNKNOWN FLOWLINE (UG)
	UNKNOWN FLOWLINE (AG)
	EDGE OF PAD
	FENCE
(FWO)	FREE WATER KNOCKOUT
(LOV)	LOAD OUT VALVE (OIL)
(LOV)	LOAD OUT VALVE (WATER)
MTR	METER
PU	PUMPING UNIT
RP	RECYCLE PUMP
SEP	SEPARATOR
TANK (OIL)	TANK (OIL)
TANK (WATER)	TANK (WATER)
BUILDING	BUILDING
COMBUSTOR	COMBUSTOR
HEATER TREATER	HEATER TREATER
FLARE	FLARE
FLARE SEPARATOR	FLARE SEPARATOR
WELHEAD	WELHEAD
SURVEY CONTROL POINT	SURVEY CONTROL POINT
WELD	WELD
RISER (SIZE)	RISER (SIZE)
STAIRS	STAIRS
TRANSFER PUMP	TRANSFER PUMP

RDX 10-7  
1"=60'

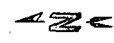

		RDX 10-7 1"=60'	
PROJECT DESCRIPTION RDX 10-7		DATE 08/28/16	
DRAWING NO. RDX 10-7		BY J. M. B.	
PROJECT LOCATION EDDY COUNTY, NM.		SCALE 1" = 60'	
PROJECT OWNER AS-BUILT SITE MAP		PROJECT NUMBER 1	
PROJECT ENGINEER J. M. B.		PROJECT STAMP ENGINEER'S STAMP	

Accepted for Record Purposes.  
 Approval Subject to Onsite Inspection.  
 Date: 09.28.16

