

UNITED STATES
DEPARTMENT OF THE INTERIOR
BUREAU OF LAND MANAGEMENT
OCD Artesia

FORM APPROVED
OMB NO. 1004-0135
Expires: July 31, 2010

SUNDRY NOTICES AND REPORTS ON WELLS
Do not use this form for proposals to drill or to re-enter an abandoned well. Use form 3160-3 (APD) for such proposals.

5. Lease Serial No.
NMNM54290

6. If Indian, Allottee or Tribe Name

SUBMIT IN TRIPLICATE - Other instructions on reverse side.

7. If Unit or CA/Agreement, Name and/or No.

8. Well Name and No.
NORTH BRUSHY DRAW FEDERAL 35 6H

9. API Well No.
30-015-42293

10. Field and Pool, or Exploratory
CORRAL CANYON BONE SPR S

11. County or Parish, and State
EDDY COUNTY, NM

1. Type of Well
 Oil Well Gas Well Other

2. Name of Operator
RKI EXP & PROD, LLC
Contact: JESSICA M DEMARCE
E-Mail: jessica.demarce@wpenergy.com

3a. Address
3500 ONE WILLIAMS CENTER MD35
TULSA, OK 74172
3b. Phone No. (include area code)
Ph: 539-573-3521

4. Location of Well (Footage, Sec., T., R., M., or Survey Description)
Sec 35 T25S R29E 175FNL 2290FEL

12. CHECK APPROPRIATE BOX(ES) TO INDICATE NATURE OF NOTICE, REPORT, OR OTHER DATA

TYPE OF SUBMISSION	TYPE OF ACTION			
<input type="checkbox"/> Notice of Intent	<input type="checkbox"/> Acidize	<input type="checkbox"/> Deepen	<input type="checkbox"/> Production (Start/Resume)	<input type="checkbox"/> Water Shut-Off
<input checked="" type="checkbox"/> Subsequent Report	<input type="checkbox"/> Alter Casing	<input type="checkbox"/> Fracture Treat	<input type="checkbox"/> Reclamation	<input type="checkbox"/> Well Integrity
<input type="checkbox"/> Final Abandonment Notice	<input type="checkbox"/> Casing Repair	<input type="checkbox"/> New Construction	<input type="checkbox"/> Recomplete	<input checked="" type="checkbox"/> Other
	<input type="checkbox"/> Change Plans	<input type="checkbox"/> Plug and Abandon	<input type="checkbox"/> Temporarily Abandon	Site Facility Diagram/Security Plan
	<input type="checkbox"/> Convert to Injection	<input type="checkbox"/> Plug Back	<input type="checkbox"/> Water Disposal	

13. Describe Proposed or Completed Operation (clearly state all pertinent details, including estimated starting date of any proposed work and approximate duration thereof. If the proposal is to deepen directionally or recomplete horizontally, give subsurface locations and measured and true vertical depths of all pertinent markers and zones. Attach the Bond under which the work will be performed or provide the Bond No. on file with BLM/BIA. Required subsequent reports shall be filed within 30 days following completion of the involved operations. If the operation results in a multiple completion or recompletion in a new interval, a Form 3160-4 shall be filed once testing has been completed. Final Abandonment Notices shall be filed only after all requirements, including reclamation, have been completed, and the operator has determined that the site is ready for final inspection.)

SFD DATED 7/5/2016 & ABSM DATED 7/5/2016 ATTACHED

NM OIL CONSERVATION
ARTESIA DISTRICT

NOV 14 2016

to

RECEIVED

Accepted for Record Purpose
Approval Subject to Onsite Inspection.
Date: 09-28-14

14. I hereby certify that the foregoing is true and correct.

Electronic Submission #348300 verified by the BLM Well Information System
For RKI EXP & PROD, LLC, sent to the Carlsbad
Committed to AFMSS for processing by DEBORAH MCKINNEY on 08/24/2016 ()

Name (Printed/Typed) JESSICA M DEMARCE Title REGULATORY TECH

Signature (Electronic Submission) Date 08/18/2016

THIS SPACE FOR FEDERAL OR STATE OFFICE USE

Approved By _____ Title _____ Date _____

Conditions of approval, if any, are attached. Approval of this notice does not warrant or certify that the applicant holds legal or equitable title to those rights in the subject lease which would entitle the applicant to conduct operations thereon.


Office _____

Title 18 U.S.C. Section 1001 and Title 43 U.S.C. Section 1212, make it a crime for any person knowingly and willfully to make to any department or agency of the United States any false, fictitious or fraudulent statements or representations as to any matter within its jurisdiction.

**** OPERATOR-SUBMITTED ** OPERATOR-SUBMITTED ** OPERATOR-SUBMITTED ****

LEGEND	
UG	UNDERGROUND
AG	ABOVE GROUND
UPI	UTILITY POLE
E	ELECTRICAL PANEL/BOX
SP	SOLAR PANEL
GEN	GENERATOR
	OVERHEAD POWER LINE
	ELECTRIC LINE (UG)
	ELECTRIC LINE (AG)
	OIL FLOWLINE (UG)
	OIL FLOWLINE (AG)
	RECYCLE FLOWLINE (UG)
	RECYCLE FLOWLINE (AG)
	WATER FLOWLINE (UG)
	WATER FLOWLINE (AG)
	GAS FLOWLINE (UG)
	GAS FLOWLINE (AG)
	UNKNOWN FLOWLINE (UG)
	UNKNOWN FLOWLINE (AG)
	EDGE OF PAD
	FENCE
	FREE WATER WINDKOUT
	LOAD OUT VALVE (OIL)
	LOAD OUT VALVE (WATER)
	LOAD OUT VALVE (RECYCLE)
	METER
	PUMPING UNIT
	RECYCLE PUMP
	SEPARATOR
	TANK (OIL)
	TANK (WATER)
	BUILDING
	COMBUSTOR
	HEATER TREATER
	FLARE
	FLARE SEPARATOR
	WELHEAD
	SURVEY CONTROL POINT
	GAS LIFT SKID
	COMPRESSOR
	STAIRS
	TRANSFER PUMP

NORTH BRUSHY DRAW 35-6H
1"=60'

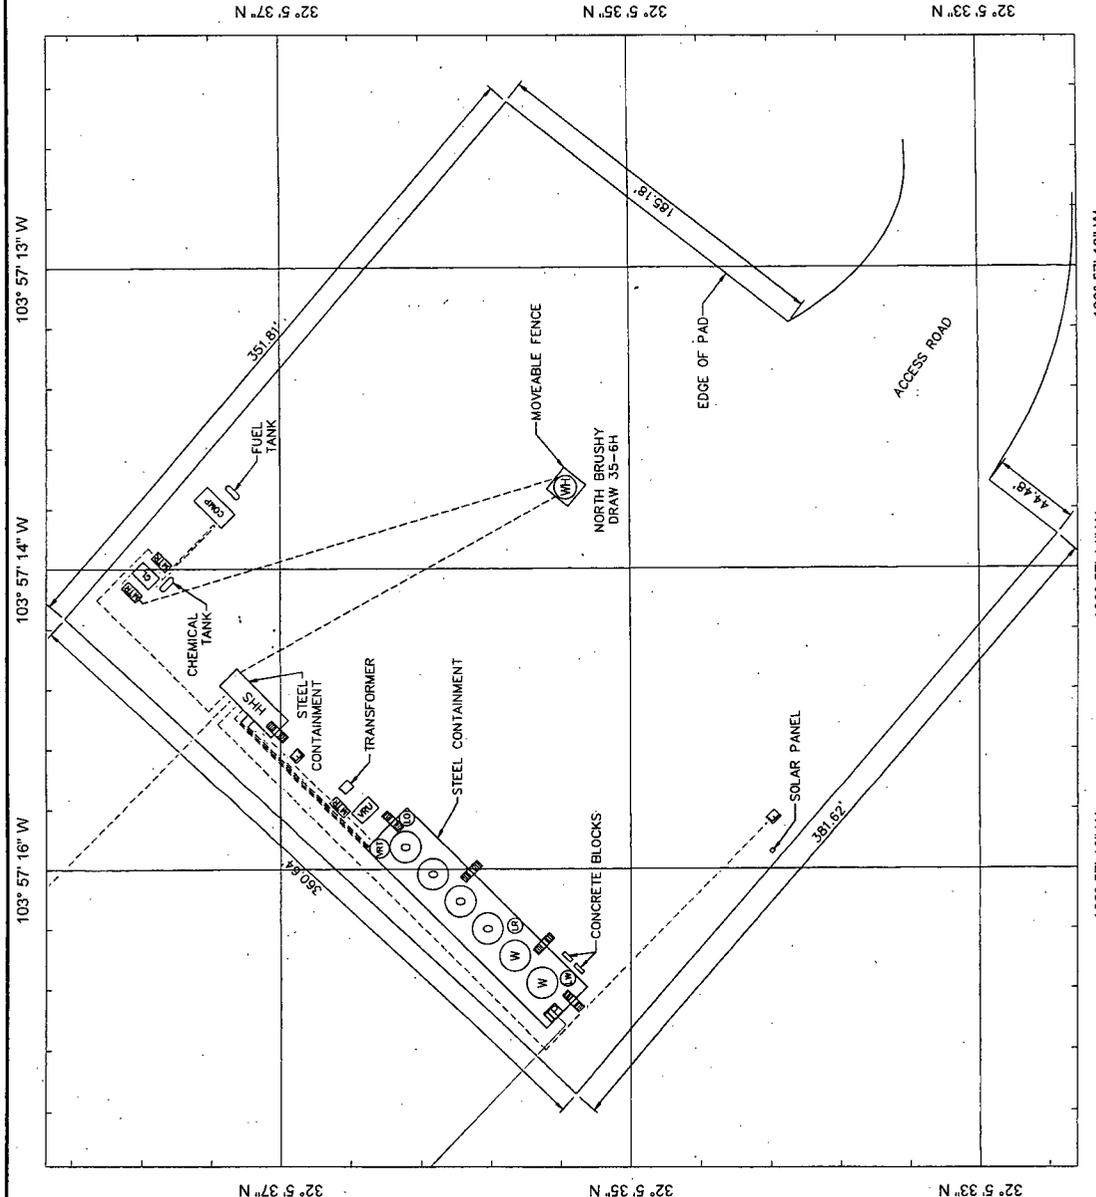

CONSTRUCTIVE
AS-BUILT SITE MAP
EDDY COUNTY, NM.

PROJECT: NORTH BRUSHY DRAW 35-6H
DATE: 07/20/16
SCALE: 1" = 60'

NO.	DATE	PROJECT DESCRIPTION	PROJ. NO.	ISSUE NUMBER	DATE OF ISSUE	BY	REV. NO.	DATE OF REV.
1				1	07/20/16		1	

NO.	DATE	PROJECT DESCRIPTION	PROJ. NO.	ISSUE NUMBER	DATE OF ISSUE	BY	REV. NO.	DATE OF REV.
1				1	07/20/16		1	

Accepted for Record Purpose.
Approval Subject to Onsite Inspection.
Date: 09.28.16


WPX ENERGY
 NORTH BRUSHY DRAW FEDERAL 35-6H
 LEASE# 044290
 1751 PNL & 2290 FEL
 UNIT B, SEC. 35-7255-R29E
 AP# 30-015-42293
 EDDY COUNTY, NEW MEXICO

General sealing of valves, adsea by tank gauge.
 Production Phase: Sales valves S1 through S4 sealed closed. Fill valve to tank that is in production will be open. Equalizer valve to tank that is in production will be open. Circulating valves will be opened as necessary, then released.
 Sales Phase: The tank from which adsea are being made will be isolated by sealing the fill valve, circulating valve and the equalizer valve during sales and opening the adsea valve. Upon completion of the sale the adsea valve will be released. Sales by truck will be by tank gauge.

Value	Production Phase	Sales Phase	Circulating
S1	Closed	Open	Closed
S2	Closed	Open	Closed
S3	Closed	Open	Closed
S4	Closed	Open	Closed
C1	Closed or Open	Closed	Closed
C2	Closed or Open	Closed	Closed
C3	Closed or Open	Closed	Closed
C4	Closed or Open	Closed	Closed
F1	Open or Closed	Closed	Closed or Open
F2	Open or Closed	Closed	Closed or Open
F3	Open or Closed	Closed	Closed or Open
F4	Open or Closed	Closed	Closed or Open
E1	Open	Closed	Closed
E2	Open	Closed	Closed
E3	Open	Closed	Closed
E4	Open	Closed	Closed

The Site Security Plan is kept at WPX's office located at:
 5315 Buena Vista Dr. Carlsbad, NM.

NORTH BRUSHY DRAW 35-6H
 N.T.S.

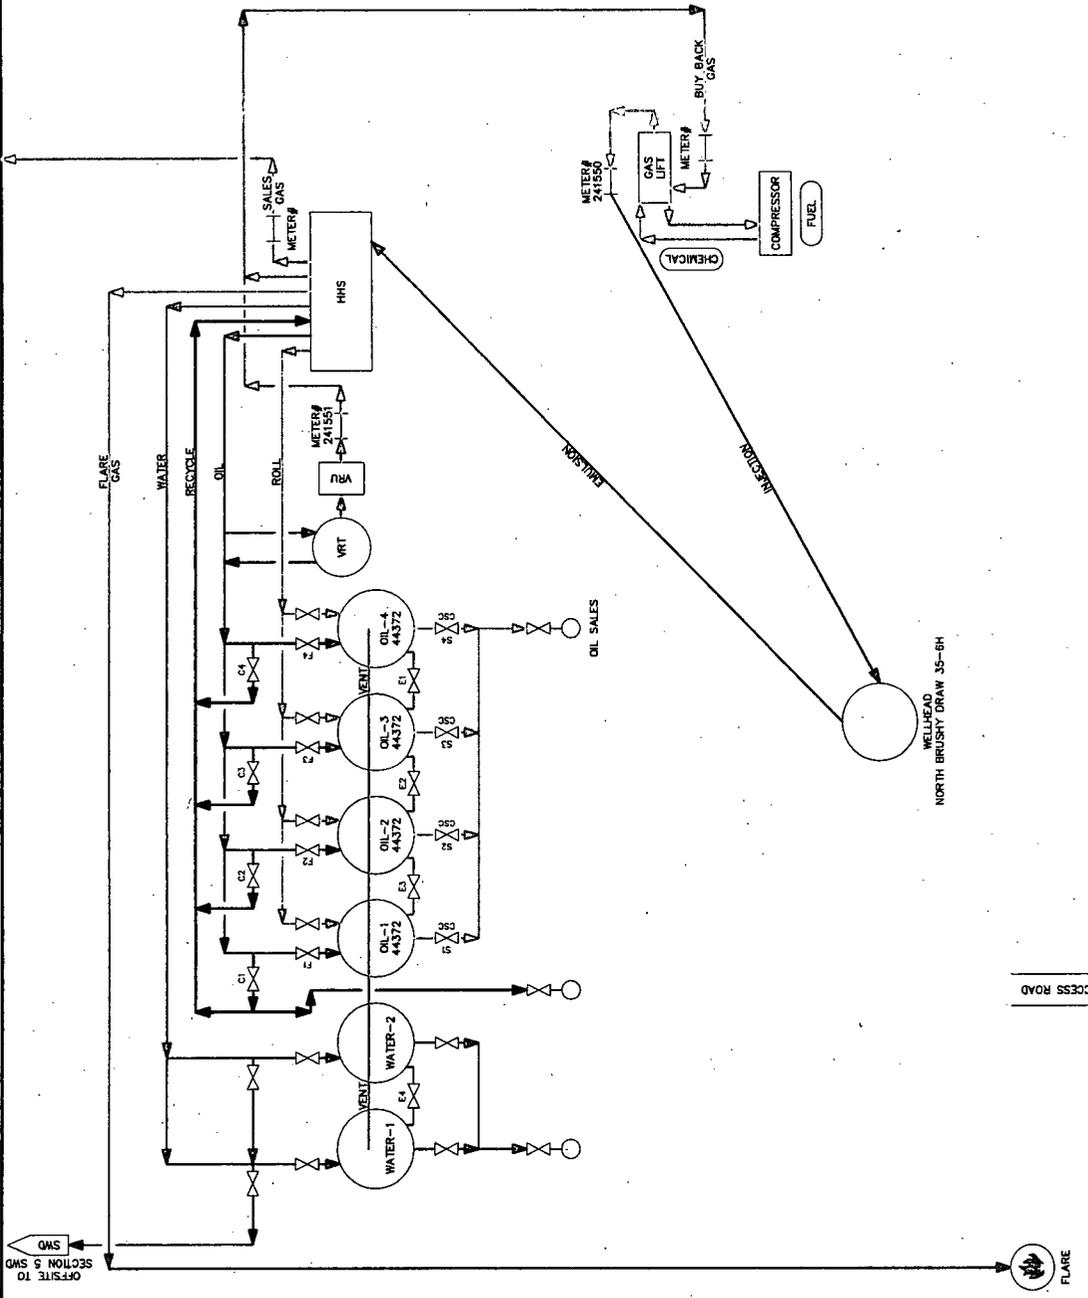

NO.	DATE	PROJECT DESCRIPTION	PROJ. OF.	ISSUE NO.	DATE	BY	CHKD.	ISSUE
1								
2								
3								
4								
5								
6								
7								
8								
9								
10								

Accepted for Record Purposes
 Approved Subject to Onsite Inspection.
 Date: 09-28-14

CONSTRUCTION
 SITE FACILITY DIAGRAM
 NORTH BRUSHY DRAW 35-6H
 EDDY COUNTY, NEW MEXICO