

UNITED STATES
DEPARTMENT OF THE INTERIOR
BUREAU OF LAND MANAGEMENT

FORM APPROVED
OMB NO. 1004-0135
Expires: July 31, 2010

SUNDRY NOTICES AND REPORTS ON WELLS
Do not use this form for proposals to drill or to re-enter an abandoned well. Use form 3160-3 (APD) for such proposals.

BURNETT OIL CONSERVATION DISTRICT
ARTESIA DISTRICT
MAR 27 2017

5. Lease Serial No.
NMNM2748

6. If Indian, Allottee or Tribe Name

SUBMIT IN TRIPLICATE - Other instructions on reverse side.

RECEIVED

7. If Unit or CA/Agreement, Name and/or No.

1. Type of Well <input checked="" type="checkbox"/> Oil Well <input type="checkbox"/> Gas Well <input type="checkbox"/> Other		8. Well Name and No. GISSLER B 87
2. Name of Operator BURNETT OIL COMPANY INC		9. API Well No. 30-015-40697-00-S1
3a. Address 801 CHERRY STREET UNIT 9 FORT WORTH, TX 76102-6881		10. Field and Pool, or Exploratory LOCO HILLS-QU-GB-SA
3b. Phone No. (include area code) Ph: 817-583-8730		11. County or Parish, and State EDDY COUNTY, NM
4. Location of Well (Footage, Sec., T., R., M., or Survey Description) Sec 11 T17S R30E NENW 419FNL 1507FWL		

12. CHECK APPROPRIATE BOX(ES) TO INDICATE NATURE OF NOTICE, REPORT, OR OTHER DATA

TYPE OF SUBMISSION	TYPE OF ACTION			
<input type="checkbox"/> Notice of Intent	<input type="checkbox"/> Acidize	<input type="checkbox"/> Deepen	<input type="checkbox"/> Production (Start/Resume)	<input type="checkbox"/> Water Shut-Off
<input checked="" type="checkbox"/> Subsequent Report	<input type="checkbox"/> Alter Casing	<input type="checkbox"/> Fracture Treat	<input type="checkbox"/> Reclamation	<input type="checkbox"/> Well Integrity
<input type="checkbox"/> Final Abandonment Notice	<input type="checkbox"/> Casing Repair	<input type="checkbox"/> New Construction	<input type="checkbox"/> Recomplete	<input checked="" type="checkbox"/> Other Change to Original A PD
	<input type="checkbox"/> Change Plans	<input type="checkbox"/> Plug and Abandon	<input type="checkbox"/> Temporarily Abandon	
	<input type="checkbox"/> Convert to Injection	<input type="checkbox"/> Plug Back	<input type="checkbox"/> Water Disposal	

13. Describe Proposed or Completed Operation (clearly state all pertinent details, including estimated starting date of any proposed work and approximate duration thereof. If the proposal is to deepen directionally or recomplete horizontally, give subsurface locations and measured and true vertical depths of all pertinent markers and zones. Attach the Bond under which the work will be performed or provide the Bond No. on file with BLM/BIA. Required subsequent reports shall be filed within 30 days following completion of the involved operations. If the operation results in a multiple completion or recompletion in a new interval, a Form 3160-4 shall be filed once testing has been completed. Final Abandonment Notices shall be filed only after all requirements, including reclamation, have been completed, and the operator has determined that the site is ready for final inspection.)

Burnett is requesting a variance to the original APD Interim Reclamation Plat. The actual interim reclamation was completed but varies from the original specifications in the APD. I have attached a copy of the as built reclamation plat. We reclaimed approximately 70' more than the original design called for.

See attached as built interim reclamation plat.

14. I hereby certify that the foregoing is true and correct.

**Electronic Submission #346893 verified by the BLM Well Information System
For BURNETT OIL COMPANY INC, sent to the Carlsbad
Committed to AFMSS for processing by PRISCILLA PEREZ on 08/12/2016 (16PP2024SE)**

Name (Printed/Typed) LESLIE GARVIS	Title REGULATORY COORDINATOR
Signature (Electronic Submission)	Date 08/04/2016

THIS SPACE FOR FEDERAL OR STATE OFFICE USE


Approved By	Title SAET	3-20-17 Date
Conditions of approval, if any, are attached. Approval of this notice does not warrant or certify that the applicant holds legal or equitable title to those rights in the subject lease which would entitle the applicant to conduct operations thereon.	Office CFO	

Title 18 U.S.C. Section 1001 and Title 43 U.S.C. Section 1212, make it a crime for any person knowingly and willfully to make to any department or agency of the United States any false, fictitious or fraudulent statements or representations as to any matter within its jurisdiction.

BURNETT OIL CO., INC.
AS BUILT INTERIM RECLAMATION

GISSLER B 87

NORTH

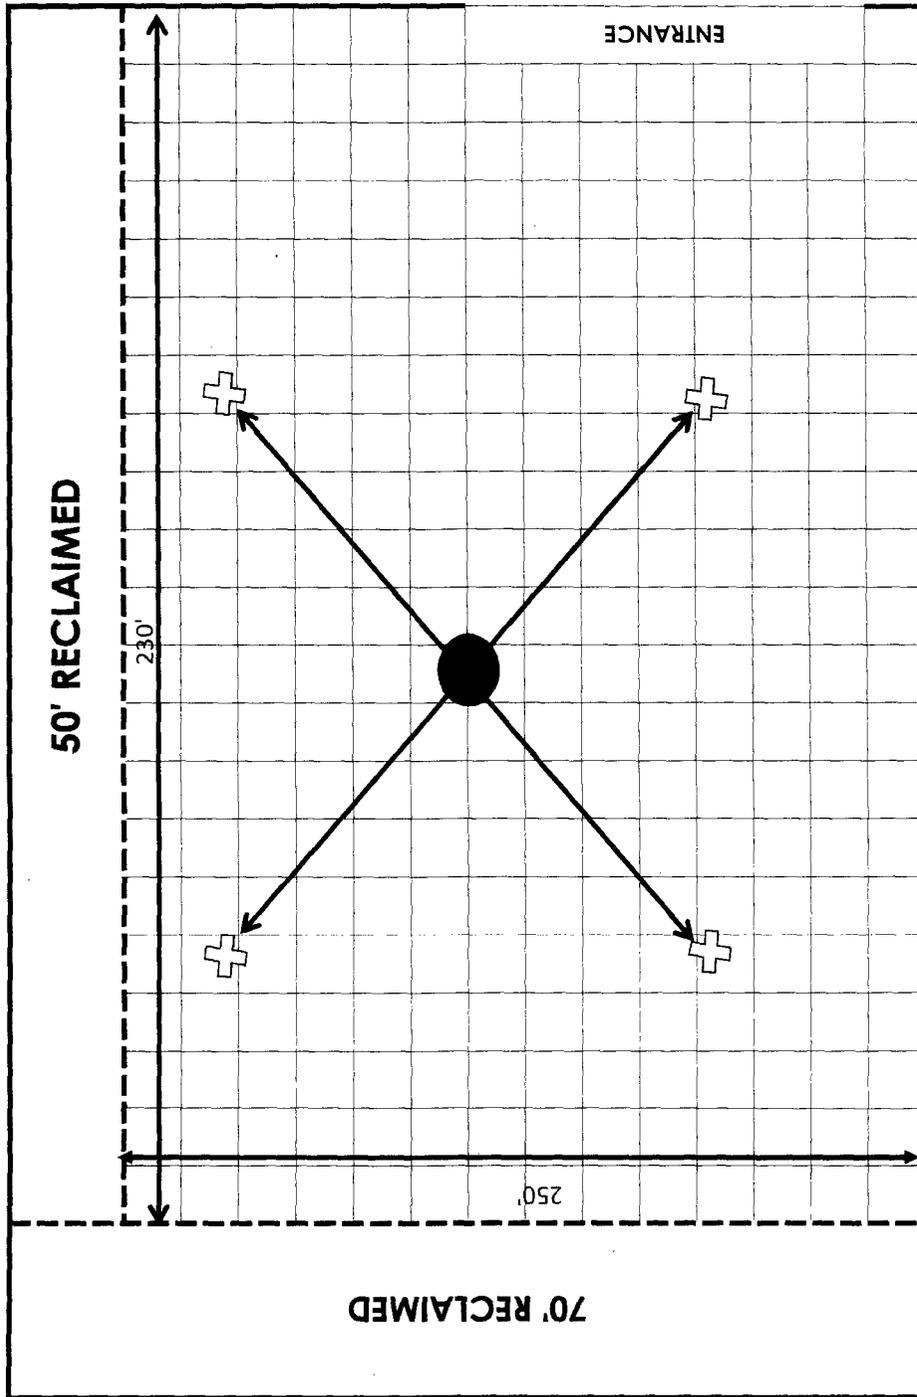

ANCHOR

75' FROM WELLHEAD TO ANCHORS

WELLHEAD

NOT TO SCALE