

Submit 3 Copies To Appropriate District Office
District I
1625 N French Dr, Hobbs, NM 88240
District II
1301 W Grand Ave, Artesia, NM 88210
District III
1000 Rio Brazos Rd, Aztec, NM 87410
District IV
1220 S St Francis Dr., Santa Fe, NM 87505

State of New Mexico
Energy, Minerals and Natural Resources

OIL CONSERVATION DIVISION
1220 South St. Francis Dr.
Santa Fe, NM 87505

Form C-103
May 27, 2004

WELL API NO.
30-015-30189

5. Indicate Type of Lease
STATE ☒ FEE ☐

6. State Oil & Gas Lease No.

7. Lease Name or Unit Agreement Name

Washington "33" State

8. Well Number 007

9. OGRID Number
00778

10. Pool name or Wildcat
Artesia, Queen-Grayburg-San Andres

SUNDRY NOTICES AND REPORTS ON WELLS
(DO NOT USE THIS FORM FOR PROPOSALS TO DRILL OR TO DEEPEN OR PLUG BACK TO A DIFFERENT RESERVOIR USE "APPLICATION FOR PERMIT" (FORM C-101) FOR SUCH PROPOSALS.)

1. Type of Well: Oil Well ☒ Gas Well ☐ Other

2. Name of Operator
BP America Production Company

3. Address of Operator
P. O. Box 1610 Midland, TX 79701

4. Well Location

Unit Letter E : 1650 feet from the North line and 970 feet from the West line
Section 33 Township 17S Range 28E NMPM County Eddy

11. Elevation (Show whether DR, RKB, RT, GR, etc.)
GR 3663'

Pit or Below-grade Tank Application ☐ or Closure ☐

Pit type Depth to Groundwater Distance from nearest fresh water well Distance from nearest surface water

Pit Liner Thickness: mil Below-Grade Tank: Volume bbls; Construction Material

12. Check Appropriate Box to Indicate Nature of Notice, Report or Other Data

NOTICE OF INTENTION TO:

PERFORM REMEDIAL WORK ☐ PLUG AND ABANDON ☐
TEMPORARILY ABANDON ☐ CHANGE PLANS ☐
PULL OR ALTER CASING ☐ MULTIPLE COMPL ☐

OTHER: ☐

SUBSEQUENT REPORT OF:

REMEDIAL WORK ☐ ALTERING CASING ☐
COMMENCE DRILLING OPNS. ☐ P AND A ☐
CASING/CEMENT JOB ☐

OTHER: Add perms, acidize and frac ☒

13. Describe proposed or completed operations. (Clearly state all pertinent details, and give pertinent dates, including estimated date of starting any proposed work). SEE RULE 1103. For Multiple Completions: Attach wellbore diagram of proposed completion or recompletion.

Start date 12/17/2007. Completion date 1/3/2008.

12/17/07 MIRU PU.
12/18/07 Pull rods and pump. Install BOP. POH with tubing.
12/19/07 RU wireline unit. Perforate Queen-Grayburg-San Andres 1394-2030' w/ 34 holes. RD WL. TIH w/ straddle packer.
12/20/07 Acidized Queen-Grayburg-San Andres 1394-2030' w/ 1050 gallons 10% acetic.
12/21/07 TOH with straddle packer. TIH with treating packer.
12/26/07 Treated Lower San Andres perms 2283-2722' with 50 bbl toluene foll'd by 2500 gallons 15% NEFE HCL.
12/27-28/07 TOH with treating packer. Run production tubing. Remove BOP.
1/2-3/08 Run pump and rods. RDPU.

I hereby certify that the information above is true and complete to the best of my knowledge and belief. I further certify that any pit or below-grade tank has been/will be constructed or closed according to NMOCD guidelines ☐, a general permit ☐ or an (attached) alternative OCD-approved plan ☐.

SIGNATURE W.C. Heard TITLE agent for BP America Production Company DATE 1/4/07

Type or print name W. C. Heard E-mail address: bill.heard@bp.com Telephone No. 432-688-5257
For State Use Only **FOR RECORDS ONLY**

APPROVED BY: _____ TITLE _____ DATE JAN 17 2008

Conditions of Approval (if any):


Washington 33 State #7
Artesia Field

API No. 30-015-30189

1650' FNL & 970' FWL
 Sec 33 - T17S - R28E
 Eddy County, New Mexico

As Installed

Event
 Date

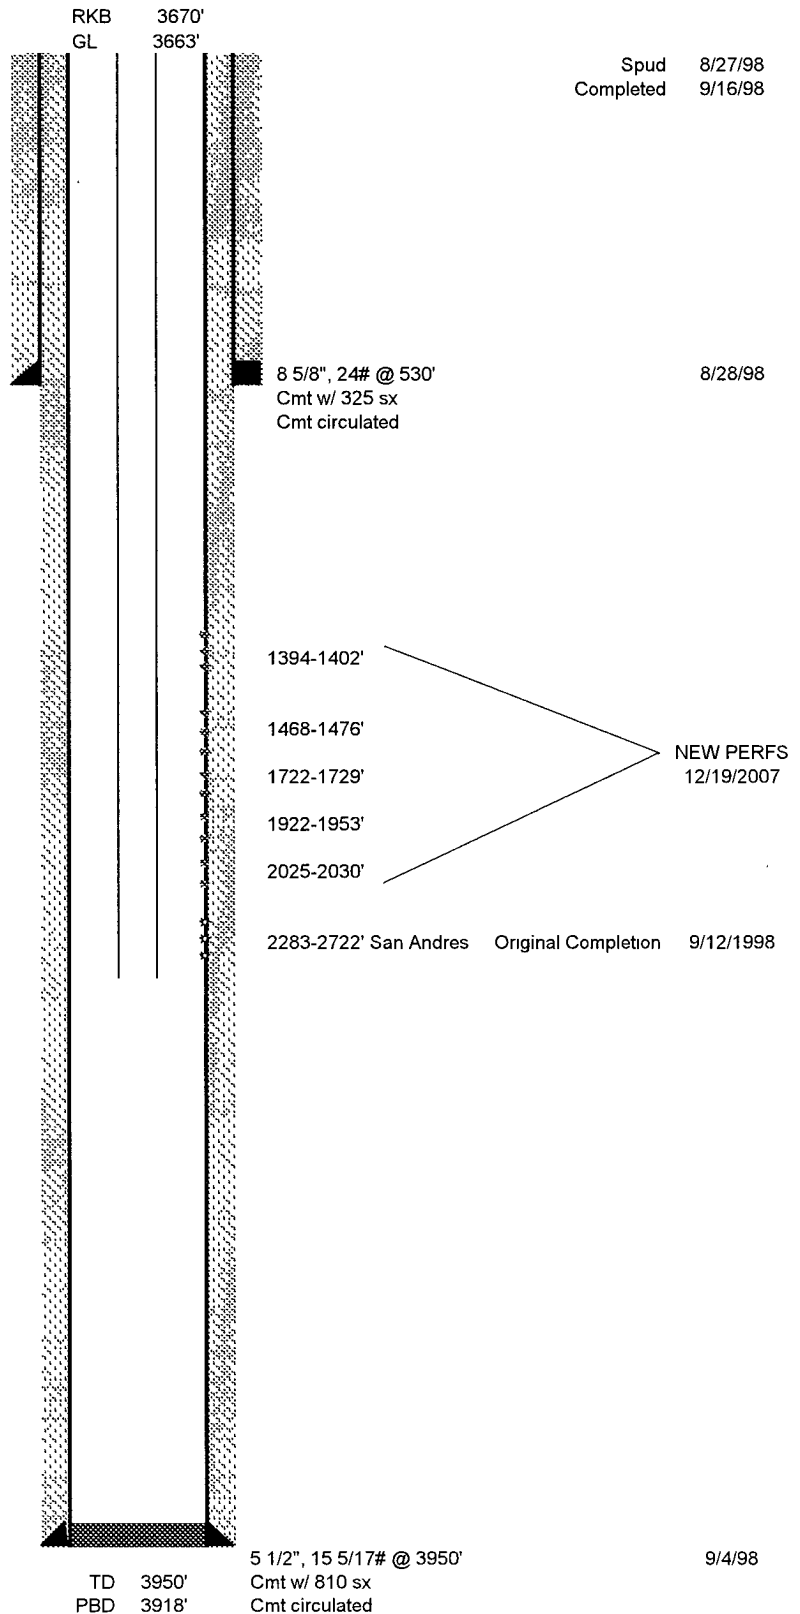

WCH 5/23/2007