


RECEIVED

By JKeys at 8:08 am, Apr 06, 2016


Please provide sidewall samples.

Tom 36 Battery & SWD Station

Scale: 1" = 25'

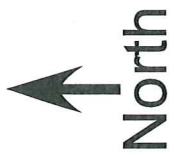

Location
Edge

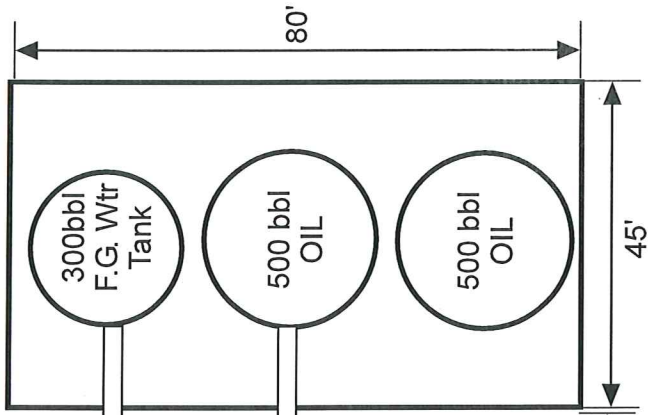

Caliche Road

No Vertical Scaling
Above this Line

Sample Points

Abandoned
Heater
Treater



Remove soil 1' to 2'

Remove soil
4' below ground level.

360'

