

Submit 1 Copy To Appropriate District Office
 District I - (575) 393-6161
 1625 N. French Dr., Hobbs, NM 88240
 District II - (575) 748-1283
 811 S. First St., Artesia, NM 88210
 District III - (505) 334-6178
 1000 Rio Brazos Rd., Aztec, NM 87410
 District IV - (505) 476-3460
 1220 S. St. Francis Dr., Santa Fe, NM 87505

HOBBS OCD
AUG 04 2016
RECEIVED

State of New Mexico
 Energy, Minerals and Natural Resources

Form C-103
 Revised July 18, 2013

OIL CONSERVATION DIVISION
 1220 South St. Francis Dr.
 Santa Fe, NM 87505

WELL API NO. 30-025-02765
5. Indicate Type of Lease STATE <input type="checkbox"/> FEE <input checked="" type="checkbox"/>
6. State Oil & Gas Lease No.
7. Lease Name or Unit Agreement Name HULDA A TOWNSEND
8. Well Number #6
9. OGRID Number 160825
10. Pool name or Wildcat SWD; WOLFCAMP
11. Elevation (Show whether DR, RKB, RT, GR, etc.) 4014 GL

SUNDRY NOTICES AND REPORTS ON WELLS
 (DO NOT USE THIS FORM FOR PROPOSALS TO DRILL OR TO DEEPEN OR PLUG BACK TO A DIFFERENT RESERVOIR. USE "APPLICATION FOR PERMIT" (FORM C-101) FOR SUCH PROPOSALS.)

1. Type of Well: Oil Well Gas Well Other

2. Name of Operator BC OPERATING, INC.

3. Address of Operator P.O. BOX 50820
MIDLAND, TX 79710

4. Well Location
 Unit Letter G : 1980 feet from the NORTH line and 1980 feet from the EAST line
 Section 9 Township 16S Range 35E NMPM LEA County

12. Check Appropriate Box to Indicate Nature of Notice, Report or Other Data

NOTICE OF INTENTION TO: PERFORM REMEDIAL WORK <input type="checkbox"/> PLUG AND ABANDON <input checked="" type="checkbox"/> TEMPORARILY ABANDON <input type="checkbox"/> CHANGE PLANS <input type="checkbox"/> PULL OR ALTER CASING <input type="checkbox"/> MULTIPLE COMPL <input type="checkbox"/> DOWNHOLE COMMINGLE <input type="checkbox"/> CLOSED-LOOP SYSTEM <input type="checkbox"/> OTHER: <input type="checkbox"/>		SUBSEQUENT REMEDIAL WORK [<input type="checkbox"/>] COMMENCE DRILLING OPNS. [<input type="checkbox"/>] CASING/CEMENT JOB [<input type="checkbox"/>] OTHER: <input type="checkbox"/>	
---	--	--	--

INT TO PA Am
 P&A NR _____
 P&A R _____

13. Describe proposed or completed operations. (Clearly state all pertinent details, and give pertinent dates, including estimated date of starting any proposed work). SEE RULE 19.15.7.14 NMAC. For Multiple Completions: Attach wellbore diagram of proposed completion or recompletion.

BC OPERATING, INC. HEREBY PROPOSES TO PLUG AND ABANDON THE SUBJECT WELL.

SEE ATTACHED PROCEDURE

NOTIFY OCD 24 HOURS PRIOR TO BEGINNING PLUGGING OPERATIONS

Spud Date:

Rig Release Date:

I hereby certify that the information above is true and complete to the best of my knowledge and belief.

SIGNATURE Sarah Presley TITLE REGULATORY ANALYST DATE 7.27.2016

Type or print name SARAH PRESLEY E-mail address: spresley@bcooperating.com PHONE: 432-684-9696

For State Use Only

APPROVED BY: Mark Winters TITLE Petroleum Engr. Specialist DATE 8-4-2016

Conditions of Approval (if any):

✓

Hulda A. Townsend #6
API# 30-025-02765
Unit G, Sec. 9-16S-35E
1980' FNL & 1980' FEL
Eddy, NM
BC Operating, Inc.

Plug & Abandonment Procedure

1. Hold tailgate safety meeting and discuss plan, Bruce Madden is to be called for any spills (432) 894-0721.
2. Kill power to location.
3. MIRU pulling unit.
4. If necessary, blow well down to tank battery.
5. Tag plug @ 9530' (~~10# brine gel was circulated in 2011~~). *Circ. Mud laden fluid. Spot 25sx cmt on CIBP. Pressure test CSG.*
6. Spot ²⁵ 50 sk plug @ top of Abo 7950'. *Spot 25sx cmt @ 7500'. WOC & TAG (Perf in 5 1/2 for 2nd stage cmt job)*
7. Spot 50 sk plug @ top of Glorreta @ 6200'.
8. Spot plug @ 9-5/8" ^{25sx} csg shoe ~~50'~~ ⁴⁶⁵⁰ in/out at 4600 (tag plug). *Spot 25sx cmt @ 2950' (B.SALT)*
9. Cut and pull 5.5' csg @ 1920', spot plug @ ~~50'~~ ^{1970'} in/out of csg stub (tag). *TAG @ 1850' or better (T.SALT)*
10. Spot 100' @ ~~434'~~ ^{484'} 50" in/out (tag). *Tag at 384' or better.*
11. Spot 50' surface plug.

BC Operating, Inc.

Current WBD


LEASE:	Hulda A. Townsend
FIELD:	SWD; Wolfcamp
LOCATION:	1980' FNL 1980' FEL
SPUD DATE:	5/3/1954
CONTRACTOR:	unknown

WELL NO.:	6
COUNTY:	Lea
LEGAL:	Sec. 9-16S-35E-M
DRAWN BY:	Jason Goss
DATE:	7/27/2016

API #:	30-025-07265
STATE:	New Mexico
GL:	4014
DF:	
KB:	

Hulda A. Townsend Well No. 6

Hole Size
Csg Design

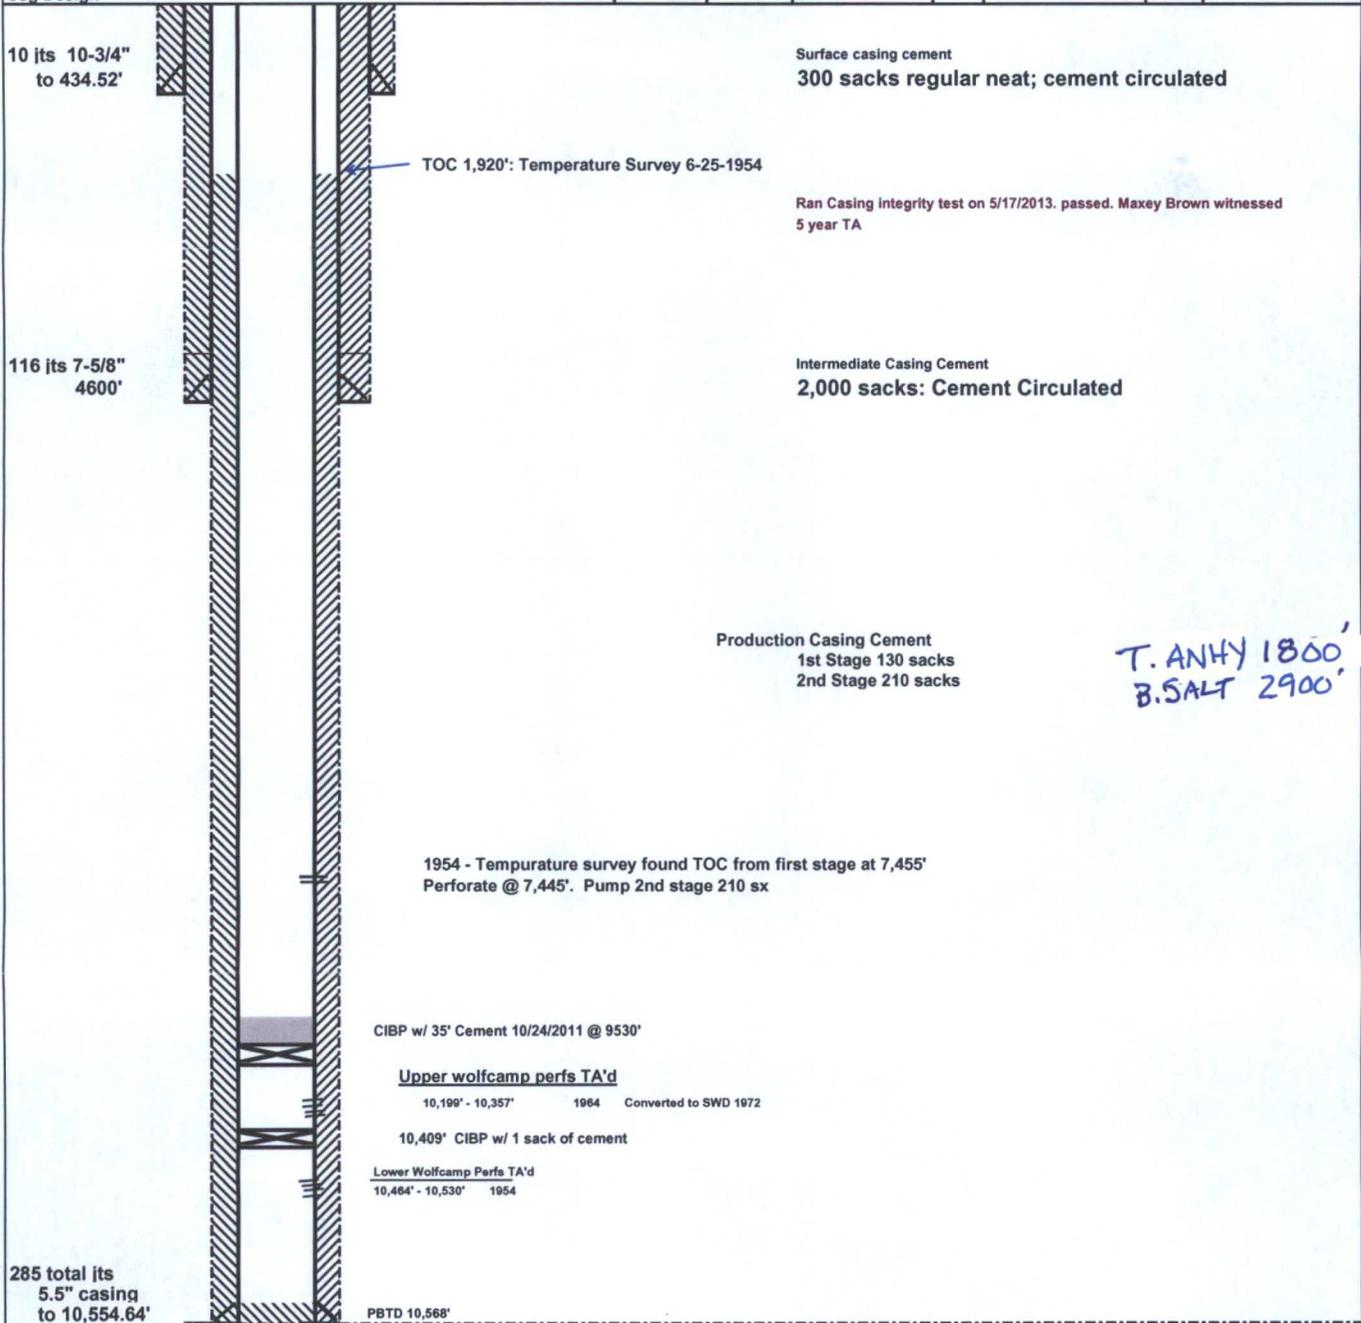

BC Operating, Inc.

Proposed WBD

LEASE:	Hulda A. Townsend
FIELD:	SWD; Wolfcamp
LOCATION:	1980' FNL 1980' FEL
SPUD DATE:	5/3/1954
CONTRACTOR:	unknown

WELL NO.:	6
COUNTY:	Lea
LEGAL:	Sec. 9-16S-35E-M
DRAWN BY:	Jason Goss
DATE:	7/27/2016

API #:	30-025-07265
STATE:	New Mexico
GL:	4014
DF:	
KB:	

Hulda A. Townsend Well No. 6

