

Submit 1 Copy To Appropriate District Office  
 District I - (575) 393-6161  
 1625 N. French Dr., Hobbs, NM 88240  
 District II - (575) 748-1283  
 811 S. First St., Artesia, NM 88210  
 District III - (505) 334-6178  
 1000 Rio Brazos Rd., Aztec, NM 87410  
 District IV - (505) 476-3460  
 1220 S. St. Francis Dr., Santa Fe, NM 87505

State of New Mexico  
 Energy, Minerals and Natural Resources

Form C-103  
 Revised July 18, 2013

**HOBBS CO.**  
**AUG 23 2016**  
**RECEIVED**

**OIL CONSERVATION DIVISION**  
 1220 South St. Francis Dr.  
 Santa Fe, NM 87505

WELL API NO. 30-025-10189	<input checked="" type="checkbox"/>
5. Indicate Type of Lease STATE <input type="checkbox"/> FEE <input checked="" type="checkbox"/>	<input checked="" type="checkbox"/>
6. State Oil & Gas Lease No. N/A	
7. Lease Name or Unit Agreement Name Baker B	<input checked="" type="checkbox"/>
8. Well Number 9	<input checked="" type="checkbox"/>
9. OGRID Number 4323	<input checked="" type="checkbox"/>
10. Pool name or Wildcat Drinkard	<input checked="" type="checkbox"/>
11. Elevation (Show whether DR, RKB, RT, GR, etc.) 3422' GL	

**SUNDRY NOTICES AND REPORTS ON WELLS**  
 (DO NOT USE THIS FORM FOR PROPOSALS TO DRILL OR TO DEEPEN OR PLUG BACK TO A DIFFERENT RESERVOIR. USE "APPLICATION FOR PERMIT" (FORM C-101) FOR SUCH PROPOSALS.)

1. Type of Well: Oil Well  Gas Well  Other

2. Name of Operator  
CHEVRON USA

3. Address of Operator  
1400 SMITH ST. HOUSTON TX 77002

4. Well Location  
 Unit Letter L 2130 feet from the SOUTH line and 810 feet from the WEST line  
 Section 10 Township 22S Range 37E NMPM County LEA

12. Check Appropriate Box to Indicate Nature of Notice, Report or Other Data

<b>NOTICE OF INTENTION TO:</b>		<b>SUBSEQUENT F</b>	
PERFORM REMEDIAL WORK <input type="checkbox"/>	PLUG AND ABANDON <input checked="" type="checkbox"/>	REMEDIAL WORK <input type="checkbox"/>	INT TO PA <input checked="" type="checkbox"/>
TEMPORARILY ABANDON <input type="checkbox"/>	CHANGE PLANS <input type="checkbox"/>	COMMENCE DRILLING OPNS. <input type="checkbox"/>	P&A NR <input type="checkbox"/>
PULL OR ALTER CASING <input type="checkbox"/>	MULTIPLE COMPL <input type="checkbox"/>	CASING/CEMENT JOB <input type="checkbox"/>	P&A R <input type="checkbox"/>
DOWNHOLE COMMINGLE <input type="checkbox"/>			
CLOSED-LOOP SYSTEM <input type="checkbox"/>			
OTHER: <input type="checkbox"/>		OTHER: <input type="checkbox"/>	

13. Describe proposed or completed operations. (Clearly state all pertinent details, and give pertinent dates, including estimated date of starting any proposed work). SEE RULE 19.15.7.14 NMAC. For Multiple Completions: Attach wellbore diagram of proposed completion or recompletion.

Well STATUS: TA'D WITH CIBP @ 6202 w/75' cmt on top, TD: 6527' refer to WBD for details  
**TAG CIBP @ 6200'. CIRC MUD LADEN FLUID. PRESSURE TEST CSG.**

1. SET CIBP AT 3500' W/400 CEMENT PLUG FROM 3500' - 3100' <sup>2870'</sup>

2. PERF AT ~~2850'~~ <sup>2870'</sup> AND SQUEEZE A 400' CEMENT PLUG FROM ~~2850'~~ <sup>2870'</sup> - 2450' W/150 SXS <sup>SIDE/B. SALT</sup>

3. PERF AT ~~600'~~ <sup>1250'</sup> AND CIRCULATE A 400' CEMENT PLUG FROM ~~600'~~ <sup>1250'</sup> - 200' W/150 SXS <sup>T. SALT</sup>

4. PERF 7" AND 9-5/8" CSG AT ~~200'~~ <sup>205'</sup> AND PUMP A ~~200'~~ <sup>205'</sup> CMT PLUG FROM 200' TO SURFACE WITH 75 SXS

5. CUTOFF WELLHEAD. INSTALL DRY HOLE MARKER.

**NOTIFY OCD 24 HOURS PRIOR TO BEGINNING PLUGGING OPERATIONS**

Spud Date:

Rig Release Date:

I hereby certify that the information above is true and complete to the best of my knowledge and belief.

SIGNATURE M. Lee Roark TITLE: Project Manager DATE: 8/22/2016

Type or print name M. Lee Roark E-mail address: lroark@chevron.com PHONE: (432)687-7279

**For State Use Only**

APPROVED BY: Mark Whitaker TITLE: Petroleum Engr. Specialist DATE: 8/23/2016


Conditions of Approval (if any):

MW

**DRINKARD FIELD  
BAKER B9  
LEA COUNTY  
API 30-025-10189  
Spud**



Ground Elev = 3422'  
Tbg Head = XX  
Csg Head = XX  
RKB =

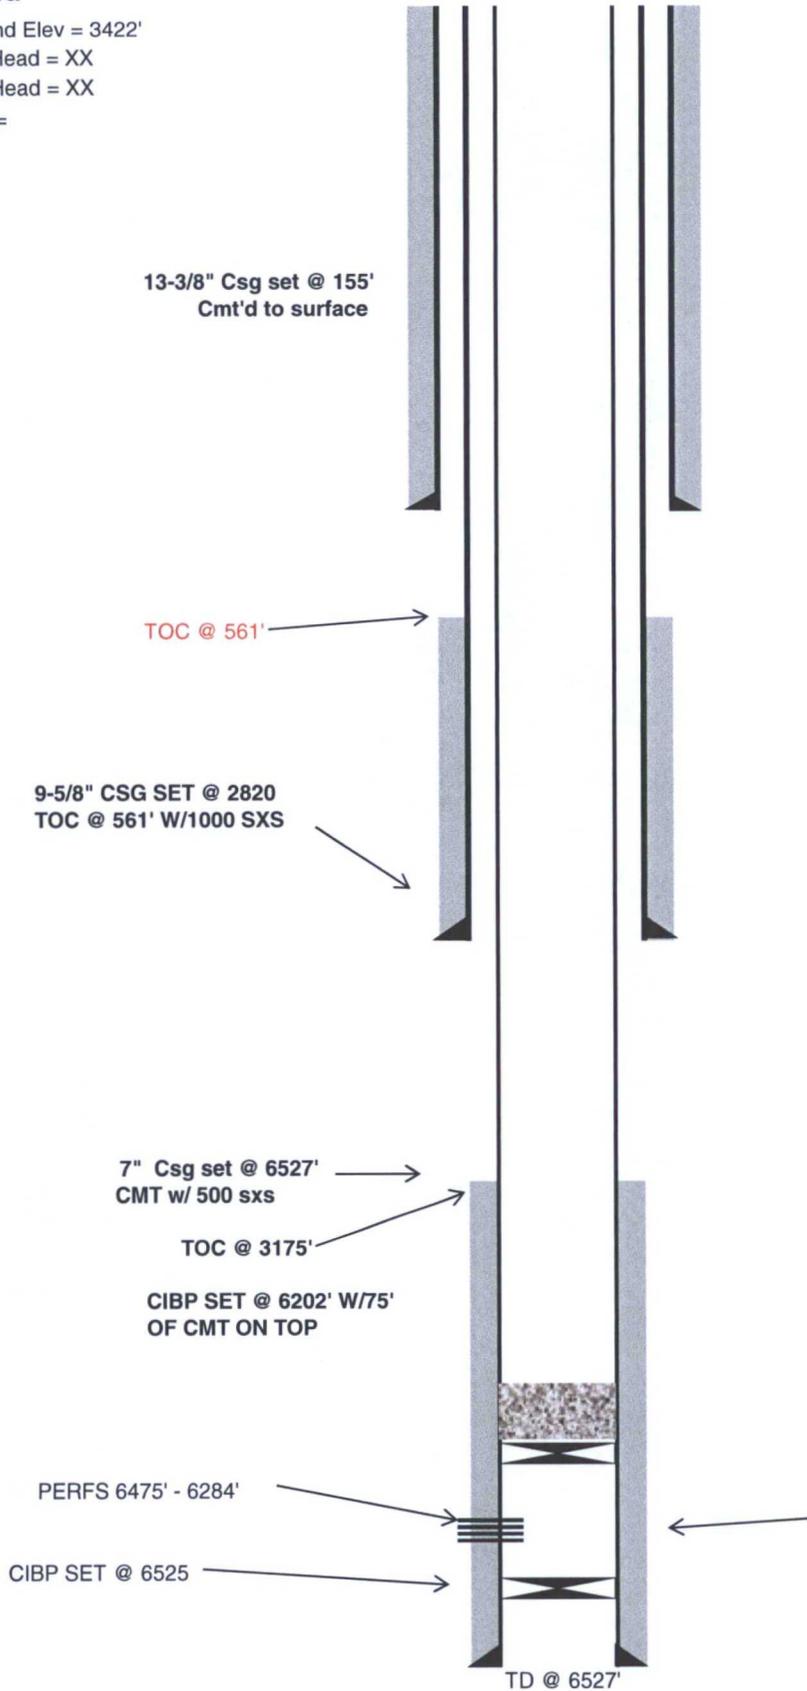


T.SALT 1300'  
B.SALT 2450'

**DRINKARD FIELD  
BAKER B9  
LEA COUNTY  
API 30-025-10189  
Spud**

Ground Elev = 3422'  
Tbg Head = XX  
Csg Head = XX  
RKB =



**Proposed P&A**

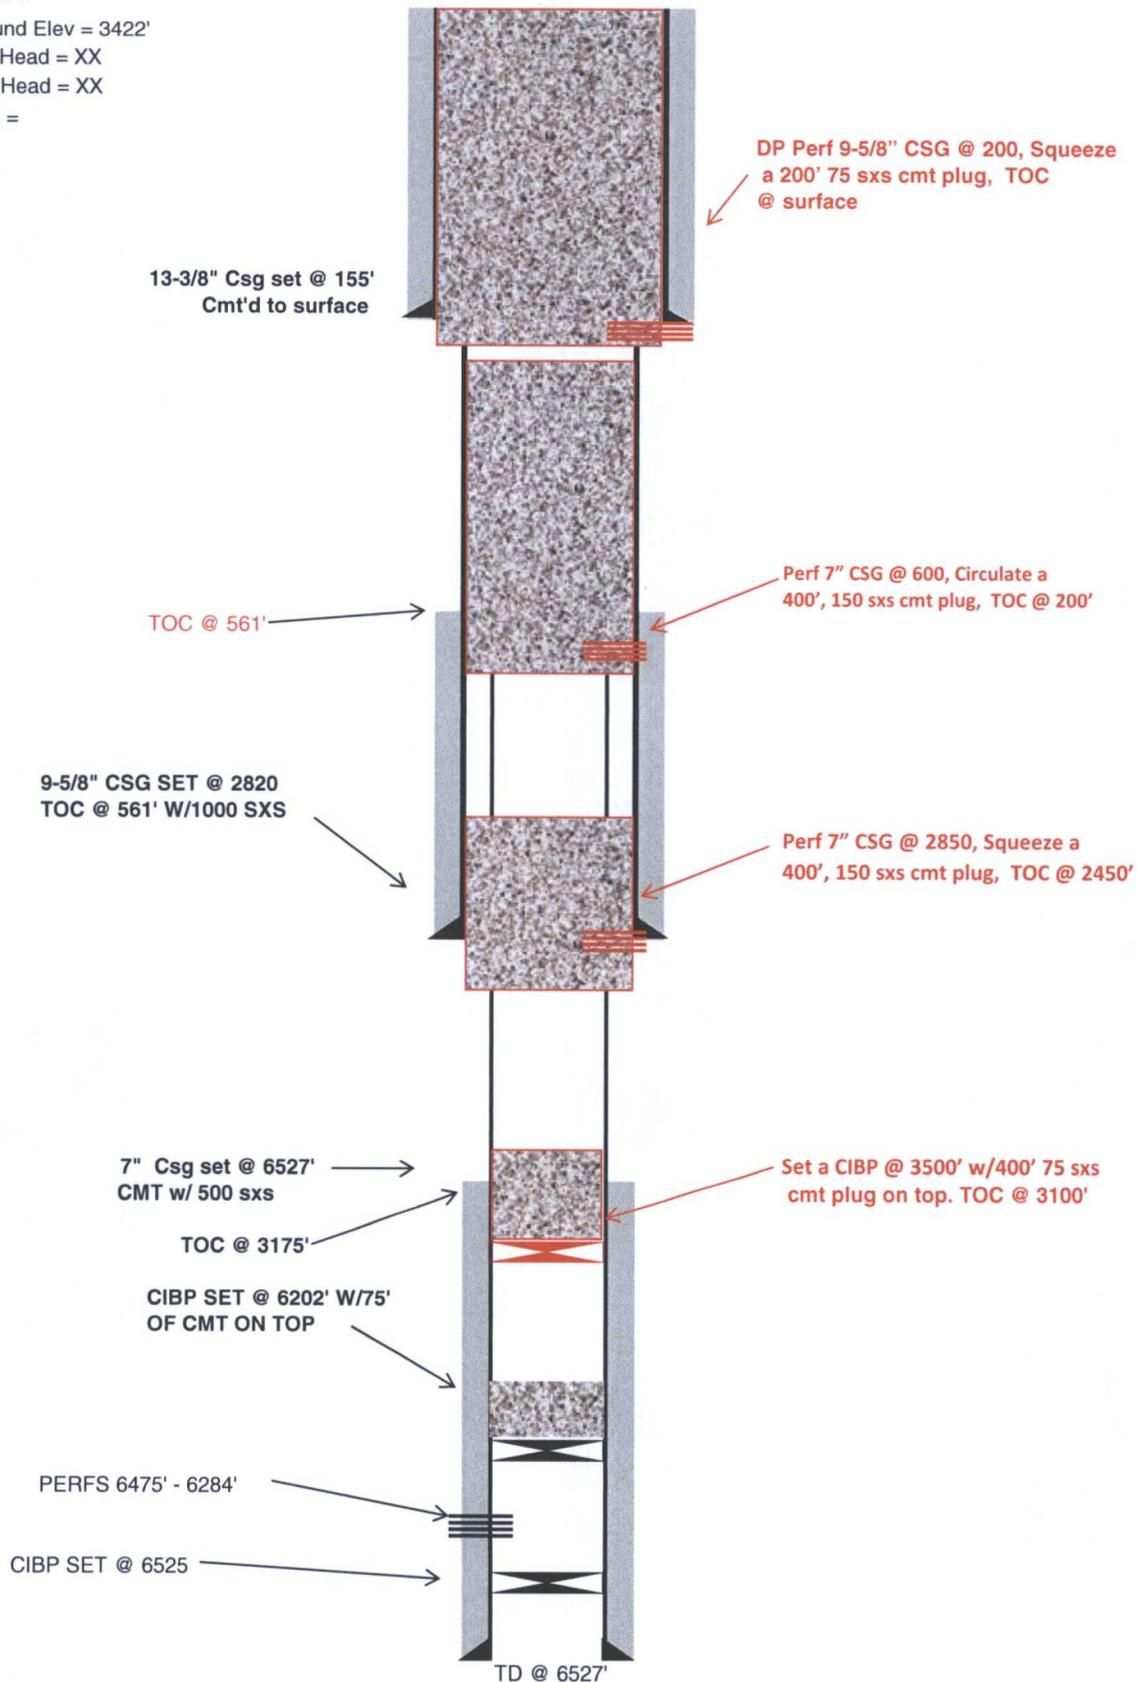

Drawn by: Tony Raphael 8/18/16