

UNITED STATES
DEPARTMENT OF THE INTERIOR
BUREAU OF LAND MANAGEMENT

FORM APPROVED
OMB NO. 1004-0135
Expires: July 31, 2010

SUNDRY NOTICES AND REPORTS ON WELLS
Do not use this form for proposals to drill or to re-enter an abandoned well. Use form 3160-3 (APD) for such proposals.

OCD-HOBBS
HOBBS OGD
APR 17 2017
RECEIVED

5. Lease Serial No.
MNMM0359292

6. If Indian, Allottee or Tribe Name

7. If Unit or CA/Agreement, Name and/or No.

SUBMIT IN TRIPLICATE - Other instructions on reverse side.

1. Type of Well
 Oil Well Gas Well Other

2. Name of Operator
 RKI EXP & PROD, LLC
 Contact: JESSICA M DEMARCE
 E-Mail: jessica.demarce@wpenergy.com

3a. Address
 3500 ONE WILLIAMS CENTER MD35
 TULSA, OK 74172

3b. Phone No. (include area code)
 Ph: 539-573-3521

4. Location of Well (Footage, Sec., T., R., M., or Survey Description)
 Sec 10 T26S R33E

5. Well Name and No.
 GOEDEKE BATTERY

9. API Well No.
 30-025-08406

10. Field and Pool, or Exploratory
 SALADO DRAW; DELAWARE

11. County or Parish, and State
 LEA COUNTY COUNTY, NM

12. CHECK APPROPRIATE BOX(ES) TO INDICATE NATURE OF NOTICE, REPORT, OR OTHER DATA

TYPE OF SUBMISSION	TYPE OF ACTION			
<input type="checkbox"/> Notice of Intent	<input type="checkbox"/> Acidize	<input type="checkbox"/> Deepen	<input type="checkbox"/> Production (Start/Resume)	<input type="checkbox"/> Water Shut-Off
<input checked="" type="checkbox"/> Subsequent Report	<input type="checkbox"/> Alter Casing	<input type="checkbox"/> Fracture Treat	<input type="checkbox"/> Reclamation	<input type="checkbox"/> Well Integrity
<input type="checkbox"/> Final Abandonment Notice	<input type="checkbox"/> Casing Repair	<input type="checkbox"/> New Construction	<input type="checkbox"/> Recomplete	<input checked="" type="checkbox"/> Other
	<input type="checkbox"/> Change Plans	<input type="checkbox"/> Plug and Abandon	<input type="checkbox"/> Temporarily Abandon	Site Facility Diagram/Security Plan
	<input type="checkbox"/> Convert to Injection	<input type="checkbox"/> Plug Back	<input type="checkbox"/> Water Disposal	

13. Describe Proposed or Completed Operation (clearly state all pertinent details, including estimated starting date of any proposed work and approximate duration thereof. If the proposal is to deepen directionally or recomplete horizontally, give subsurface locations and measured and true vertical depths of all pertinent markers and zones. Attach the Bond under which the work will be performed or provide the Bond No. on file with BLM/BIA. Required subsequent reports shall be filed within 30 days following completion of the involved operations. If the operation results in a multiple completion or recompletion in a new interval, a Form 3160-4 shall be filed once testing has been completed. Final Abandonment Notices shall be filed only after all requirements, including reclamation, have been completed, and the operator has determined that the site is ready for final inspection.)

SFD DATED 8/9/2016 ABSM DATED 8/9/2016 ATTACHED for the Geodeke Battery for wells listed below:

- Goedeke #1 - 30-025-08406, Lea, CO
- Goedeke #2 - 30-025-08407, Lea, CO
- Goedeke #3 - 30-025-08408, Lea, CO
- Goedeke #4 - 30-025-39816, Lea, CO

ENTERED 2/5/17
INTO AFMSS


Accepted for Record Purposes.
Approval Subject to Onsite Inspection.
Date: 2/5/17

14. I hereby certify that the foregoing is true and correct.
 Electronic Submission #349975 verified by the BLM Well Information System
 For RKI EXP & PROD, LLC, sent to the Hobbs
 Committed to AFMSS for processing by DEBORAH MCKINNEY on 09/12/2016 ()

Name (Printed/Typed) JESSICA M DEMARCE Title REGULATORY TECH

Signature (Electronic Submission) Date 09/02/2016

THIS SPACE FOR FEDERAL OR STATE OFFICE USE

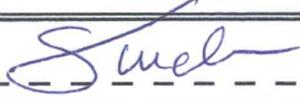Approved By  Title EPS UIC Date 2/5/17


Conditions of approval, if any, are attached. Approval of this notice does not warrant or certify that the applicant holds legal or equitable title to those rights in the subject lease which would entitle the applicant to conduct operations thereon. Office CFO

Title 18 U.S.C. Section 1001 and Title 43 U.S.C. Section 1212, make it a crime for any person knowingly and willfully to make to any department or agency of the United States any false, fictitious or fraudulent statements or representations as to any matter within its jurisdiction.

** OPERATOR-SUBMITTED ** OPERATOR-SUBMITTED ** OPERATOR-SUBMITTED **



PLOT: Wednesday, August 10, 2016 8:14:23 AM / FILE NAME: ABSM - GOEDEKE BATTERY.dwg

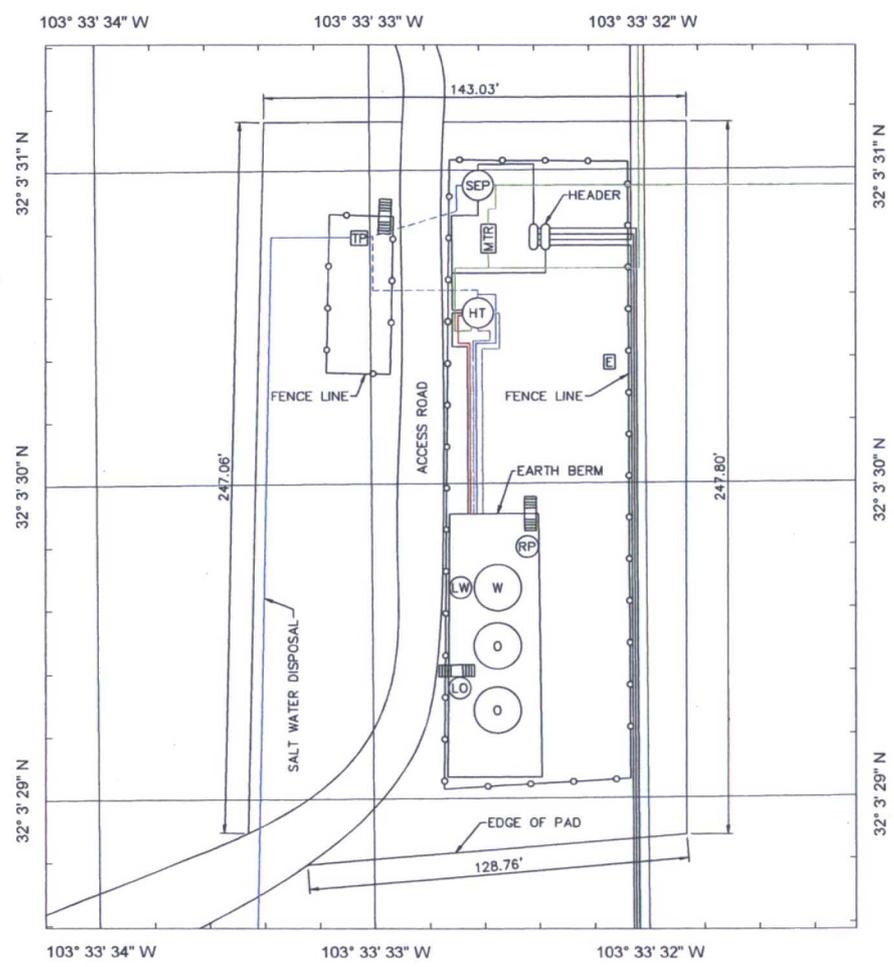

Accepted for Record Purposes,
Approval Subject To Osmre Inspections
Date: _____

GOEDEKE BATTERY
1"=40'

LEGEND	
UG	UNDERGROUND
AG	ABOVE GROUND
[UP]	UTILITY POLE
[E]	ELECTRICAL PANEL/BOX
[SP]	SOLAR PANEL
[GEN]	GENERATOR
---	OVERHEAD POWER LINE
---	ELECTRIC LINE (UG)
---	ELECTRIC LINE (AG)
---	OIL FLOWLINE (UG)
---	OIL FLOWLINE (AG)
---	RECYCLE FLOWLINE (UG)
---	RECYCLE FLOWLINE (AG)
---	WATER FLOWLINE (UG)
---	WATER FLOWLINE (AG)
---	GAS FLOWLINE (UG)
---	GAS FLOWLINE (AG)
---	UNKNOWN FLOWLINE (UG)
---	UNKNOWN FLOWLINE (AG)
---	EDGE OF PAD
○	FENCE
(FWKO)	FREE WATER KNOCKOUT
(LO)	LOAD OUT VALVE (OIL)
(LW)	LOAD OUT VALVE (WATER)
[MTR]	METER
[PU]	PUMPING UNIT
(RP)	RECYCLE PUMP
(SP)	SEPARATOR
(TO)	TANK (OIL)
(TW)	TANK (WATER)
[BLDG]	BUILDING
(C)	COMBUSTOR
(HT)	HEATER TREATER
(F)	FLARE
(FS)	FLARE SEPARATOR
(WH)	WELLHEAD
(SCP)	SURVEY CONTROL POINT
(W)	WELD
R(*)	RISER (SIZE)
[STAIRS]	STAIRS
[TP]	TRANSFER PUMP



REFERENCE DRAWING	DWG NO.	NO.	DATE	PROJECT DESCRIPTION	PROJ.	APE	EPCM	CO	EPCM NO.	APPO.	ISSUE STAGE	DATE	BY	CHKD.	APPO.	PERMIT STAMP	ENGINEER'S STAMP
											REV. 2	08/09/16					
											REV. 1	08/08/14					
											REV. NUMBER 2						

KCI CONSTRUCTION

10000 W. PAX ENERGY

AS-BUILT SITE MAP

LEA COUNTY, NM.

8000 PLOT: GOEDEKE BATTERY

DATE: _____

FILE TYPE: WELL SITE

SCALE: 1" = 40'

DATE: _____

FILE NO.: ABSM-01

Approved for Record Purposes.
Date:

WPX ENERGY
GOEDEKE BATTERY
UNIT LETTER "G"
SEC. 10-126S-R33E
FEDERAL LEASE# NM-359292
LEA COUNTY, NEW MEXICO

General setting of valves, sales by tank gauge.


Production Phase: Sales valves S1 and S2 sealed closed. Fill valve to tank that is in production will be open. Equalizer valve to tank that is in production will be open. Circulating valves will be opened as necessary, then released.

Sales Phase: The tank from which sales are being made will be isolated by sealing closed the fill valve, circulating valve and the equalizer valve during sales and opening the sales valve. Upon completion of the sale the sales valve will be released. Sales by truck will be by tank gauge.

Valve	Production Phase	Sales Phase	Circulating
S1	Closed	Open	Closed
S2	Closed	Open	Closed
C1	Closed or Open	Closed	Closed
C2	Closed or Open	Closed	Closed
F1	Open or Closed	Closed	Closed or Open
F2	Open or Closed	Closed	Closed or Open

The Site Security Plan is kept at WPX's office located at:
5315 Buena Vista Dr. Carlsbad, NM.

GOEDEKE BATTERY
N.T.S.

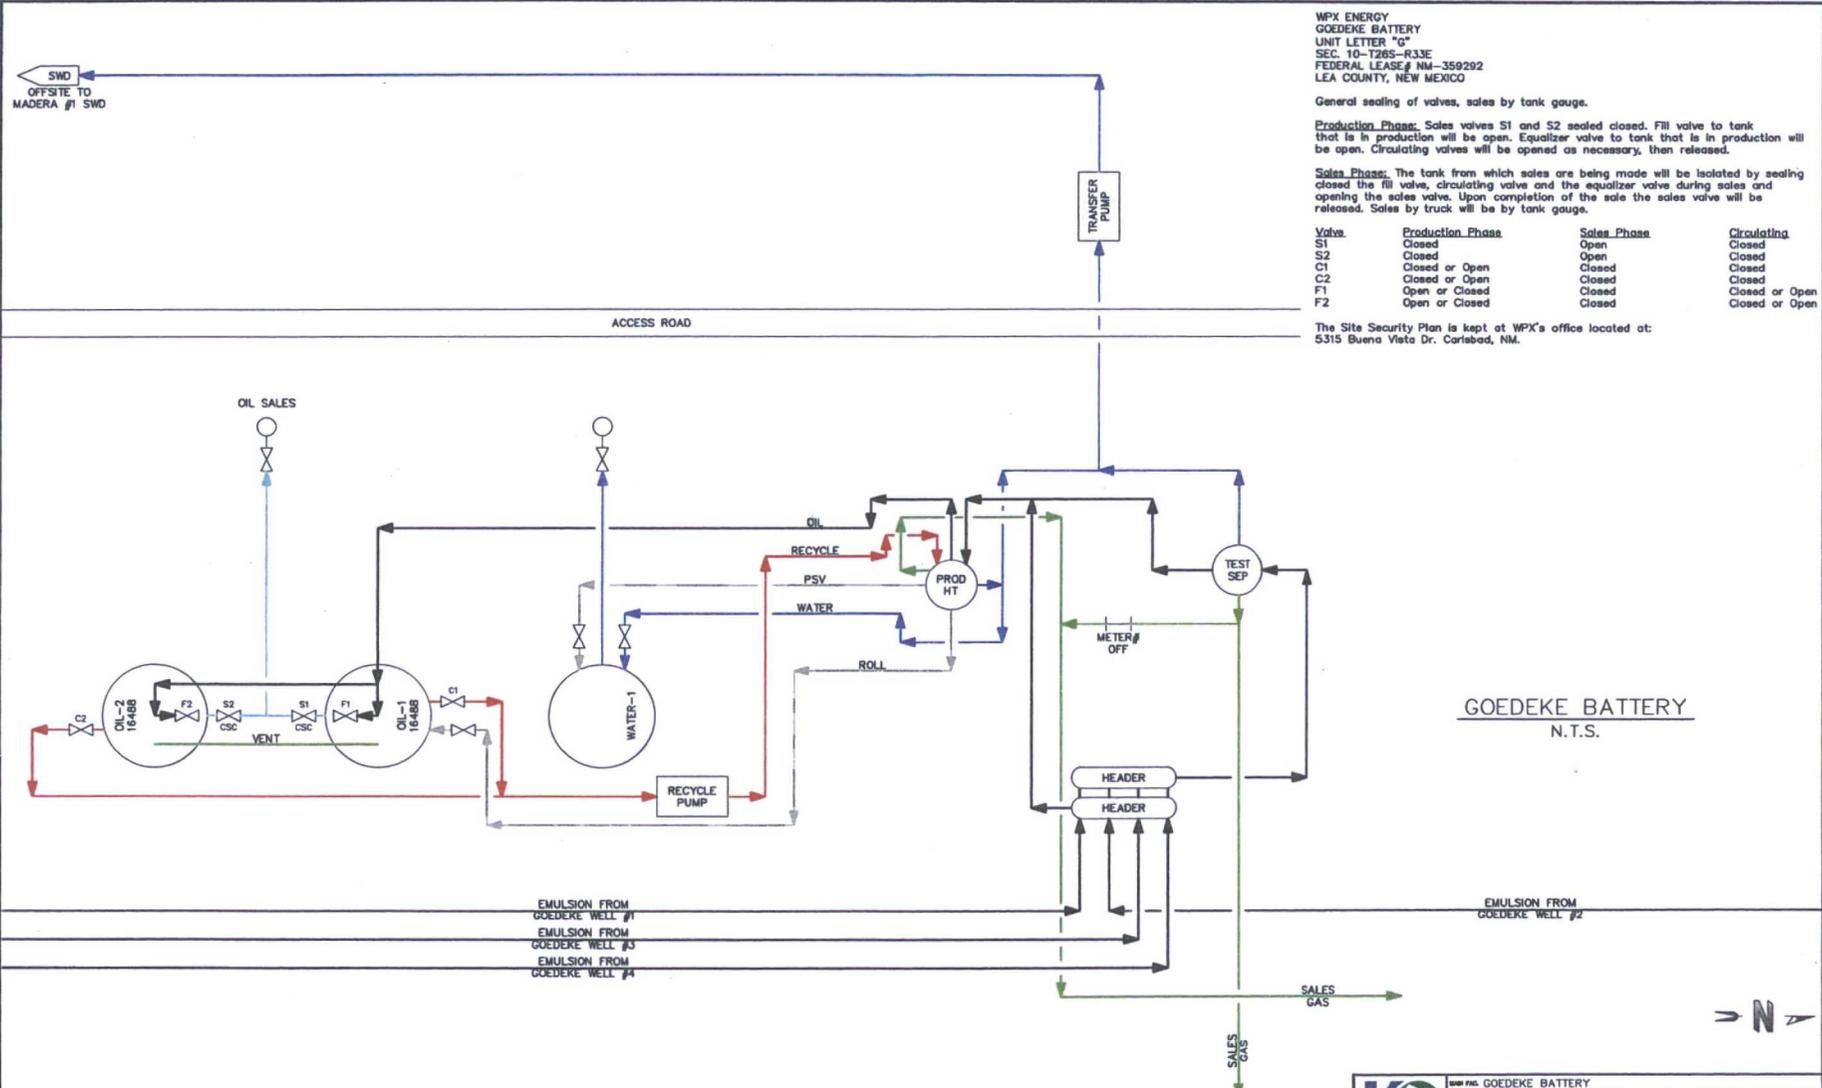

PLOT: Wednesday, August 10, 2016 @ 10:05 AM / FILE NAME: SFD - GOEDEKE BATTERY.dwg

REFERENCE DRAWING	DWG NO.	NO.	DATE	PROJECT DESCRIPTION	PROJ.	APR	EPCH	CO/EPCH	NOI	APPR.	ISSUE	STATUS	DATE	BY	CHKD.	APPR.	PERMIT	STAMP	ENGINEER'S	STAMP
											REV. 2		08/09/16							
											REV. 1		08/08/14							

 CONSTRUCTION	MAP NO. GOEDEKE BATTERY	DATE	
	SCALE 1/4" = 1'	DATE	
	DATE		
	DATE		
 CONSTRUCTION	SCALE N.T.S.	DATE	
SITE NO. WPX ENERGY TITLE SITE FACILITY DIAGRAM AREA LEA COUNTY, NEW MEXICO	SCALE	FILE NO.	SFD-01