

UNITED STATES  
DEPARTMENT OF THE INTERIOR  
BUREAU OF LAND MANAGEMENT

FORM APPROVED  
OMB NO. 1004-0137  
Expires: January 31, 2018

**SUNDRY NOTICES AND REPORTS ON WELLS**  
*Do not use this form for proposals to drill or to re-enter an abandoned well. Use form 3160-3 (APD) for such proposals.*

5. Lease Serial No.  
NMNM0381550C

6. If Indian, Allottee or Tribe Name

7. If Unit or CA/Agreement, Name and/or No.

**SUBMIT IN TRIPLICATE - Other instructions on page 2**

HOBBS  
OCD  
APR 17 2017  
RECEIVED

1. Type of Well  
 Oil Well  Gas Well  Other

2. Name of Operator  
XTO ENERGY, INC / Contact: STEPHANIE RABADUE  
E-Mail: stephanie\_rabadue@xtoenergy.com

3a. Address  
500 W. ILLINOIS ST STE 100  
MIDLAND, TX 79701

3b. Phone No. (include area code)  
Ph: 432-620-6714

8. Well Name and No.  
PERLA NEGRA FEDERAL COM 1H /

9. API Well No.  
30-025-41131

10. Field and Pool or Exploratory Area  
LEA; BONE SPRING

4. Location of Well (Footage, Sec., T., R., M., or Survey Description)  
Sec 24 T19S R34E Mer NMP 330FSL 400FWL /

11. County or Parish, State  
LEA COUNTY, NM

**12. CHECK THE APPROPRIATE BOX(ES) TO INDICATE NATURE OF NOTICE, REPORT, OR OTHER DATA**

TYPE OF SUBMISSION	TYPE OF ACTION			
<input type="checkbox"/> Notice of Intent	<input type="checkbox"/> Acidize	<input type="checkbox"/> Deepen	<input type="checkbox"/> Production (Start/Resume)	<input type="checkbox"/> Water Shut-Off
<input checked="" type="checkbox"/> Subsequent Report	<input type="checkbox"/> Alter Casing	<input type="checkbox"/> Hydraulic Fracturing	<input type="checkbox"/> Reclamation	<input type="checkbox"/> Well Integrity
<input type="checkbox"/> Final Abandonment Notice	<input type="checkbox"/> Casing Repair	<input type="checkbox"/> New Construction	<input type="checkbox"/> Recomplete	<input checked="" type="checkbox"/> Other Site Facility Diagram/Security Plan
	<input type="checkbox"/> Change Plans	<input type="checkbox"/> Plug and Abandon	<input type="checkbox"/> Temporarily Abandon	
	<input type="checkbox"/> Convert to Injection	<input type="checkbox"/> Plug Back	<input type="checkbox"/> Water Disposal	

13. Describe Proposed or Completed Operation: Clearly state all pertinent details, including estimated starting date of any proposed work and approximate duration thereof. If the proposal is to deepen directionally or recompleat horizontally, give subsurface locations and measured and true vertical depths of all pertinent markers and zones. Attach the Bond under which the work will be performed or provide the Bond No. on file with BLM/BIA. Required subsequent reports must be filed within 30 days following completion of the involved operations. If the operation results in a multiple completion or recompleat in a new interval, a Form 3160-4 must be filed once testing has been completed. Final Abandonment Notices must be filed only after all requirements, including reclamation, have been completed and the operator has determined that the site is ready for final inspection.

Please see attached site facility diagram. List of wells going into the battery:

- Perla Negra Federal Com #1H; API 30-025-41131
- Perla Negra Federal Com #2H; API 30-025-42709
- Perla Negra Federal Com #3H; API 30-025-42710
- Perla Negra Federal Com #4H; API 30-025-42577

ENTERED 2-6-17  
INTO AFMSS

Accepted for Record Purposes.  
Approval Subject to Onsite Inspection.  
Date: 2-6-17

14. I hereby certify that the foregoing is true and correct.  
**Electronic Submission #358606 verified by the BLM Well Information System  
For XTO ENERGY, INC, sent to the Hobbs  
Committed to AFMSS for processing by DEBORAH MCKINNEY on 01/10/2017 ()**

Name (Printed/Typed) STEPHANIE RABADUE Title REGULATORY ANALYST

Signature (Electronic Submission) Date 11/21/2016

**THIS SPACE FOR FEDERAL OR STATE OFFICE USE**

Approved By [Signature] Title EPS. UE Date 2-6-17

Conditions of approval, if any, are attached. Approval of this notice does not warrant or certify that the applicant holds legal or equitable title to those rights in the subject lease which would entitle the applicant to conduct operations thereon. Office CFD

Title 18 U.S.C. Section 1001 and Title 43 U.S.C. Section 1212, make it a crime for any person knowingly and willfully to make to any department or agency of the United States any false, fictitious or fraudulent statements or representations as to any matter within its jurisdiction.


(Instructions on page 2)

**\*\* OPERATOR-SUBMITTED \*\* OPERATOR-SUBMITTED \*\* OPERATOR-SUBMITTED \*\***

[Signature]

- V-100 2 Phs. Vertical Sep. 3' x 10' 1440#
- V-200 3 Phs. Horiz. Sep. 5' x 15' 125#
- V-300 2 Phs. Vertical Sep. 3' x 10' 125#
- V-400 2 Phs. Vertical Sep. 3' x 10' 1440#
- V-500 3 Phs. Vertical Sep. 5' x 15' 125#
- V-600 Heater Treater 6' x 20' 125#
- T-100 750 Gun Barrel 15'0" x 24'
- T-200 Water Tank 1,000 BBL 21'6" x 16'
- T-300 Water Tank 1,000 BBL 21'6" x 16'
- T-400 Oil Tank 1,000 BBL 21'6" x 16'
- T-500 Oil Tank 1,000 BBL 21'6" x 16'
- T-600 Oil Tank 1,000 BBL 21'6" x 16'
- T-700 Blowdown Tank 210 BBL 10'-0" x 15'-0"

TO FLARE

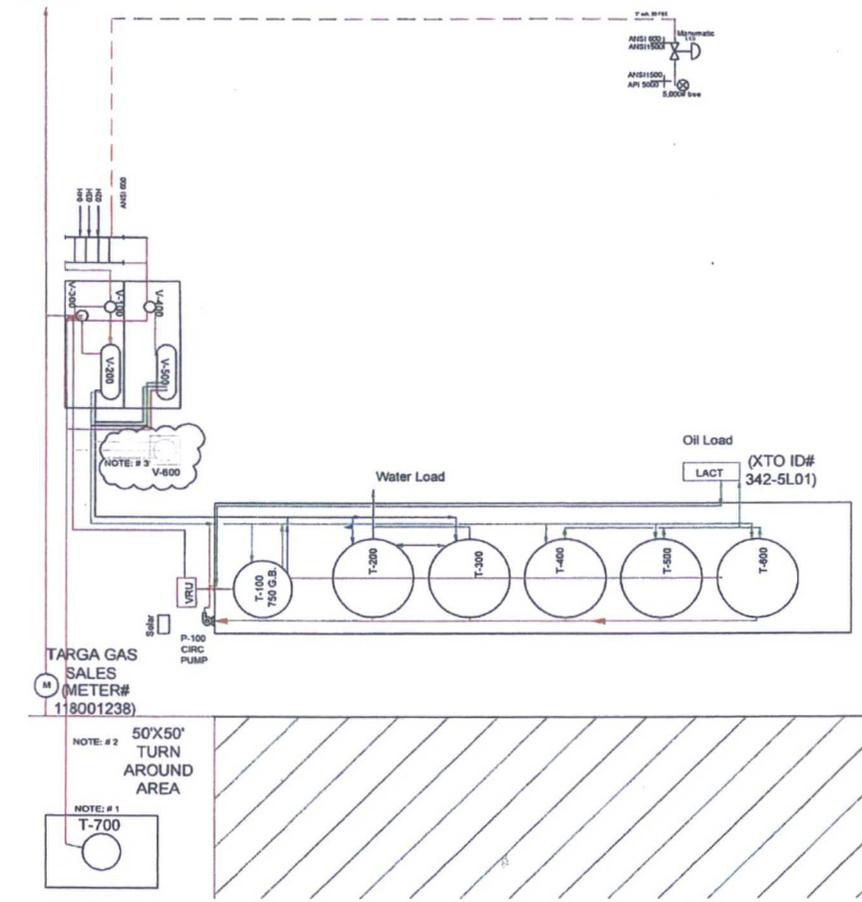

Accepted for Record Purposes.  
Subject to Onsite Inspection.

- NOTES:
- 1.) BLOWDOWN TANK CALICHE BERM TO BE 20' X 30'
  - 2.) 50' X 50' TURN AROUND AREA EXPANSION (HEADER 148' FROM FLARE, WELL 1H FLOW LINE OUT OF GROUND 132' FROM FLARE)
  - 3.) FUTURE PLACEMENT OF HEATER TREATER WHEN NEEDED.

**AS BUILT**

DATE: \_\_\_\_\_

SIGN: \_\_\_\_\_

Revision	Description of Change	Date	By
0	ADDED EQUIPMENT NUMBERS	10-27-16	JGD

**PERLA NEGRA**  
TANK BATTERY  
LEA COUNTY, NEW MEXICO

**LEASE FLOW DIAGRAM**

XTO - PB - PNGR - 00CTB - LFD - 000 - 6021 - 0

Company	Division	Field	Facility	Doc Type	Equip	Doc #	Revision
---------	----------	-------	----------	----------	-------	-------	----------