

UNITED STATES  
DEPARTMENT OF THE INTERIOR  
BUREAU OF LAND MANAGEMENT

**SUNDRY NOTICES AND REPORTS ON WELLS**  
Do not use this form for proposals to drill or to re-enter an abandoned well. Use form 3160-3 (APD) for such proposals.

FORM APPROVED  
OMB NO. 1004-0137  
Expires: January 31, 2018

OCD-110BBS  
HOBBS  
APR 17 2017  
RECEIVED

5. Lease Serial No.  
NMNM16353

6. If Indian, Allottee or Tribe Name

7. If Unit or CA/Agreement, Name and/or No.

**SUBMIT IN TRIPLICATE - Other instructions on page 2**

1. Type of Well <input checked="" type="checkbox"/> Oil Well <input type="checkbox"/> Gas Well <input type="checkbox"/> Other		8. Well Name and No. OUTRIDER FEDERAL 6H /
2. Name of Operator XTO ENERGY, INC /		9. API Well No. 30-025-42932
3a. Address 500 W. ILLINOIS ST STE 100 MIDLAND, TX 79701	3b. Phone No. (include area code) Ph: 432-620-6714	10. Field and Pool or Exploratory Area WC-025 G-06 S253306M; BS
4. Location of Well (Footage, Sec., T., R., M., or Survey Description) Sec 27 T24S R32E Mer NMP 170FNL 2115FEL ✓		11. County or Parish, State LEA COUNTY, NM

12. CHECK THE APPROPRIATE BOX(ES) TO INDICATE NATURE OF NOTICE, REPORT, OR OTHER DATA

TYPE OF SUBMISSION	TYPE OF ACTION			
<input type="checkbox"/> Notice of Intent	<input type="checkbox"/> Acidize	<input type="checkbox"/> Deepen	<input type="checkbox"/> Production (Start/Resume)	<input type="checkbox"/> Water Shut-Off
<input checked="" type="checkbox"/> Subsequent Report	<input type="checkbox"/> Alter Casing	<input type="checkbox"/> Hydraulic Fracturing	<input type="checkbox"/> Reclamation	<input type="checkbox"/> Well Integrity
<input type="checkbox"/> Final Abandonment Notice	<input type="checkbox"/> Casing Repair	<input type="checkbox"/> New Construction	<input type="checkbox"/> Recomplete	<input checked="" type="checkbox"/> Other Site Facility Diagram/Security Plan
	<input type="checkbox"/> Change Plans	<input type="checkbox"/> Plug and Abandon	<input type="checkbox"/> Temporarily Abandon	
	<input type="checkbox"/> Convert to Injection	<input type="checkbox"/> Plug Back	<input type="checkbox"/> Water Disposal	

13. Describe Proposed or Completed Operation: Clearly state all pertinent details, including estimated starting date of any proposed work and approximate duration thereof. If the proposal is to deepen directionally or recompleat horizontally, give subsurface locations and measured and true vertical depths of all pertinent markers and zones. Attach the Bond under which the work will be performed or provide the Bond No. on file with BLM/BIA. Required subsequent reports must be filed within 30 days following completion of the involved operations. If the operation results in a multiple completion or recompleat in a new interval, a Form 3160-4 must be filed once testing has been completed. Final Abandonment Notices must be filed only after all requirements, including reclamatation, have been completed and the operator has determined that the site is ready for final inspection.

Please see attached Site Facility Diagram for:

Outrider Federal 6H; API 30-025-42932  
Charro Federal Com 1H; API 30-025-42794

ENTERED 2/16/17  
INTO AFMSS

Accepted for Record Purposes.  
Approval Subject to Onsite Inspection.  
Date: 2/16/17

14. I hereby certify that the foregoing is true and correct.

Electronic Submission #358605 verified by the BLM Well Information System  
For XTO ENERGY, INC, sent to the Hobbs  
Committed to AFMSS for processing by DEBORAH MCKINNEY on 01/10/2017 ( )

Name (Printed/Typed) STEPHANIE RABADUE	Title REGULATORY ANALYST
Signature (Electronic Submission)	Date 11/21/2016

**THIS SPACE FOR FEDERAL OR STATE OFFICE USE**


Approved By <u>Stucker</u>	Title <u>CFO EPS. LE</u>	Date <u>2/16/17</u>
Conditions of approval, if any, are attached. Approval of this notice does not warrant or certify that the applicant holds legal or equitable title to those rights in the subject lease which would entitle the applicant to conduct operations thereon.	Office <u>CFO</u>	

Title 18 U.S.C. Section 1001 and Title 43 U.S.C. Section 1212, make it a crime for any person knowingly and willfully to make to any department or agency of the United States any false, fictitious or fraudulent statements or representations as to any matter within its jurisdiction.

(Instructions on page 2)

**\*\* OPERATOR-SUBMITTED \*\* OPERATOR-SUBMITTED \*\* OPERATOR-SUBMITTED \*\***

*Kz*

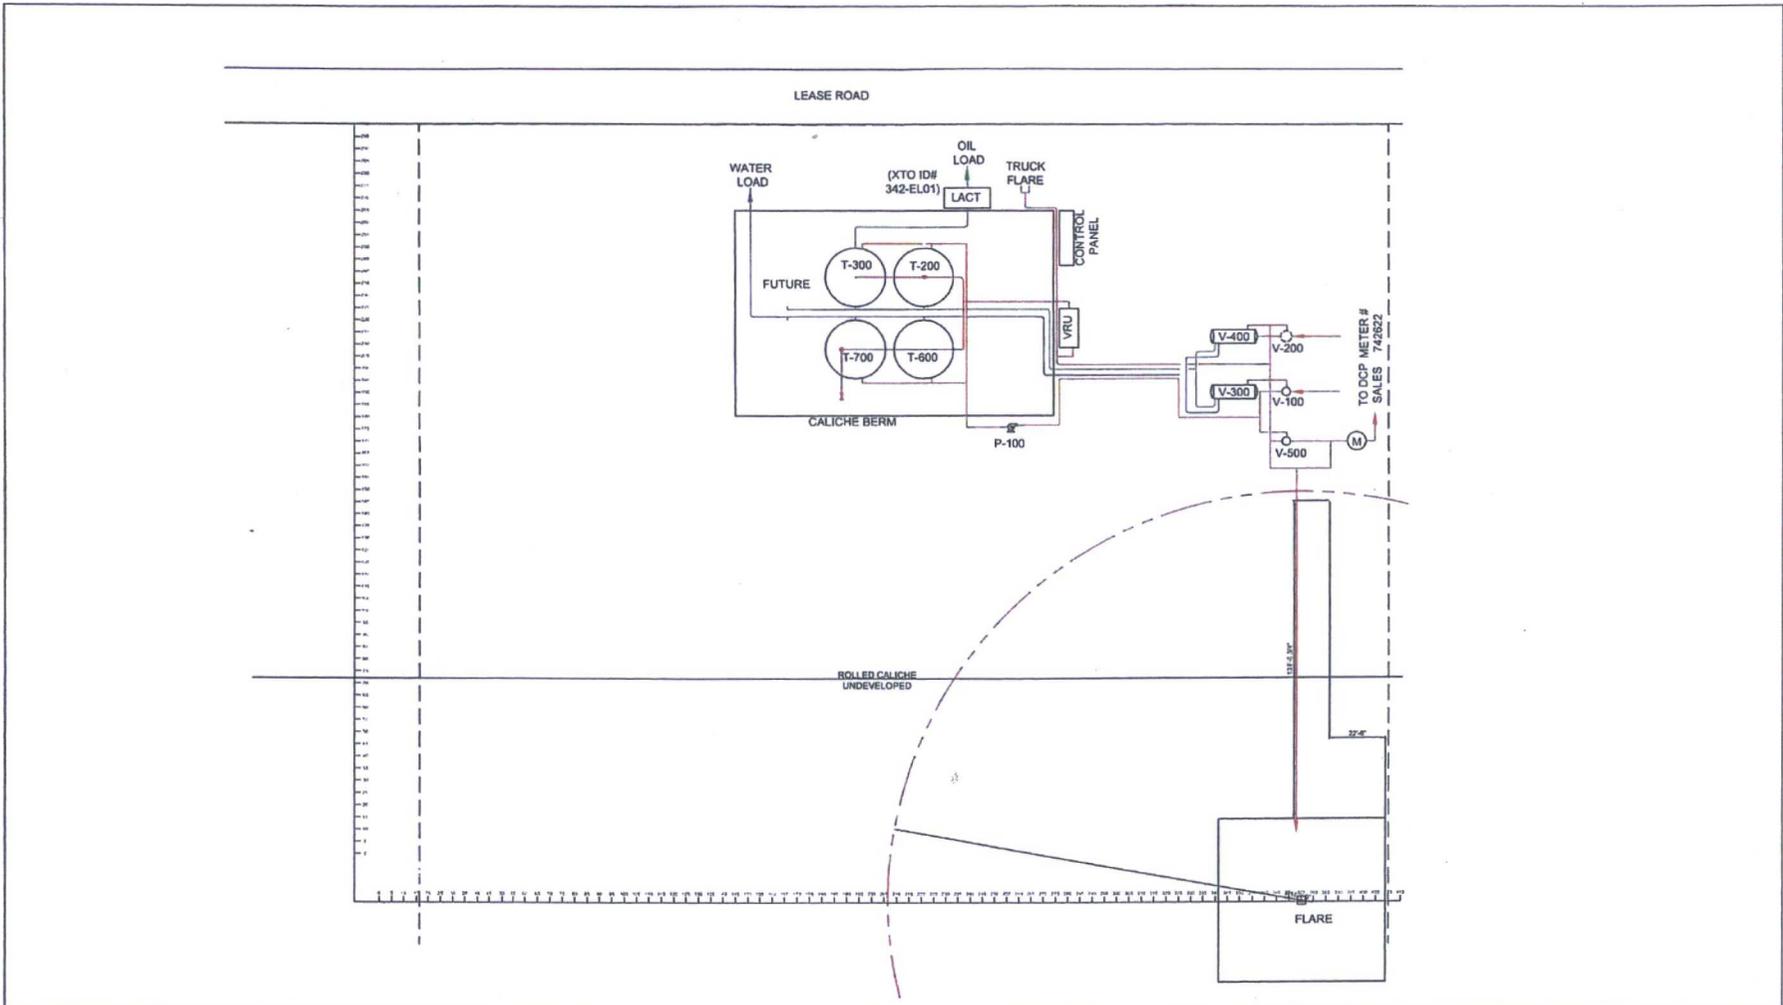

\* NOTE 1: N/A

AS BUILT

DATE: \_\_\_\_\_  
SIGN: \_\_\_\_\_

Revision	Description of Change	Date	By
0	ISSUED FOR REVIEW	09/25/15	DHB

**XTO ENERGY** CAZADOR/OUTRIDER  
CENTRAL TANK BATTERY  
COUNTY, NEW MEXICO

**LEASE FLOW DIAGRAM**

XTO - PB - CAZO - 0TBAT - PFD - 000 - 5348 - 0

Company	Division	Field	Facility	Doc Type	Equip	Doc #	Revision

LAST REVIEW: 09/25/15