

UNITED STATES
DEPARTMENT OF THE INTERIOR
BUREAU OF LAND MANAGEMENT

OCD Hobbs

FORM APPROVED
OMB NO. 1004-0137
Expires: January 31, 2018

SUNDRY NOTICES AND REPORTS ON WELLS
Do not use this form for proposals to drill or to re-enter an abandoned well. Use form 3160-3 (APD) for such proposals.

5. Lease Serial No.
NMNM97163

6. If Indian, Allottee or Tribe Name

7. If Unit or CA/Agreement, Name and/or No.

SUBMIT IN TRIPLICATE - Other instructions on page 2

HOBBS OCD

1. Type of Well
 Oil Well Gas Well Other

2. Name of Operator
CHEVRON USA INCORPORATED
Contact: CINDY H MURILLO
E-Mail: CHERRAMURILLO@CHEVRON.COM

3a. Address
6301 DEAUVILLE BLVD
MIDLAND, TX 79706

3b. Phone No. (include area code)
Ph: 575-263-0431
Fx: 575-263-0445

4. Location of Well (Footage, Sec., T., R., M., or Survey Description)
Sec 24 T20S R38E NWNE 660FNL 1980FEL

8. Well Name and No.
CAPPS FEDERAL 01

9. API Well No.
30-025-34267-00-C1

10. Field and Pool or Exploratory Area
BLINEBRY OIL & GAS
DK

11. County or Parish, State
LEA COUNTY, NM

NOV 18 2019

RECEIVED

12. CHECK THE APPROPRIATE BOX(ES) TO INDICATE NATURE OF NOTICE, REPORT, OR OTHER DATA


TYPE OF SUBMISSION	TYPE OF ACTION			
<input type="checkbox"/> Notice of Intent	<input type="checkbox"/> Acidize	<input type="checkbox"/> Deepen	<input type="checkbox"/> Production (Start/Resume)	<input type="checkbox"/> Water Shut-Off
<input checked="" type="checkbox"/> Subsequent Report	<input type="checkbox"/> Alter Casing	<input type="checkbox"/> Hydraulic Fracturing	<input type="checkbox"/> Reclamation	<input type="checkbox"/> Well Integrity
<input type="checkbox"/> Final Abandonment Notice	<input type="checkbox"/> Casing Repair	<input type="checkbox"/> New Construction	<input type="checkbox"/> Recomplete	<input checked="" type="checkbox"/> Other Site Facility Diagram/Security Plan
	<input type="checkbox"/> Change Plans	<input type="checkbox"/> Plug and Abandon	<input type="checkbox"/> Temporarily Abandon	
	<input type="checkbox"/> Convert to Injection	<input type="checkbox"/> Plug Back	<input type="checkbox"/> Water Disposal	

13. Describe Proposed or Completed Operation: Clearly state all pertinent details, including estimated starting date of any proposed work and approximate duration thereof. If the proposal is to deepen directionally or recomplete horizontally, give subsurface locations and measured and true vertical depths of all pertinent markers and zones. Attach the Bond under which the work will be performed or provide the Bond No. on file with BLM/BIA. Required subsequent reports must be filed within 30 days following completion of the involved operations. If the operation results in a multiple completion or recompletion in a new interval, a Form 3160-4 must be filed once testing has been completed. Final Abandonment Notices must be filed only after all requirements, including reclamation, have been completed and the operator has determined that the site is ready for final inspection.

CHEVRON USA INC IS SUBMITTING A SITE SECURITY DIAGRAM ON THE ABOVE WELL.
WELLS AFFECTED ARE AS FOLLOWS:

CAPPS FEDERAL #1 30-025-34267
CAPPS FEDERAL #2 30-025-34289

PLEASE FIND ATTACHED SITE SECURITY DIAGRAM

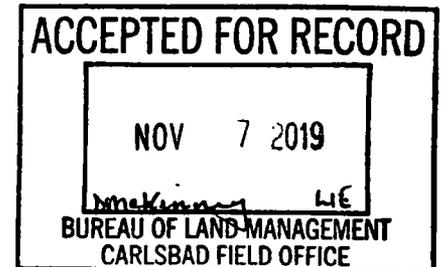

14. I hereby certify that the foregoing is true and correct.
Electronic Submission #491283 verified by the BLM Well Information System
For CHEVRON USA INCORPORATED, sent to the Hobbs
Committed to AFMSS for processing by DEBORAH MCKINNEY on 11/07/2019 (20DLM0055SE)

Name (Printed/Typed) CINDY H MURILLO Title PERMITTING SPECIALIST

Signature (Electronic Submission) Date 11/06/2019

THIS SPACE FOR FEDERAL OR STATE OFFICE USE

Approved By _____ Title _____ Date _____

Conditions of approval, if any, are attached. Approval of this notice does not warrant or certify that the applicant holds legal or equitable title to those rights in the subject lease which would entitle the applicant to conduct operations thereon.


Office _____

Title 18 U.S.C. Section 1001 and Title 43 U.S.C. Section 1212, make it a crime for any person knowingly and willfully to make to any department or agency of the United States any false, fictitious or fraudulent statements or representations as to any matter within its jurisdiction.

(Instructions on page 2)

**** BLM REVISED ** BLM REVISED ** BLM REVISED ** BLM REVISED ** BLM REVISED ****

Ka

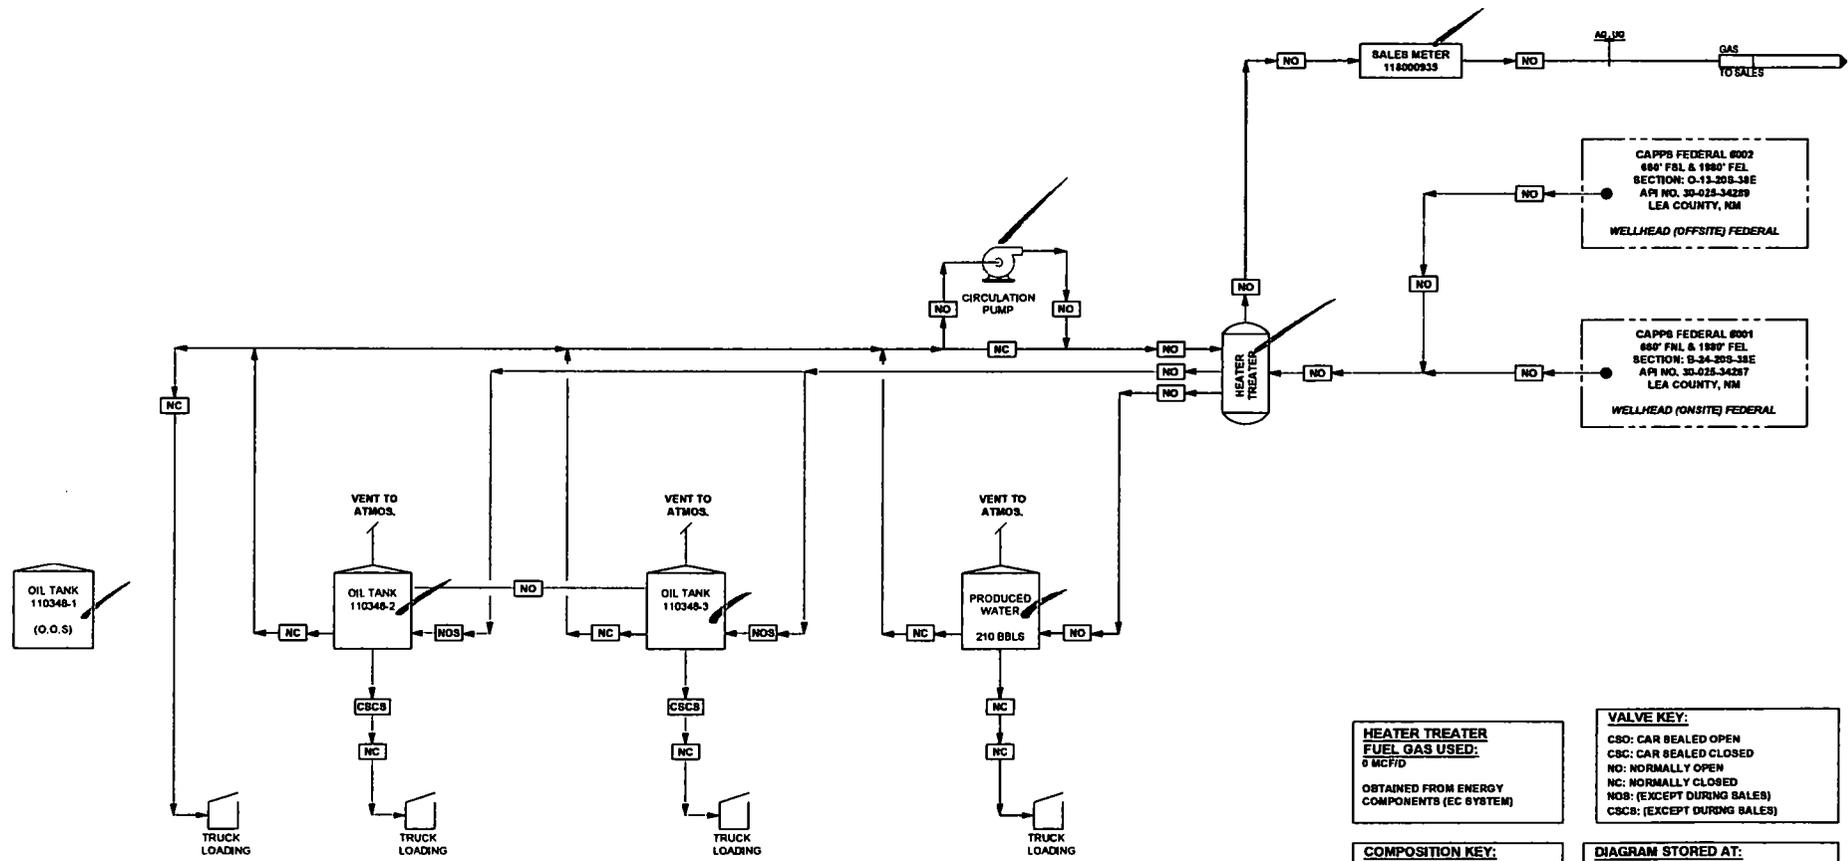

HEATER TREATER FUEL GAS USED:
6 MCF/D
OBTAINED FROM ENERGY COMPONENTS (EC SYSTEM)

VALVE KEY:
CSO: CAR SEALED OPEN
CSC: CAR SEALED CLOSED
NO: NORMALLY OPEN
NC: NORMALLY CLOSED
NCS: (EXCEPT DURING SALES)
CBCS: (EXCEPT DURING SALES)

COMPOSITION KEY:
— OIL/WATER/GAS
— OIL/WATER
— OIL
— WATER
— GAS

DIAGRAM STORED AT:
CHEVRON MIDCONTINENT HEADQUARTERS
6301 DEAUVILLE BLVD
MIDLAND, TEXAS 79706

REVISIONS				
△	ISSUED AS-BUILT			△
△	BASIN DESIGN, DRP #19418	MWH 11/05/19	MW	△
△				△
△				△

AS-BUILT

Chevron U.S.A. Inc.
DR. JCK
ENG. TZZD

DELAWARE BASIN - EUNICE FOT
CAPPs FEDERAL 1_2 - LEA COUNTY, NM
CAPPs FEDERAL 1_2 CTB - SITE SECURITY DIAGRAM
CPSFD-CPSFED12-PRO-SSD-MCB-0001

PLOT DATE: 11/05/2019, FILE NAME: CPSFD-CPSFED12-PRO-SSD-MCB-0001
LEASE NUMBER
ALTERNATE DWO NUMBER API NUMBER