

DISTRICT I
1625 N. FRENCH DR., HOBBS, NM 88240
Phone: (575) 593-6191 Fax: (575) 593-0720

DISTRICT II
811 S. FIRST ST., ARTESIA, NM 88210
Phone: (575) 748-1283 Fax: (575) 748-0720

DISTRICT III
1000 RIO BRAZOS RD., AZTEC, NM 87410
Phone: (505) 334-6178 Fax: (505) 334-6170

DISTRICT IV
1220 S. ST. FRANCIS DR., SANTA FE, NM 87505
Phone: (505) 476-3460 Fax: (505) 476-3462

State of New Mexico
Energy, Minerals & Natural Resources Department
OIL CONSERVATION DIVISION
1220 SOUTH ST. FRANCIS DR.
Santa Fe, New Mexico 87505

Form C-102
Revised August 1, 2011
Submit one copy to appropriate
District Office

AMENDED REPORT
As Drilled

WELL LOCATION AND ACREAGE DEDICATION PLAT

API Number 30-025-45924	Pool Code 51687	Pool Name RED TANK; BONE SPRING; EAST
Property Code 325625	Property Name AVOGATO 30_31 STATE COM	Well Number 21H
OGRID No. 16696	Operator Name OXY USA, INC.	Elevation 3707.2'

Surface Location


UL or lot No.	Section	Township	Range	Lot Idn	Feet from the	North/South line	Feet from the	East/West line	County
C	30	22-S	33-E		420	NORTH	1350	WEST	LEA

Bottom Hole Location If Different From Surface

UL or lot No.	Section	Township	Range	Lot Idn	Feet from the	North/South line	Feet from the	East/West line	County
4	31	22-S	33-E		17	SOUTH	563	WEST	LEA

Dedicated Acres	Joint or Infill	Consolidation Code	Order No.
613.28			

NO ALLOWABLE WILL BE ASSIGNED TO THIS COMPLETION UNTIL ALL INTERESTS HAVE BEEN CONSOLIDATED OR A NON-STANDARD UNIT HAS BEEN APPROVED BY THE DIVISION

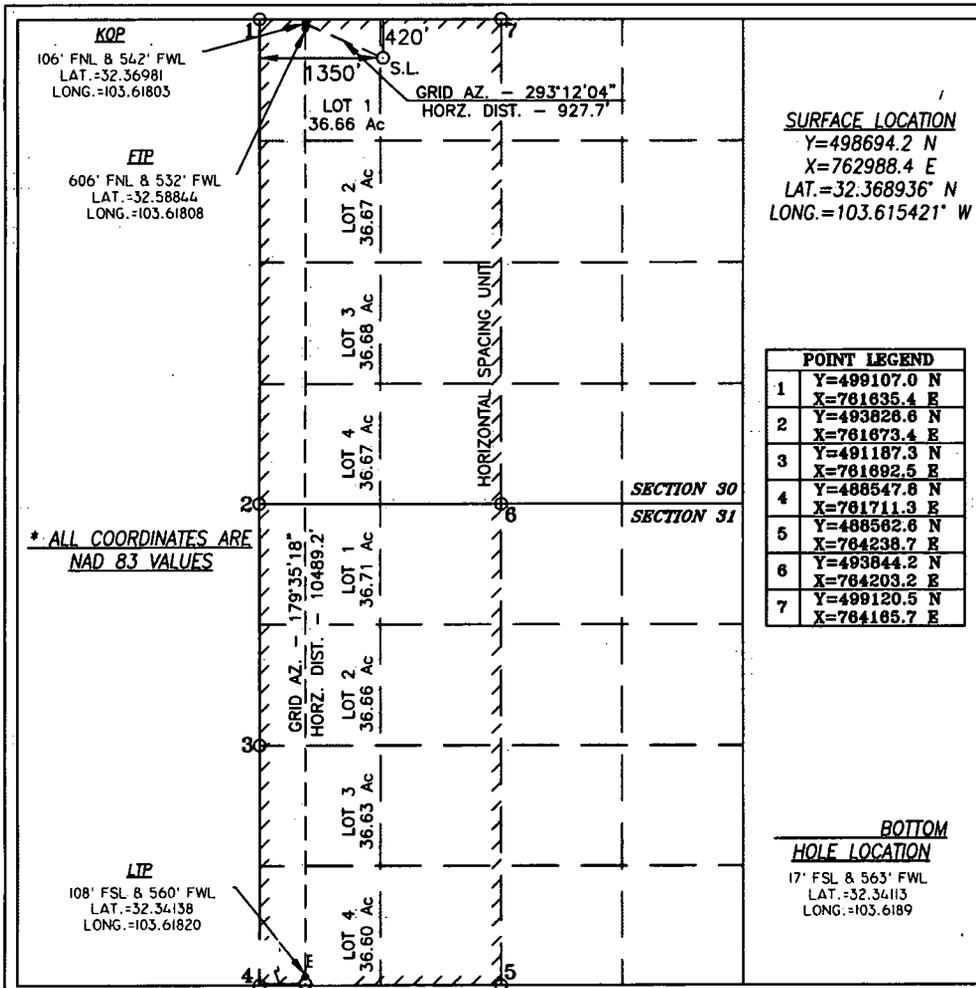

SURFACE LOCATION
Y=498694.2 N
X=762988.4 E
LAT.=32.368936° N
LONG.=103.615421° W

POINT LEGEND	
1	Y=499107.0 N X=761835.4 E
2	Y=493826.6 N X=761873.4 E
3	Y=491187.3 N X=761892.5 E
4	Y=488547.8 N X=761711.3 E
5	Y=488562.6 N X=764238.7 E
6	Y=493844.2 N X=764203.2 E
7	Y=499120.5 N X=764165.7 E

BOTTOM HOLE LOCATION
17' FSL & 563' FWL
LAT.=32.34113
LONG.=103.6189

OPERATOR CERTIFICATION
I hereby certify that the information herein is true and complete to the best of my knowledge and belief, and that this organization either owns a working interest or unleased mineral interest in the land including the proposed bottom hole location or has a right to drill this well at this location pursuant to a contract with an owner of such mineral or working interest, or to a voluntary pooling agreement or a compulsory pooling order heretofore entered by the division.

Signature: *R. Matheu* Date: 11/13/19
Printed Name: **RONI MATHEW**
E-mail Address: **RONI_MATHEW@OXY.COM**

SURVEYOR CERTIFICATION
I hereby certify that the well location shown on this plat was plotted from field notes of actual surveys made by me or under my supervision, and that the same is true and correct to the best of my belief.
Date of Survey: **MARCH 12, 2019**

Signature & Seal of Professional Surveyor
CHAD L. HARGROW
NEW MEXICO
LICENSED PROFESSIONAL SURVEYOR
17777
Chad Hargrow 4/4/19
Certificate No. **CHAD HARGROW 17777**
W.O. # 19-474 DRAWN BY: AM

HOBBS OCD
NOV 14 2019
RECEIVED

Intent As Drilled

API #
30-025-45924

Operator Name: OXY USA, INC	Property Name: AVOGATO 30-31 STATE COM	Well Number 21H
--------------------------------	---	--------------------

Kick Off Point (KOP)

UL	Section	Township	Range	Lot	Feet	From N/S	Feet	From E/W	County
D	30	22-S	33-E		106	N	542	W	LEA
Latitude					Longitude			NAD	
32.36981					-103.61803			83	

First Take Point (FTP)

UL	Section	Township	Range	Lot	Feet	From N/S	Feet	From E/W	County
D	30	22-S	33-E		606	N	532	W	LEA
Latitude					Longitude			NAD	
32.58844					-103.61808			83	

Last Take Point (LTP)

UL	Section	Township	Range	Lot	Feet	From N/S	Feet	From E/W	County
M	31	22-S	33-E		108	S	560	W	LEA
Latitude					Longitude			NAD	
32.34138					-103.61820			83	

Is this well the defining well for the Horizontal Spacing Unit?

Is this well an infill well?

If infill is yes please provide API if available, Operator Name and well number for Defining well for Horizontal Spacing Unit.

API #
30-025-45925

Operator Name: OXY USA, INC	Property Name: AVOGATO 30-31 STATE COM	Well Number 22H
--------------------------------	---	--------------------