

District I
1625 N. French Dr., Hobbs, NM 88240
Phone: (575) 393-6161 Fax: (575) 393-0720
District II
811 S. First St., Artesia, NM 88210
Phone: (575) 748-1283 Fax: (575) 748-9720
District III
1000 Rio Brazos Road, Aztec, NM 87410
Phone: (505) 334-6178 Fax: (505) 334-6170
District IV
1220 S. St. Francis Dr., Santa Fe, NM 87505
Phone: (505) 476-3460 Fax: (505) 476-3462

State of New Mexico
Energy, Minerals & Natural Resources
Department
OIL CONSERVATION DIVISION
1220 South St. Francis Dr.
Santa Fe, NM 87505

FORM C-102
Revised August 1, 2011
Submit one copy to appropriate
District Office

☐ AMENDED REPORT

WELL LOCATION AND ACREAGE DEDICATION PLAT

¹ API Number 30-025-46274	² Pool Code 59900	³ Pool Name TRIPLE X; BONE SPRING
⁴ Property Code 322743	⁵ Property Name YARROW 32 STATE	⁶ Well Number #203H
⁷ OGRID No. 7377	⁸ Operator Name EOG RESOURCES, INC.	⁹ Elevation 3672'

¹⁰Surface Location


UL or lot no.	Section	Township	Range	Lot Idn	Feet from the	North/South line	Feet from the	East/West line	County
0	32	23-S	33-E	-	453'	SOUTH	1607'	EAST	LEA



¹¹Bottom Hole Location If Different From Surface

UL or lot no.	Section	Township	Range	Lot Idn	Feet from the	North/South line	Feet from the	East/West line	County
B	32	23-S	33-E	-	110'	NORTH	1747'	EAST	LEA

¹² Dedicated Acres 320	¹³ Joint or Infill	¹⁴ Consolidation Code	¹⁵ Order No.
---	-------------------------------	----------------------------------	-------------------------

No allowable will be assigned to this completion until all interests have been consolidated or a non-standard unit has been approved by the division.

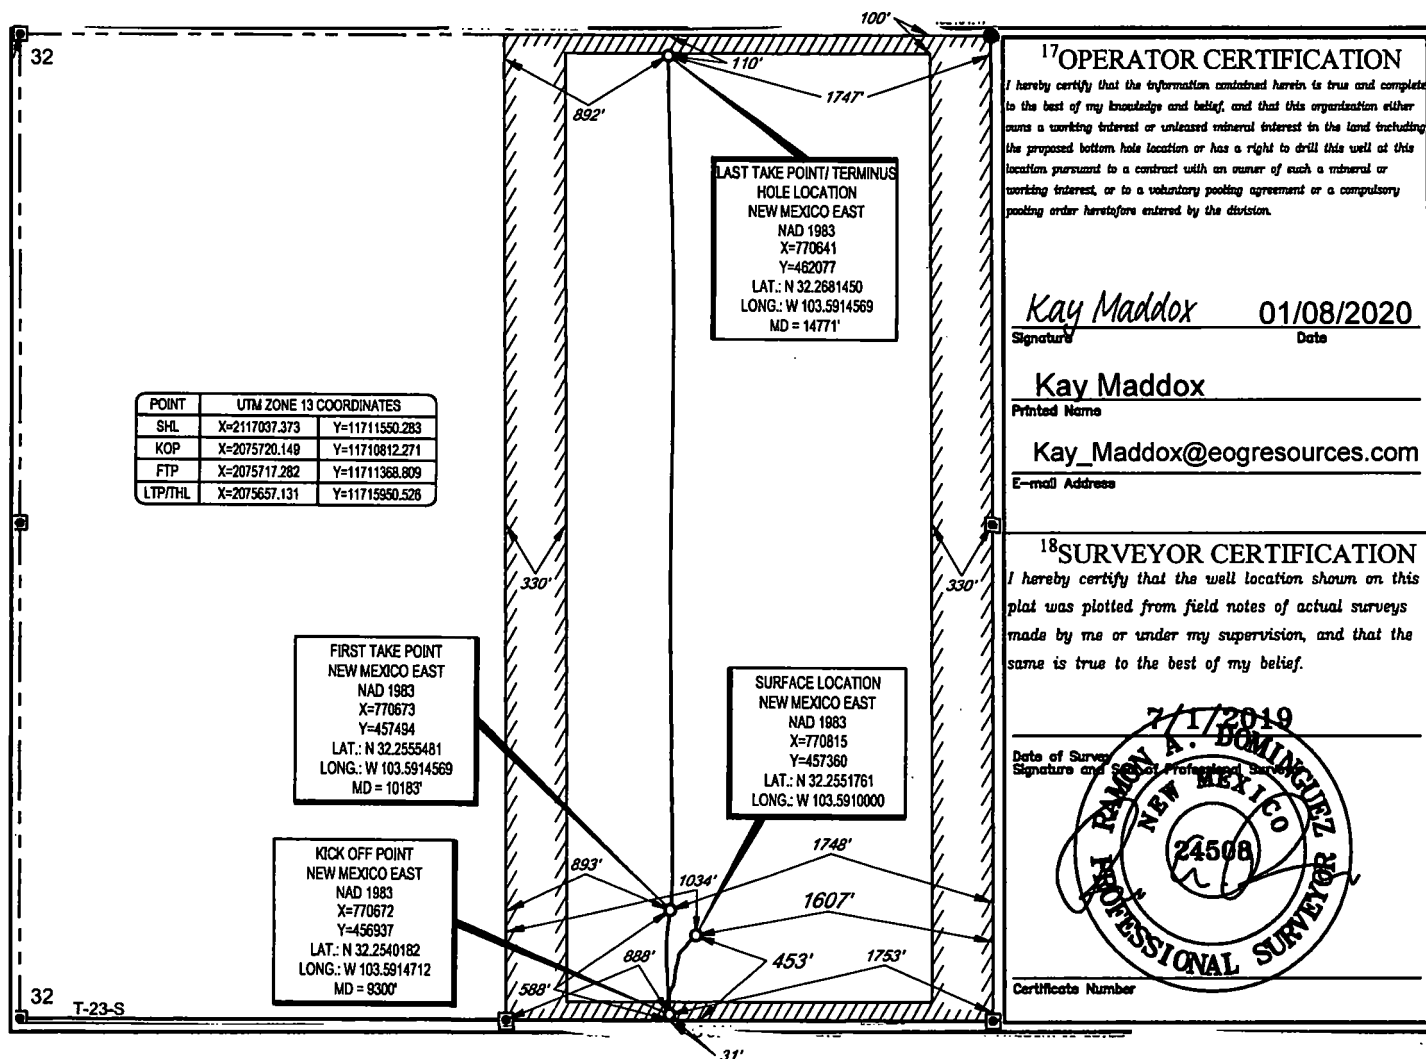

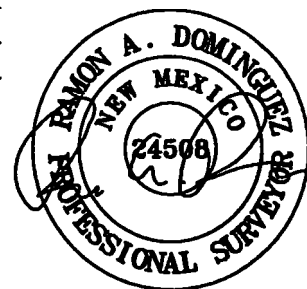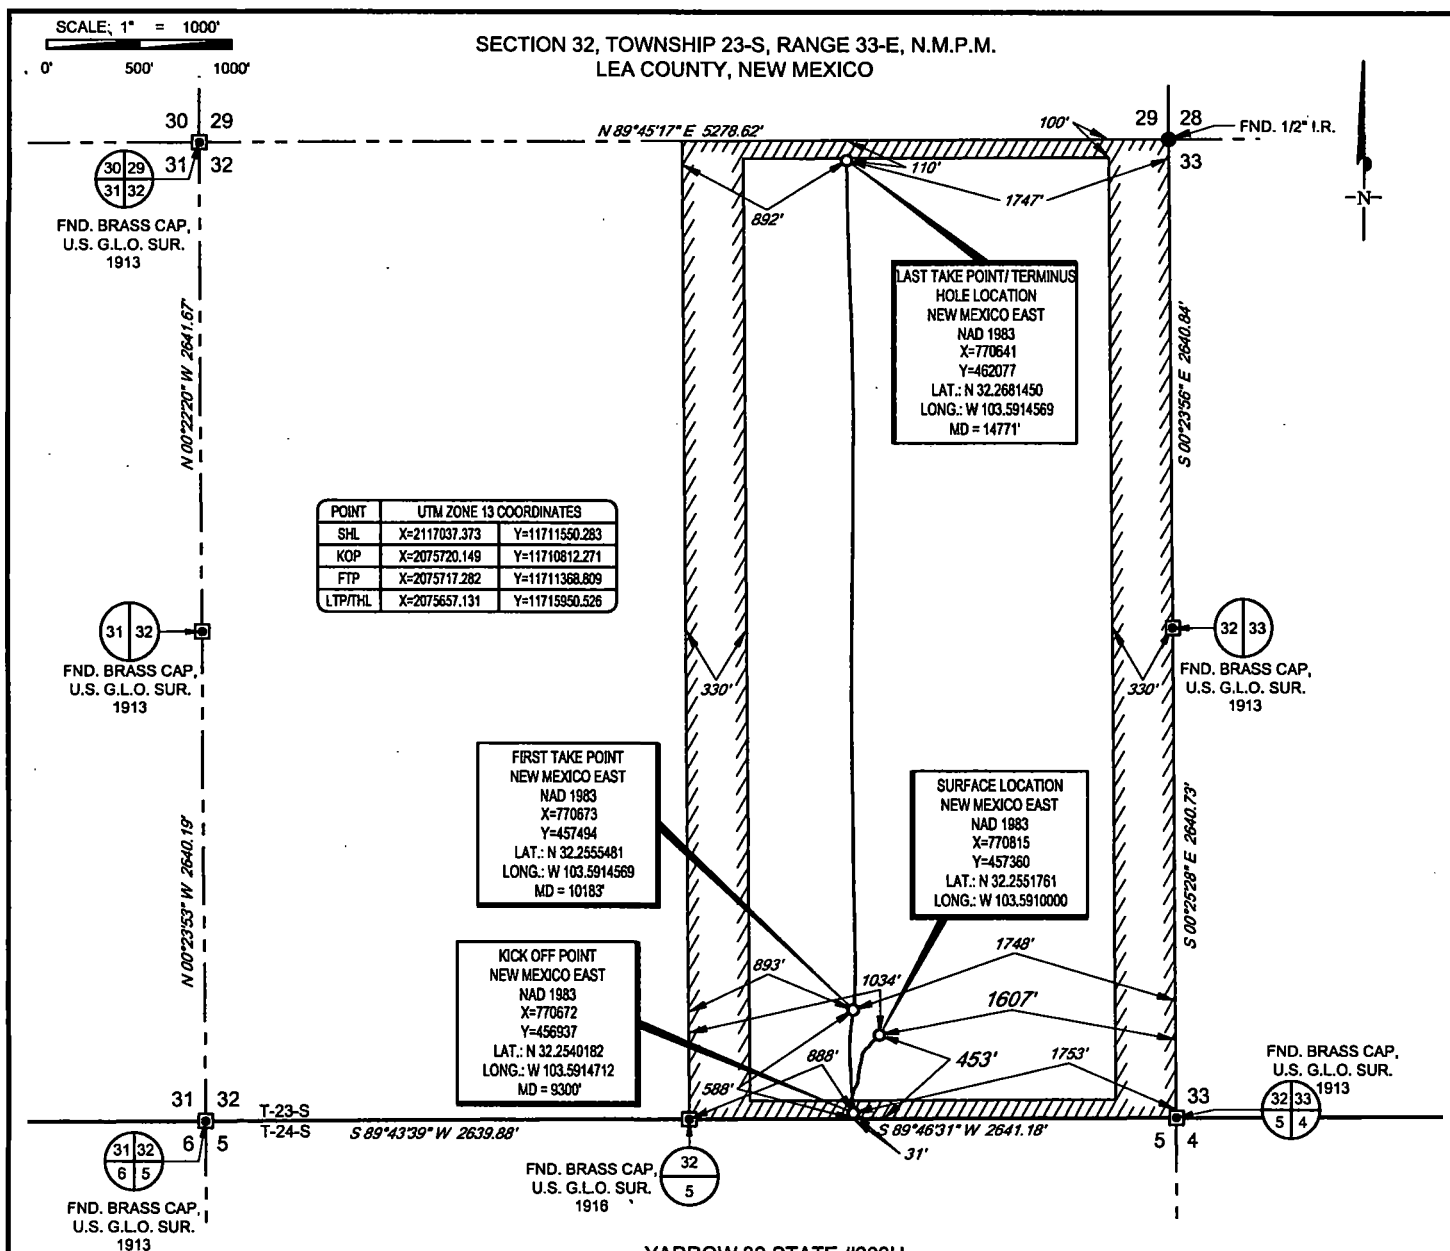

Ramon A. Dominguez, P.S. No. 24508
NOVEMBER 4, 2019



TOPOGRAPHIC
LOYALTY INNOVATION LEGACY
1400 EVERMAN PARKWAY, Ste. 148 • FT. WORTH, TEXAS 76140
TELEPHONE: (817) 744-7512 • FAX (817) 744-7554
2903 NORTH BIG SPRING • MIDLAND, TEXAS 79705
TELEPHONE: (432) 682-1853 OR (800) 787-1853 • FAX (432) 682-1743
WWW.TOPOGRAPHIC.COM

YARROW 32 STATE #203H AS-COMPLETE	REVISION:		NOTES: 1. ORIGINAL DOCUMENT SIZE: 8.5" X 11" 2. ALL BEARINGS, DISTANCES, AND COORDINATE VALUES CONTAINED HEREIN ARE GRID BASED UPON THE NEW MEXICO COORDINATE SYSTEM OF 1983, EAST ZONE, U.S. SURVEY FEET. 3. THIS WELL LOCATION SHOWN HEREON HAS BEEN SURVEYED ON THE GROUND UNDER MY SUPERVISION AND PREPARED ACCORDING TO THE EVIDENCE FOUND AT THE TIME OF SURVEY, AND DATA PROVIDED BY EOG RESOURCES, INC. THIS CERTIFICATION IS MADE AND LIMITED TO THOSE PERSONS OR ENTITIES SHOWN ON THE FACE OF THIS PLAT AND IS NON-TRANSFERABLE. THIS SURVEY IS CERTIFIED FOR THIS TRANSACTION ONLY.
DATE: 11/04/19			
FILE:AD_YARROW_32_STATE_203H			
DRAWN BY: TRG			
SHEET: 1 OF 1			

HOBBS OCD

JAN 09 2020

RECEIVEDIntent ☐ As Drilled ☒ XXXAPI #
30-025-46274

Operator Name: EOG RESOURCES, INC	Property Name: YARROW 32 STATE	Well Number 203H
--------------------------------------	-----------------------------------	---------------------

Kick Off Point (KOP)

UL O	Section 32	Township 23S	Range 33E	Lot	Feet 31	From N/S SOUTH	Feet 1753	From E/W EAST	County LEA
Latitude 32.2540182					Longitude 103.5914712			NAD 1983	

First Take Point (FTP)

UL O	Section 32	Township 23S	Range 33E	Lot	Feet 588	From N/S SOUTH	Feet 1748	From E/W EAST	County LEA
Latitude 32.2555481					Longitude 103.5914569			NAD 1983	

Last Take Point (LTP)

UL B	Section 32	Township 23S	Range 33E	Lot	Feet 110	From N/S NORTH	Feet 1747	From E/W EAST	County LEA
Latitude 32.2681450					Longitude 103.5914569			NAD 1983	

Is this well the defining well for the Horizontal Spacing Unit? ☒ NOIs this well an infill well? ☐ YES

If infill is yes please provide API if available, Operator Name and well number for Defining well for Horizontal Spacing Unit.

API #
30-025-46273

Operator Name: EOG RESOURCES, INC	Property Name: YARROW 32 STATE	Well Number #202H
--------------------------------------	-----------------------------------	----------------------

KZ 06/29/2018