Submit 3 Copies To Appropriate District	State of New M			Form C-103	
Office District I	Energy, Minerals and Natu	ral Resources		May 27, 2004	
1625 N French Dr., Hobbs, NM 87240			WELL API NO.		
District II	OIL CONSERVATION	N DIVISION	30-025-28629		
1301 W Grand Ave., Artesia, NM 88210 District III	1220 South St. Fra	ancis Dr.	5. Indicate Type of Lease	_ 1	
1000 Rio Brazos Rd, Aztec, NM 87410	Santa Fe, NM 8	37505	STATE 🚾 🖊 FI	EE 🗌	
District IV 1220 S. St. Francis Dr., Santa Fe, NM 87505	•		6. State Oil & Gas Lease N B-9560	0.	
SLINDRY NOTICE	ES AND REPORTS ON WE	118	7. Lease Name or Unit Agr	eament Name:	
(DO NOT USE THIS FORM FOR PROPO DIFFERENT RESERVOIR. USE "APPLIC, PROPOSALS.)	SALS TO DRILL OR TO DEEP	THE PUE BACKTON	N.M. BG STATE NCT-2	Coment Ivanic.	
1. Type of Well: / Oil Well X Gas Well	Other	FEB 19 Zuid	8. Well Number		
2. Name of Operator		OBBSOCD -	9. OGRID Number		
· •	C. ATTN: Don Rober	+-	ス・31	90	
CROWNQUEST OPERATING, L.L.(. ATTN: DON RODER	LS .	10. Pool name or Wildcat		
3. Address of Operator	E100 Midland III 70707				
303 Veterans Airpark Ste. 94. Well Location	5100, Midland, 1X /9/0/		Saunders Permo Upper E	enn	
4. Well Education					
Unit Letter G:	2310 feet from the NO	RTH line and	2,309' feet from the	<u>EAST</u> line	
Section 16	Township 14-S		NMPM Count	ty LEA	
	11. Elevation (Show whether	DR, RKB, RT, GR, et	c.)		
Pit or Below-grade Tank Application	or Closure		_		
Pit type STEEL Depth to Groundwater _	Distance from nearest fres	h water well Dis	tance from nearest surface water		
Pit Liner Thickness: STEEL mil	Below-Grade Tank: Volume	bbls; Construction	on Material STEEL		
NOTICE OF INTE		SUB	Report, or Other Data	OF:	
PERFORM REMEDIAL WORK	PLUG AND ABANDON 🗓	REMEDIAL WORK	☐ ALTE	RING CASING 🔲	
TEMPORARILY ABANDON	CHANGE PLANS	COMMENCE DRILLI	ING OPNS. 🔲 🗸 PLUG	S AND IDONMENT	
PULL OR ALTER CASING	MULTIPLE COMPLETION	CASING TEST AND CEMENT JOB		, SO, WILLIAM	
OTHER:		OTHER:			
13. Describe proposed or completed of starting any proposed work). or recompletion.					
1. M.I.R.U. N.D.W.H. N.U.	B.O.P.				
		<i>_</i> ,0			
3. Cap B.P. w/30 sx. cmt.	T.O.C. & calculate - 9.4	120' MOC-1849			
2. C.I.B.P. @9,717'. Run 3. Cap B.P. w/30 sx. cmt. 4. 7,765'- 7,600' - 25 sx	cmt. 5. 6-999'-6,700' -	- 25 sx. cmt. 6. 5,	560' - 5,400' - 25 sx.	cmt. 7.	
4,240'-3,800'. 8 5/8 shoe	- 50 sx. cmt. W.O.C. & t	ag. 8. 3,200' to 2	2,800' - 45 sx. cmt. 9.	2,635' to	
2,400' - 30 sx. cmt sal					
12. Make sure cement stays					
_	_				
I haraby cartify that the information of	paya is true and complete to the	host of my knowledge	and haliaf III day at a		
I hereby certify that the information ab grade tank has been/will be constructed or cl					
SIGNATURE COMPANY	, ,,,,,,	TLE P&A	A SUPV. DATE	2-17-10	
Type or print name RANDALL MINEAR		mail address:	Telephone No) .	
For State Use Only	· // · //	DISTRICT 1	8UPERVISOR	FEB 1 9 2010	
APPROVED BY Juny M	7. Lell TI	TLE			
Conditions of Approval, if any		I DE	DATE_		

2-175-28/20

NDITIONS OF APPROVAL, IF ANY	5 Inspector	TITLE		F	EB 28 1984	
Eddie	W. Seay				4004	
(This space for State	Use)	Title Ass't. Pet	roluem Eng.	Mgr. Date 2	-24-84	
aned Al Lane	wae and comple	ete to the best of my know	ledge and belief.			
ABOVE SPACE DESCRIBE PROPOSE ZONE. GIVE BLOWOUT PREVENTER PROPOSE CONTRACTOR AND	pove is true and come!	TO DEEPEN OR P	LUG BACK, GIVE DATA ON	PRESENT PRODUCTIVE Z	ONE AND PROPOSED NEW PRODUC.	
2ND STAGE:	1200 sxs HLV	7 200 sxs 50- 3, 1.40 ft³/s: 7 w/1/4# floc	x). DV Tool	set at 70(00. Trocete &	
.8% HALAD-9/s	rollowed by sx (13.6 pm	7 200 sxs 50-	50 Pozmix C]	ዓ∦ Ilocele ass "H" ឃ/	/sx (12.3 ppg, 1/4# flocele &	
3. PRODUCTION CARRY $\frac{2.00 \text{ ft}}{3.000}$	ASING: 1ST	STAGE: 750	SXS HIM ta/1	//.#`£1	/sx (12.3 ppg,	
•			•	/	or (13.0 ppg,	
$2.10 \text{ ft}^3/\text{sx}$	followed b	y 200 sxs HLW $_{\rm W}$	7/15# salt & .ss "H" 11 /1/	1/4# floce	.18 ft ³ /sx). le/sx (12.7 ppg, sx (15.6 ppg,	
2. INTERMEDIATE	CASING: 1	800 ave uv.	/1-"	ppg, 1 o.c.	.18 ft^3/sx).	
1. SURFACE CASI	NG: 600 sx	s Class "H" v	7/2% CaCl (15 6		
_		17#, K-55	10,000'	2150	Circulate	
. 7 7/8"	5월''	17#, N-80	10 0001			
!		28#, S-80	1			
		24#, K-35 24#, S-80	4200'	2000	Circulate	
12程"	8 5/8"	24#, K-55	525'	600	Circulate	
17½"	13 3/8"	WEIGHT PER FOOT 48#, H-40		SACKS OF CEME	EST. TOP	
SIZE OF HOLE	SIZE OF CASING	PROPOSED CASING AND	Т		,	
		PROPOSED CASING AND	CENEVE	M	arch 1-5, 1984	
4220' GR.		1 10g. Dond 2	IB, Drilling Contractor	22.	Approx. Date Work will start	
21. Elevations (Show whether DF, 1	RT; etc.) 21A. Kin	d & Status Plug. Bond 2	10,000	Permo Uppe	r Penn Rotary	
		<i>!!!!!!!!!!!</i>	9. Proposed Depth	19A. Formation		
AHHHHHH					WHHHIPTIMIT	
HHHHHH	HHHHH	4444444		12. 0	Lea	
		THE OF SEC. 10	TWP. 14-S RGE. 3			
AND 2309 FEET FROM	Tr 4-			(///		
UNIT LETTER G LOCATED 2310 MONTH				th l	Upper Penn	
Box 3109 Midland, Texas 79702					ith de fs'. Pe'imo	
3. Address of Operator	THE.			9. W	eii No.	
2. Name of Operator Texaco			ZONE X	Ne Zone Ne	w Mexico BG St.NCT-	
OIL X GAS WELL	O HER	··· <u></u>			urm or Lease Name	
b. Type of Well DRILL X]	DEEPEN	p. .		nit Agreement Name	
la. Type of Work	- TOK TERMIT	TO DRILL, DEEPEN	OR PLUG BACK			
APPLICATION	ON FOR PERMIT	TO DRILL, DEEPEN			111111111111111111111111111111111111111	
OPERATOR				.5. \$	tate Oil & Gas Lease No. B-9560	
LAND OFFICE		-		j	STATE X FEE	
FILE U.S.G.S.					Indicate Type of Lease	
SANTA FE		IEW MEXICO OIL CON		: 0-101		
NO. OF COPIES RECEIVED				-	-020-28629	
				-		

APPROVAL VALID FOR 180 DAYS
PERMIT EXPIRES 8/28/84
UNLESS DRILLING UNDERWAY

STATE OF NEW MEXICO ENERGY AND MINERALS DEPARTMENT

CONSERVATION DIVISION P. O. BOX 2088

SANTA FE, NEW MEXICO 87501


Form C-102

All distances must be from the outer houndaries of the Section. Operator Legse New Mexico "BG" State NCT-2 3 Texaco Inc Unit Letter County 1.6 14-S 33-E Lea Actual Fastage Location of Well; 2310 North 2309 feet from the line and East feet from the Ground Level Clev. Producing Formation Dedicated Acreage: 4220' Permo Upper Penn Saunders Permo Upper Penn 1. Outline the acreage dedicated to the subject well by colored pencil or hachure marks on the plat below. 2. If more than one lease is dedicated to the well, outline each and identify the ownership thereof (both as to working interest and royalty). 3. If more than one lease of different ownership is dedicated to the well, have the interests of all owners been consolidated by communitization, unitization, force-pooling, etc? If answer is "yes," type of consolidation ☐ Yes ∏ No If answer is "no," list the owners and tract descriptions which have actually been consolidated. (Use reverse side of this form if necessary.)_ No allowable will be assigned to the well until all interests have been consolidated (by communitization, unitization, forced-pooling, or otherwise) or until a non-standard unit, eliminating such interests, has been approved by the Division. CERTIFICATION I hereby certify that the Information comtained herein is true and complete to the best of my knowledge and belief. Bethel L. Eiland Position Division Surveyor Company Texaco Inc. 3 February 23, 1984. I hereby certify that the well location shown on this plat was platted from field notes of octual surveys made by me or under my supervision, and that the same is true and correct to the best of my knowledge and belief. 1370 1650 1040 2310 2640

1300

1000

500

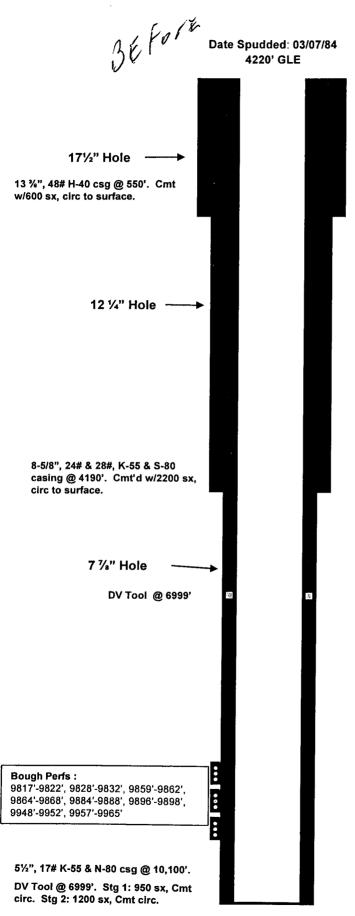


TD: 10,100' PBTD: 10,070'

Drawn by: DLR, 2/10



2

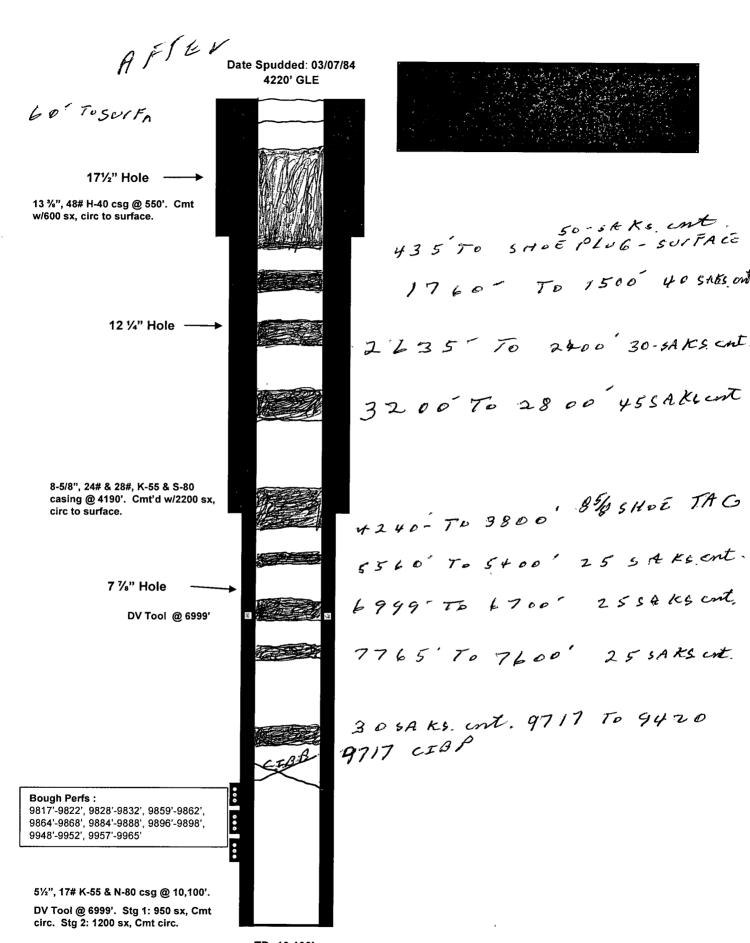

TD: 10,100' PBTD: 10,070'

Drawn by: DLR, 2/10