
Office	ate of New Mexico	Form C-103
	inerals and Natural Resources	October 13, 2009 WELL API NO.
1625 N. French Dr., Hobbs, N. M. S. C. D. District II	ACEDIA MICONEDIA MONONE	30-025-40149
1301 W. Grand Ave., Artesia, NM 88210 OIL CON	ISERVATION DIVISION	5. Indicate Type of Lease
1000 Die Despar Dd Astack AMA 1920 W	South St. Francis Dr.	STATE X FEE
District IV	anta Fe, NM 87505	6. State Oil & Gas Lease No.
1220 S. St. Francis Dr., Santa Fe, NM 87505		
SUNDRY NOTICES AND REPO	RTS ON WELLS	7. Lease Name or Unit Agreement Name
(DO NOT USE THIS FORM FOR PROPOSALS TO DRILL OR		Aquamarine State
DIFFERENT RESERVOIR. USE "APPLICATION FOR PERMI PROPOSALS.)	11 (FORM C-101) FOR SUCH	0. W. H.V 1
	ther	8. Well Number 3
2. Name of Operator ConocoPhillips Company		9. OGRID Number 217817
		10. Pool name or Wildcat
3. Address of Operator 3300 N "A" St, Bldg 6 Midland, TX 79705		Maljamar; Yeso, West
4. Well Location		
	om the South line and 820	
	ship 17S Range 32E	NMPM CountyLea
	Show whether DR, RKB, RT, GR, etc.,	
4016' Gr		[18] 《 <b>尼</b> 斯· <b>阿</b> 斯·
12 Check Appropriate Bo	x to Indicate Nature of Notice,	Report or Other Data
11 1	,	•
NOTICE OF INTENTION TO		SEQUENT REPORT OF:
PERFORM REMEDIAL WORK ☐ PLUG AND ABATEMPORARILY ABANDON ☐ CHANGE PLAN		<del></del>
PULL OR ALTER CASING MULTIPLE CON		<del></del>
DOWNHOLE COMMINGLE	WITE DAGING/GENIEN	. 1005
OTHER:	OTHER: New Sur	
13. Describe proposed or completed operations.		
of starting any proposed work). SEE RULE proposed completion or recompletion.	19.15./.14 NMAC. For Multiple Col	mpletions: Attach wellbore diagram of
• • • •	let and survey with incorpor footogo	
*Attached new plat and survey to replace former pl	at and survey with incorect footages.	
	<u></u>	
Spud Date:	Rig Release Date:	
	L	
		11.11.0
I hereby certify that the information above is true and	complete to the best of my knowledg	e and belief.
$\supset$ $\Lambda$		
SIGNATURE 5' 1	TITLE Regulatory Specialist	DATE_05/25/2011
Town as maintained Ballon B. Maintain	Tomail addison but 1	Occupantifica PHONE (420)(200 (2012)
Type or print name Brian D Maiorino For State Use Only	E-mail address: brian.d.maiorino	@conocophilips.PHDNE: (432)688-6913
Tot State Ose Only	PPPAL SHA BHALAM	MAY 2 7 2011
APPROVED BY:	TITLE TETROLEGIA BROWEE	DATE
Conditions of Approval (ff any):		

NORTHERLY VIEW TO LOCATION STAKE

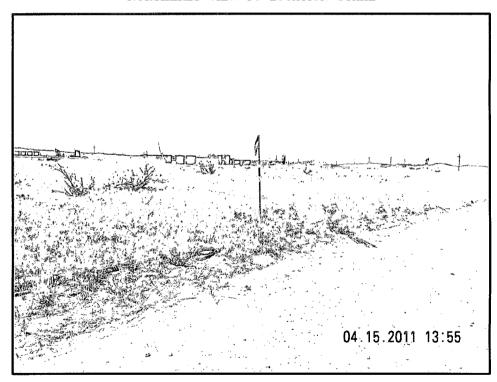

WESTERLY VIEW TO LOCATION STAKE

# ConocoPhillips

#### **AQUAMARINE STATE #3**

Located 330' FSL & 820' FEL, Section 16 Township 17 South, Range 32 East, N.M.P.M. Lea County, New Mexico

WEST COMPANY of Midland, Inc.

110 W. LOUISIANA, STE. 110 MIDLAND TEXAS, 79701 (432) 687-0865 - (432) 687-0868 FAX

Drawn By: KHY

Date: May 24, 2011

DISTRICT I 1625 N. French Dr., Hobbs, NM 88240

M 88240

HOBBS OCD

DISTRICT II 1301 W. Grand Avenue, Artesia, NM 88210

DISTRICT III
1000 Rio Brazos Rd., Axtec, NM 87410

Energy, Minerals & Natural Resources Department
OIL CONSERVATION DIVISION

State of New Mexico

Form C-102
Revised October 12, 2005
Submit to Appropriate District Office
State Lease - 4 Copies
Fee Lease - 3 Copies

OIL CONSERVATION DIVISION 1220 South St. Frances Dr. Santa Fe, NM 87505

☐ AMENDED REPORT

DISTRICT IV 1220 S. St. Francis Dr., Santa Fe, RESTREED

#### WELL LOCATION AND ACREAGE DEDICATION PLAT

API N	lumber			Pool Code	بد ا	1stiamaa	Pool Name	1-cL	
Property Co	ode	<u> </u>	445	00	Property Nam	A JAMAA	yaso, w	Well Num	ber
38238					AQUAMARINE	STATE		3	
OGRID No.	•				Operator Nam			Elevation	
21781	7				CONOCOPHIL	LIPS		401	6′
					Surface Loca	ation			
UL or lot No.	Section	Townshi	p Range	Lot Idn	Feet from the	North/South line	Feet from the	East/West line	County
Р	16	17 5	32 E		330	SOUTH	820	EAST	LEA
			Bottom	Hole Lo	cation If Diffe	erent From Sur	face		•
UL or lot No.	Section	Townshi	p Range	Lot Idn	Feet from the	North/South line	Feet from the	East/West line	County
D-W-4-3 4	7-1-4	7_411	Consolidation	3-4- 0	den Ne				
Dedicated Acres	Joint or	. IPUII	Consolidation (	Code   O	rder No.				
								GOLIGOT TO A MIN	
NO ALLOWAE	BLE WILL					IL ALL INTERES		CONSOLIDATE	D OK .
					İ		OPERAT	OR CERTIFICA	TION
								formation contained herein is tr	
								and belief, and that this organized and mineral interestin the land inc	
	ļ						bottom hale location or has	a right to drill this well at this i	ocation pursuan
								r of such a mineral or working	
							the division.	t or a compulsory pooling order h	rresojore ensered
	ļ						11 .		
								6/0	× /
							11 5-1	1: 5/2 Date	5/11
							Signature	Date	
							II Rojand	) Aladia	
	ļ						Printed Nam	e A Tarana	
	ļ								
							SURVEY	OR CERTIFICA	TION
· · · · · · · · · · · · · · · · · · ·						<u> </u>	I hereby certify	that the well locat	ion showr
							11	is plotted from field	
					<u> </u>			made by me or	
-							11 -	d that the same is e best of my belie	
							Ар	The State of the same of the s	Alpin
		r				<del> </del>	Date of Surve	ME eal of Professional	KH
					ļ	Plane Coordinate	J. S.	注:マ/ `	\ O: \ \ \ \ \ \ \ \ \ \ \ \ \ \ \ \ \ \
	}					X = 674,572.2 Y = 665,465.2		(12185	) <u>*                                   </u>
NOTE:					ŧ		# ( <i>////</i>		
1) Plane Coordin					4016 	5.3′4017.6′	X	CPS CONTRACTOR	· ::::::::::::::::::::::::::::::::::::
Coordinate Sy	⁄stem", New	/ Mexico E	ne "New Mexico ast Zone, North		ŧ.	g   9	- W.O. N	um?/2014 #05	27,,,,,
American Datu mean horizont			shown hereon are		β3 <sup>1</sup>	<u></u>	Certificate No	. MACON McDONAL	1218
				L	4,010	5.8' <sub>(1</sub>   1,4009.2' 1	L		


SECTION 16, TOWNSHIP 17 SOUTH, RANGE 32 EAST, N.M.P.M.

LEA COUNTY

THIS IS NOT A BOUNDARY SURVEY

Apparent property corners and property lines, if shown,
are for information only.

**NEW MEXICO** 

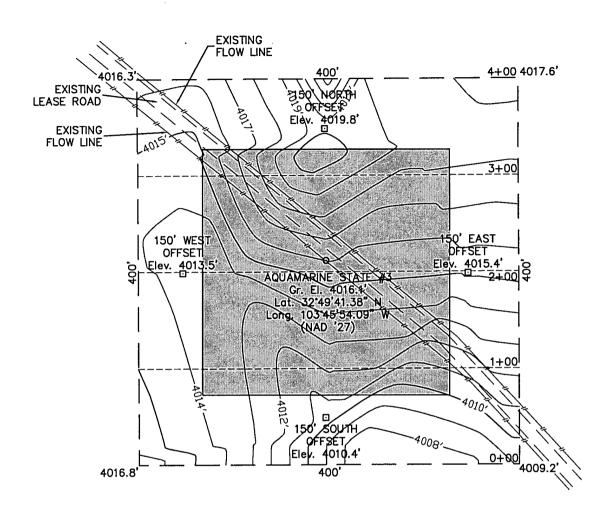

#### DRIVING DIRECTIONS

FROM THE INTERSECTION OF STATE HIGHWAY 82 AND COUNTY ROAD IN MALJAMAR, NM. GO SOUTH ON SAID COUNTY ROAD 126 2.0 MILES TO A LEASE ROAD ON WEST (RIGHT) SIDE OF ROAD, THEN GO WEST 0.1 MILE, THEN GO NORTHWEST (RIGHT) 0.1 MILE TO THE PROPOSED LOCATION


HEN GU NORTHWEST (NIGHT) OF THE PROPOSED LOCATION.

I HEREBY CERTIFY THAT THIS PLAT WAS MADE FROM AN ACTUAL SURVEY MADE BY ME OR UNDER MY DIRECT SUPERVISION AND THAT THE SAME IS TRUE AND CORRECT TO THE BEST OF MY KNOWLEDGE AND BELIEF.

MACON McDONALD RLS NO. 12185

WEST COMPANY of Midland, Inc.

110 W. LOUISIANA, STE. 110 MIDLAND TEXAS, 79701 (432) 687-0865 - (432) 687-0868 FAX

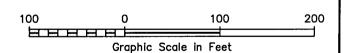

### ConocoPhillips

Topographic Map

#### **AQUAMARINE STATE #3**

Located 330' FSL & 820' FEL, Section 16
Township 17 South, Range 32 East, N.M.P.M.
Lea County, New Mexico


Drawn By: KHY	Date: May 24, 2011
Scale: 1" = 100'	Field Book: 518 / 8-10
Sheet 1 of 3	Quadrangle: Maljamar
W.O. No: 2011-0527	Dwg. No.: L-2011-0527-A

SECTION 16, TOWNSHIP 17 SOUTH, RANGE 32 EAST, N.M.P.M.

LEA COUNTY

THIS IS NOT A BOUNDARY SURVEY
Apparent property corners and property lines, if shown,
are for information only.

**NEW MEXICO** 

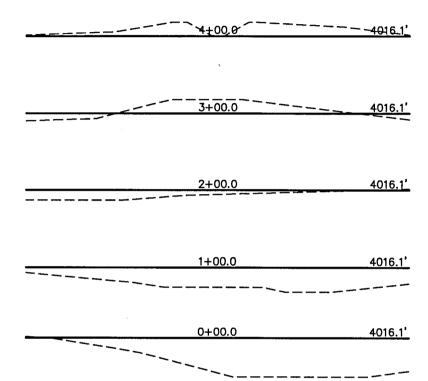

I HEREBY CERTIFY THAT THIS PLAT WAS MADE FROM AN ACTUAL SURVEY MADE BY ME ORFUNDER MY DIRECT SUPERVISION AND THAT THE SAME IS TRUE AND CORRECT TO THE BEST OF MY KNOWLEDGE AND BELIEF.


MACON McDONALD (12185)

MACON McDONALD (12185)

MACON McDONALD (12185)

WEST COMPANY of Midland, Inc.

110 W. LOUISIANA, STE. 110 MIDLAND TEXAS, 79701 (432) 687-0865 - (432) 687-0868 FAX

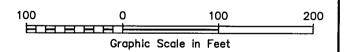

## ConocoPhillips

Topographic Map

### **AQUAMARINE STATE #3**

Located 330' FSL & 820' FEL, Section 16
Township 17 South, Range 32 East, N.M.P.M.
Lea County, New Mexico


Drawn By: KHY	Date: May 24, 2011
Scale: 1" = 100'	Field Book: 518 / 8-10
Sheet 2 of 3	Quadrangle: Maljamar
W.O. No: 2011-0527	Dwg. No.: L-2011-0527-B

SECTION 16, TOWNSHIP 17 SOUTH, RANGE 32 EAST, N.M.P.M.

LEA COUNTY

THIS IS NOT A BOUNDARY SURVEY
Apparent property corners and property lines, if shown,
are for information only.

**NEW MEXICO** 

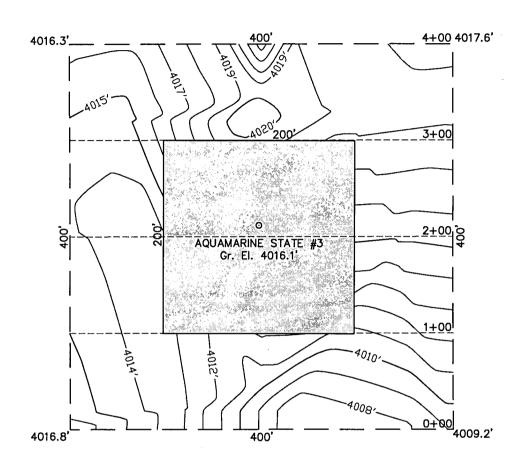


#### INTERIM RECLAMATION

I HEREBY CERTIFY THAT THIS PLAT WAS, MADE FROM AN ACTUAL SURVEY MADE BY ME OR UNDER MY DIRECT SUPERVISION AND THAT THE SAME IS TRUE, AND CORRECT TO THE BEST OF MY KNOWLEDGE AND BELIEF.

MACON McDONALD PROFESSIONIA RES NO. 12185



110 W. LOUISIANA, STE. 110 MIDLAND TEXAS, 79701 (432) 687-0865 - (432) 687-0868 FAX

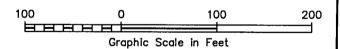

### ConocoPhillips


Topographic Map

#### **AQUAMARINE STATE #3**

Located 330' FSL & 820' FEL, Section 16
Township 17 South, Range 32 East, N.M.P.M.
Lea County, New Mexico

Drawn By: KHY	Date: May 24, 2011
Scale: 1" = 100'	Field Book: 518 / 8-10
Sheet 3 of 3	Quadrangle: Maljamar
W.O. No: 2011-0527	Dwg. No.: L-2011-0527-C

### LOCATION VERIFICATION MAP

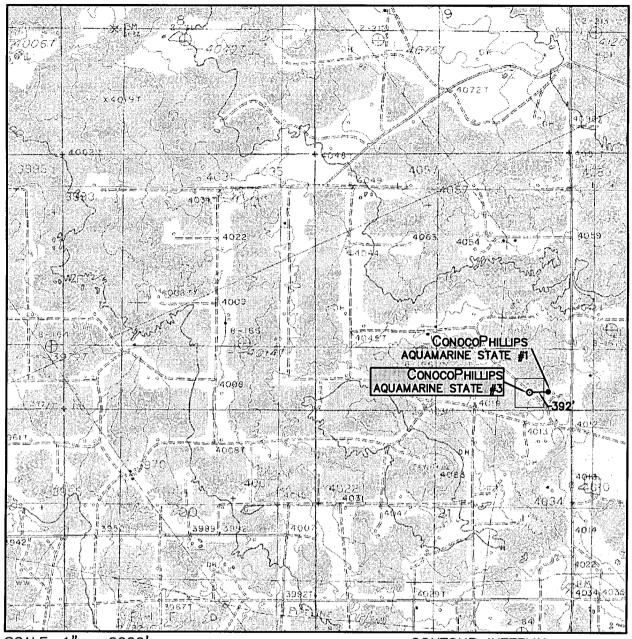

SCALE: 1" = 2000

CONTOUR INTERVAL: MALJAMAR - 10'

SEC. <u>16</u> TWP. <u>17-S</u> RGE. 32-E
---

SURVEY N.M.P.M.

LEA

COUNTY

DESCRIPTION 330' FSL & 820' FEL

ELEVATION 4016'

OPERATOR CONOCOPHILLIPS

LEASE AQUAMARINE STATE

U.S.G.S. TOPOGRAPHIC MAP

MALJAMAR



WEST


COMPANY

110 W. LOUISIANA, STE. 110

MIDLAND TEXAS, 79701

of Midland, Inc. (432) 687–0865 – (432) 687–0868 FAX

### VICINITY MAP

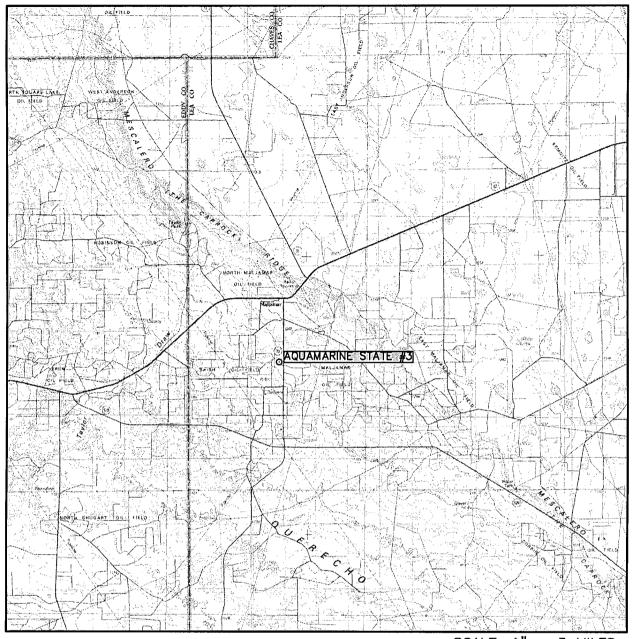

SCALE: 1" = 3 MILES

SEC. 16 TWP. 17-S RGE. 32-E SURVEY N.M.P.M. COUNTY LEA DESCRIPTION 330' FSL & 820' FEL ELEVATION 4016' OPERATOR CONOCOPHILLIPS LEASE AQUAMARINE STATE



WEST

COMPANY

110 W. LOUISIANA, STE. 110

MIDLAND TEXAS, 79701

of Midland, Inc. (432) 687–0865 – (432) 687–0868 FAX