

NO. OF COPIES RECEIVED	
DISTRIBUTION	
SANTA FE	
FILE	
U.S.G.S.	
LAND OFFICE	
OPERATOR	

# NEW MEXICO OIL CONSERVATION COMMISSION

Form C-101  
Revised 1-1-65

5A. Indicate Type of Lease	
STATE <input checked="" type="checkbox"/>	FEE <input type="checkbox"/>
5. State Oil & Gas Lease No.	
00-1318	
7. Unit Agreement Name	
8. Farm or Lease Name	
CABOT STATE	
9. Well No.	
2	
10. Field and Pool, or Wildcat	
Undes. North Bagley	
12. County	
Lea	
19. Proposed Depth	19A. Formation
10,300	Lower Penn
20. Rotary or C.T.	
Rotary	
21. Elevations (Show whether DF, RT, etc.)	21A. Kind & Status Plug. Bond
4242.7	Blanket
21B. Drilling Contractor	22. Approx. Date Work will start
Moran Drilg. Co.	4/2/68

## APPLICATION FOR PERMIT TO DRILL, DEEPEN, OR PLUG BACK

1a. Type of Work	
DRILL <input checked="" type="checkbox"/> DEEPEN <input type="checkbox"/> PLUG BACK <input type="checkbox"/>	
b. Type of Well	
OIL WELL <input checked="" type="checkbox"/>	GAS WELL <input type="checkbox"/> OTHER <input type="checkbox"/>
2. Name of Operator	
Meadco Properties Ltd	
3. Address of Operator	
c/o Oil Reports & Gas Services, Box 763, Hobbs, New Mexico	
4. Location of Well	
UNIT LETTER D	LOCATED 660 FEET FROM THE North LINE
AND 510 FEET FROM THE West LINE OF SEC. 14	TWP. 11S RGE. 33E NMPM
19. Proposed Depth	
10,300	
19A. Formation	
Lower Penn	
20. Rotary or C.T.	
Rotary	
21. Elevations (Show whether DF, RT, etc.)	21A. Kind & Status Plug. Bond
4242.7	Blanket
21B. Drilling Contractor	22. Approx. Date Work will start
Moran Drilg. Co.	4/2/68

23.

## PROPOSED CASING AND CEMENT PROGRAM

SIZE OF HOLE	SIZE OF CASING	WEIGHT PER FOOT	SETTING DEPTH	SACKS OF CEMENT	EST. TOP
17 1/2	13 3/8	48#	375	Circ.	
11	8 5/8	24#	3750	400	2200
7 7/8	4 1/2	11.6#	10,300	300	9000

THE COMMISSION MUST BE NOTIFIED  
24 HOURS PRIOR TO RUNNING 13 3/8  
CASING

APPROVAL VALID  
FOR 90 DAYS UNLESS  
DRILLING COMMENCED

7-1-68

IN ABOVE SPACE DESCRIBE PROPOSED PROGRAM: IF PROPOSAL IS TO DEEPEN OR PLUG BACK, GIVE DATA ON PRESENT PRODUCTIVE ZONE AND PROPOSED NEW PRODUCTIVE ZONE. GIVE BLOWOUT PREVENTER PROGRAM, IF ANY.

I hereby certify that the information above is true and complete to the best of my knowledge and belief.

Signed Donna Holler Title Agent Date 4/1/68

(This space for State Use)

APPROVED BY [Signature] TITLE Agent DATE 1968

CONDITIONS OF APPROVAL, IF ANY:

**NEW MEXICO OIL CONSERVATION COMMISSION  
WELL LOCATION AND ACREAGE DEDICATION PLAT**

Form C-102  
Supersedes C-128  
Effective 1-1-65

All distances must be from the outer boundaries of the Section.


Operator <b>MEADCO PROPERTIES, LTD.</b>			Lease <b>CABOT STATE</b>		Well No. <b>2</b>
Unit Letter <b>D</b>	Section <b>14</b>	Township <b>11 SOUTH</b>	Range <b>33 EAST</b>	County <b>LEA</b>	
Actual Footage Location of Well: <b>510</b> feet from the <b>WEST</b> line and <b>660</b> feet from the <b>NORTH</b> line					
Ground Level Elev. <b>4242.7</b>	Producing Formation <b>Lower Penn</b>		Pool <b>Undes. North Bagley</b>	Dedicated Acreage: <b>80</b> Acres	

1. Outline the acreage dedicated to the subject well by colored pencil or hachure marks on the plat below.
2. If more than one lease is dedicated to the well, outline each and identify the ownership thereof (both as to working interest and royalty).
3. If more than one lease of different ownership is dedicated to the well, have the interests of all owners been consolidated by communitization, unitization, force-pooling, etc?

☐ Yes    ☐ No    If answer is "yes," type of consolidation \_\_\_\_\_

If answer is "no," list the owners and tract descriptions which have actually been consolidated. (Use reverse side of this form if necessary.) \_\_\_\_\_

No allowable will be assigned to the well until all interests have been consolidated (by communitization, unitization, forced-pooling, or otherwise) or until a non-standard unit, eliminating such interests, has been approved by the Commission.

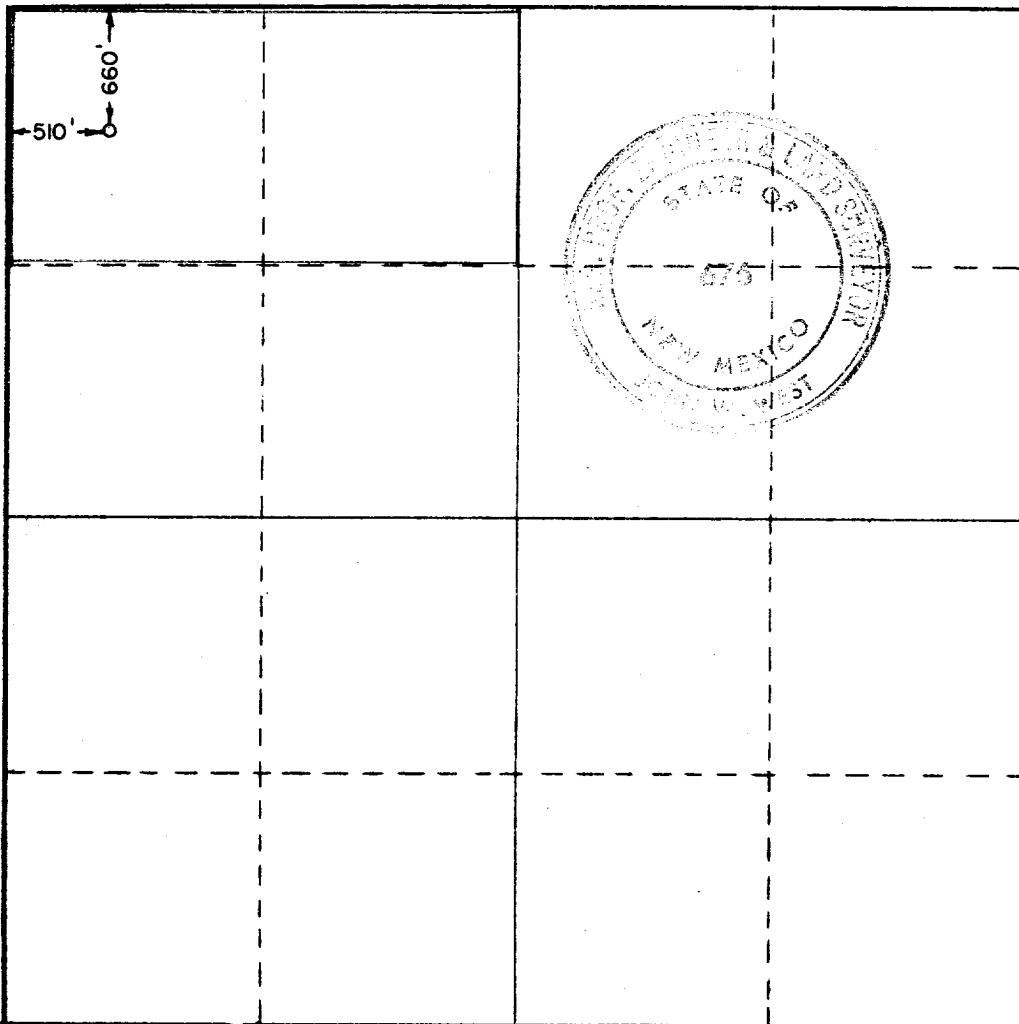

**CERTIFICATION**

I hereby certify that the information contained herein is true and complete to the best of my knowledge and belief.

Name Donna Holmes  
 Position **Agent**  
 Company **Meadco Properties Ltd.**  
 Date **April 1, 1968**

I hereby certify that the well location shown on this plat was plotted from field notes of actual surveys made by me or under my supervision, and that the same is true and correct to the best of my knowledge and belief.

Date Surveyed  
**MARCH 28, 1968**

Registered Professional Engineer  
and/or Land Surveyor

John W. West  
 Certificate No. **676**

0 330 660 990 1320 1650 1980 2310 2640 2970 3300 3630 3960 4290 4620 4950 5280 5610 5940 6270 6600