

NO. OF COPIES RECEIVED	
DISTRIBUTION	
SANTA FE	
FILE	
U.S.G.S.	
LAND OFFICE	
OPERATOR	

NEW MEX CO OIL CONSERVATION COMMISSION

Form C-101
Revised 1-1-65

5A. Indicate Type of Lease STATE <input checked="" type="checkbox"/> FEE <input type="checkbox"/>	
5. State Oil & Gas Lease No. L-434	
7. Unit Agreement Name	
8. Farm or Lease Name State 4	
9. Well No. 1	
10. Field and Pool, or Wildcat Undes. Flying "M"	
12. County Lea	
18. Proposed Depth 4650	19A. Formation San Andres
20. Rotary or C.T. Rotary	
21. Elevations (Show whether DF, RT, etc.) 4272.1	21A. Kind & Status Plug Bond Blanket
21B. Drilling Contractor Cactus Drilling Co.	
22. Approx. Date Work will start 8/17/68	

APPLICATION FOR PERMIT TO DRILL, DEEPEN, OR PLUG BACK

1a. Type of Work	
b. Type of Well DRILL <input checked="" type="checkbox"/> DEEPEN <input type="checkbox"/> PLUG BACK <input type="checkbox"/> OIL WELL <input checked="" type="checkbox"/> GAS WELL <input type="checkbox"/> OTHER <input type="checkbox"/> SINGLE ZONE <input checked="" type="checkbox"/> MULTIPLE ZONE <input type="checkbox"/>	
2. Name of Operator Coastal States Gas Producing Company	
3. Address of Operator c/o Oil Reports & Gas Services, Box 763, Hobbs, New Mexico	
4. Location of Well UNIT LETTER B LOCATED 519 FEET FROM THE North LINE AND 1839 FEET FROM THE East LINE OF SEC. 4 TWP. 10 S RSE. 33 E NMPM	
23.	

PROPOSED CASING AND CEMENT PROGRAM

SIZE OF HOLE	SIZE OF CASING	WEIGHT PER FOOT	SETTING DEPTH	SACKS OF CEMENT	EST. TOP
12 1/4	8 5/8	24#	250	200	Circ.
7 7/8	4 1/2	9.5#	4650	300	3000

IN ABOVE SPACE DESCRIBE PROPOSED PROGRAM: IF PROPOSAL IS TO DEEPEN OR PLUG BACK, GIVE DATA ON PRESENT PRODUCTIVE ZONE AND PROPOSED NEW PRODUCTIVE ZONE. GIVE BLOWOUT PREVENTER PROGRAM, IF ANY.

I hereby certify that the information above is true and complete to the best of my knowledge and belief.

Signed *H. L. Smith* Title Agent Date 7/29/68

(This space for State Use)

APPROVED BY *[Signature]* TITLE _____ DATE _____

CONDITIONS OF APPROVAL, IF ANY:

10-29-68

NEW MEXICO OIL CONSERVATION COMMISSION
WELL LOCATION AND ACREAGE DEDICATION PLAT

Form C-102
Supersedes C-128
Effective 1-1-65

All distances must be from the outer boundaries of the Section.


Operator COASTAL STATES GAS PRODUCING CO.		Lease STATE "M" '68		Well No. 1
Unit Letter B	Section 4	Township 10 SOUTH	Range 33 EAST	County LEA
Actual Footage Location of Well: 519 feet from the NORTH line and 1839 feet from the EAST line				
Ground Level Elev. 4272.1	Producing Formation San Andres	Pool Indes. Flying "M"	Dedicated Acreage: 80 Acres	

1. Outline the acreage dedicated to the subject well by colored pencil or hachure marks on the plat below.
2. If more than one lease is dedicated to the well, outline each and identify the ownership thereof (both as to working interest and royalty).
3. If more than one lease of different ownership is dedicated to the well, have the interests of all owners been consolidated by communitization, unitization, force-pooling, etc?

☐ Yes ☐ No If answer is "yes," type of consolidation _____

If answer is "no," list the owners and tract descriptions which have actually been consolidated. (Use reverse side of this form if necessary.) _____

No allowable will be assigned to the well until all interests have been consolidated (by communitization, unitization, forced-pooling, or otherwise) or until a non-standard unit, eliminating such interests, has been approved by the Commission.

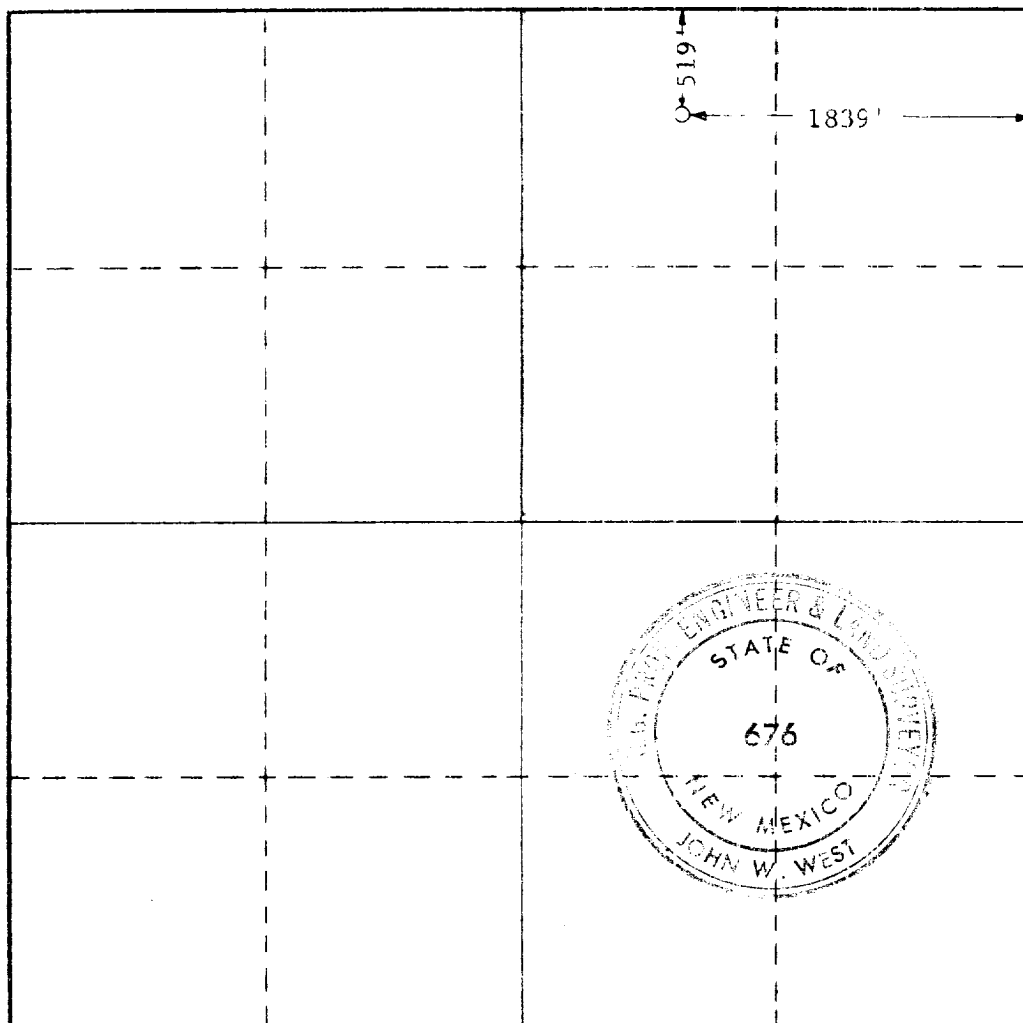

CERTIFICATION

I hereby certify that the information contained herein is true and complete to the best of my knowledge and belief.

Name *A. L. Smith*

Position

Agent

Company

Coastal States Gas Prod. Co.

Date

7/29/68

I hereby certify that the well location shown on this plat was plotted from field notes of actual surveys made by me or under my supervision, and that the same is true and correct to the best of my knowledge and belief.

Date Surveyed

JULY 26, 1968

Registered Professional Engineer and/or Land Surveyor

John W. West

Certificate No.

676

