

NO. OF COPIES RECEIVED		
DISTRIBUTION		
SANTA FE		
FILE		
U.S.G.S.		
LAND OFFICE		
OPERATOR		

NEW MEXICO OIL CONSERVATION COMMISSION

DATE RECEIVED	
FILE NO.	
DATE OF REVIEW	
REVIEWED BY	

APPLICATION FOR PERMIT TO DRILL, DEEPEN, OR PLUG BACK

1a. Type of Work		1b. Type of Well		1c. Type of Agreement	
		DRILL <input checked="" type="checkbox"/> DEEPEN <input type="checkbox"/> PLUG BACK <input type="checkbox"/> OIL WELL <input checked="" type="checkbox"/> GAS WELL <input type="checkbox"/> OTHER <input type="checkbox"/> SINGLE ZONE <input type="checkbox"/> MULTIPLE ZONE <input type="checkbox"/>		1. Initial Agreement <input type="checkbox"/> 2. Plan of Deepening <input type="checkbox"/> 3. Plug Back <input type="checkbox"/>	
2. Name of Operator				3. Name of Lessee	
Stoltz & Company				Brenda	
3. Address of Operator				4. Name of Well	
c/o Oil Reports & Gas Services, Box 763, Hobbs, New Mexico				Undes No Bagley L Penn	
4. Location of Well				5. Location of Well	
UNIT LETTER <u>I</u> LOCATED <u>1980</u> FEET FROM <u>South</u> LINE AND <u>660</u> FEET FROM THE <u>East</u> LINE OF SEC. <u>19</u> TWP. <u>11 S</u> <u>33 E</u> NMPN				6. Location of Well <u>Lea</u>	
10. Proposed Depth				11. Proposed Location	
10,350				Lower Penn	
21. Elevations (Show whether DF, RT, etc.)				21A. Kind & State's Ring Bond	
4308 GL				Blanket	
21B. Drilling Contractor				21C. Date of Well at	
Moran Drlg Co				1/22/69	

PROPOSED CASING AND CEMENT PROGRAM

SIZE OF HOLE	SIZE OF CASING	WEIGHT PER FOOT	SETTING DEPTH	SACKS OF CEMENT	EST. TOP
17 1/2	12 3/8	48#	300	200	Circ.
11	8 5/8	24#	3750	200	2965
7 7/8	4 1/2	11.6#	10,350	350	8815

IN ABOVE SPACE DESCRIBE PROPOSED PROGRAM: IF PROPOSAL IS TO DEEPEN OR PLUG BACK, GIVE LOCATION OF DEEPENING OR PLUG BACK LINE AND PROPOSED NEW PRODUCTIVE ZONE. GIVE BLOWOUT PREVENTER PROGRAM, IF ANY.

I hereby certify that the information above is true and complete to the best of my knowledge and belief.

Signed Wesley Haller Title Agent Date 1/20/69

(This space for State Use)

APPROVED BY [Signature] TITLE [Signature] DATE [Signature]

CONDITIONS OF APPROVAL, IF ANY:

4-22-69

12 3/4

NEW XICO OIL CONSERVATION COMMISSION
WELL LOCATION AND ACREAGE DEDICATION PLAT

Form C-102
Supersedes C-128
Effective 1-1-65

All distances must be from the outer boundaries of the Section.


Operator STOLTZ AND COMPANY			Lease PRENDA		Well No. 1
Init Letter "I"	Section 19	Township 11 South	Range 33 East	County Lea	
Actual Footage Location of Well: 1980 feet from the South line and 660 feet from the East line					
Ground Level Elev. 4308	Producing Formation Lower Perm		Pool Under North Bagley	Dedicated Acreage: 80 Acres	

1. Outline the acreage dedicated to the subject well by colored pencil or hatchure marks on the plat below.
2. If more than one lease is dedicated to the well, outline each and identify the ownership thereof (both as to working interest and royalty).
3. If more than one lease of different ownership is dedicated to the well, have the interests of all owners been consolidated by communitization, unitization, force-pooling, etc?

☐ Yes ☐ No If answer is "yes," type of consolidation _____

If answer is "no," list the owners and tract descriptions which have actually been consolidated. (Use reverse side of this form if necessary.) _____

No allowable will be assigned to the well until all interests have been consolidated (by communitization, unitization, forced-pooling, or otherwise) or until a non-standard unit, eliminating such interests, has been approved by the Commission.

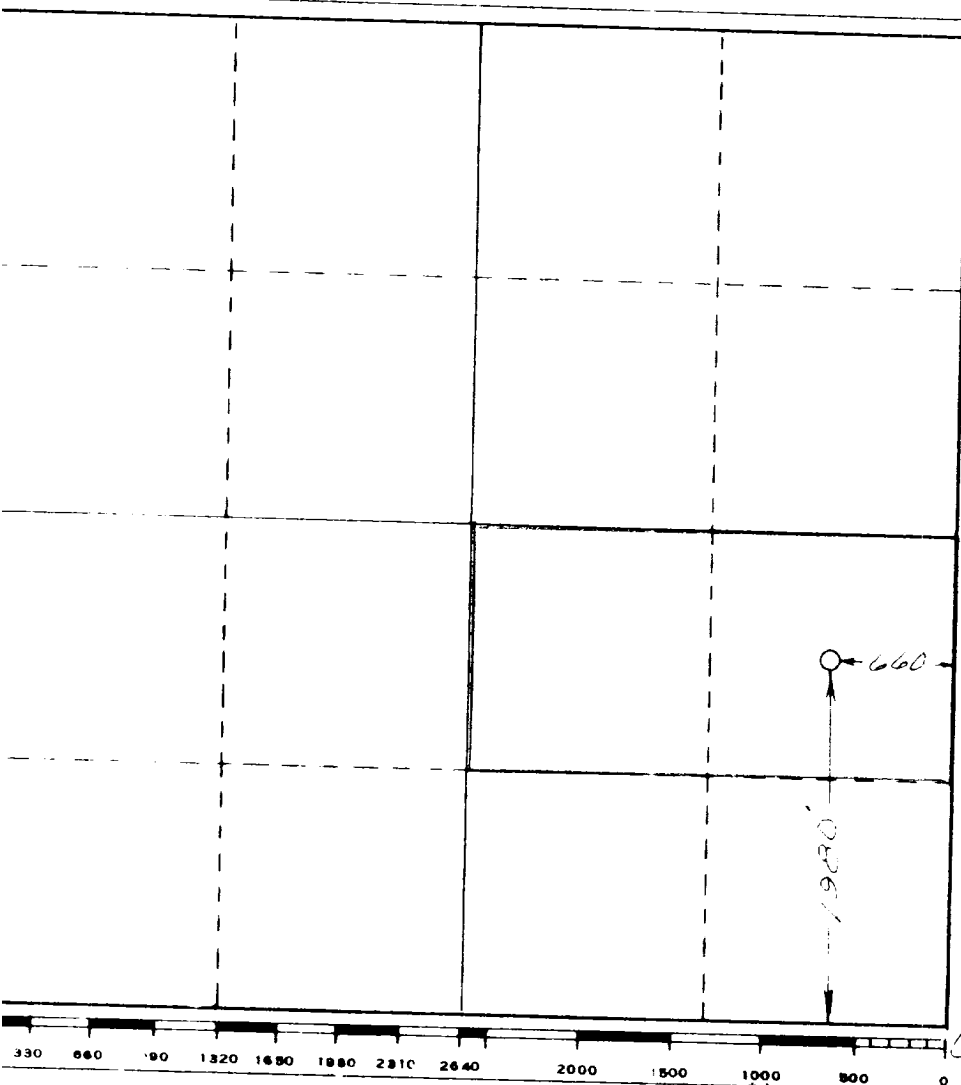

CERTIFICATION

I hereby certify that the information contained herein is true and complete to the best of my knowledge and belief.

Name
Donna Volles
Position
Agent

Company
Stoltz & Company

Date
1/20/69

I hereby certify that the well location shown on this plat was plotted from field notes of actual surveys made by me or under my supervision, and that the same is true and correct to the best of my knowledge and belief.

Date Surveyed
Jan. 18 1969

Registered Professional Engineer
and/or Land Surveyor

John W. Stearn
Certificate No.

1559