

NO. OF COPIES RECEIVED	
DISTRIBUTION	
SANTA FE	
FILE	
U.S.G.S.	
LAND OFFICE	
OPERATOR	

NEW MEXICO OIL CONSERVATION COMMISSION

HOUSE OF REPRESENTATIVES  
JUL 19 9 00 AM '67  
Form C-101  
Revised 1-1-65

Indicate Type of Lease	
STATE <input checked="" type="checkbox"/>	FEE <input type="checkbox"/>
5. State Oil & Gas Lease No.	
<b>K-3995</b>	

APPLICATION FOR PERMIT TO DRILL, DEEPEN, OR PLUG BACK

1a. Type of Work		7. Unit Agreement Name	
b. Type of Well OIL WELL <input checked="" type="checkbox"/> GAS WELL <input type="checkbox"/> OTHER <input type="checkbox"/>		8. Farm or Lease Name	
DEEPEN <input type="checkbox"/> PLUG BACK <input type="checkbox"/>		<b>Anderson State</b>	
2. Name of Operator		9. Well No.	
<b>Taylor Pruitt</b>		<b>2</b>	
3. Address of Operator		10. Field and Pool, or Wildcat	
<b>c/o Oil Reports &amp; Gas Services, Box 763, Hobbs, New Mexico</b>		<b>Undes. Chaveroe-San And.</b>	
4. Location of Well		12. County	
UNIT LETTER <b>J</b> LOCATED <b>1980</b> FEET FROM THE <b>South</b> LINE		<b>Roosevelt</b>	
AND <b>1980</b> FEET FROM THE <b>East</b> LINE OF SEC. <b>36</b> TWP. <b>7 S</b> RGE. <b>32 E</b> NMPM			
19. Proposed Depth		19A. Formation	
<b>4400</b>		<b>San Andres</b>	
20. Rotary or C.T.		<b>Rotary</b>	
21. Elevations (Show whether DF, RT, etc.)		22. Approx. Date Work will start	
<b>4437 GL 4437</b>		<b>7/22/67</b>	
21A. Kind & Status Plug. Bond		21B. Drilling Contractor	
<b>Blanket</b>			

23.

PROPOSED CASING AND CEMENT PROGRAM

SIZE OF HOLE	SIZE OF CASING	WEIGHT PER FOOT	SETTING DEPTH	SACKS OF CEMENT	EST. TOP
<b>11</b>	<b>8 5/8</b>	<b>24#</b>	<b>365</b>	<b>Circ.</b>	
<b>7 7/8</b>	<b>4 1/2</b>	<b>9.5#</b>	<b>4400</b>	<b>250</b>	<b>3300</b>

APPROVAL VALID  
FOR 90 DAYS UNLESS  
DRILLING COMMENCED.  
EXPIRES 10/17/67

IN ABOVE SPACE DESCRIBE PROPOSED PROGRAM: IF PROPOSAL IS TO DEEPEN OR PLUG BACK, GIVE DATA ON PRESENT PRODUCTIVE ZONE AND PROPOSED NEW PRODUCTIVE ZONE. GIVE BLOWOUT PREVENTER PROGRAM, IF ANY.

I hereby certify that the information above is true and complete to the best of my knowledge and belief.

Signed A. L. Smith Title Agent Date July 18, 1967

(This space for State Use)

APPROVED BY [Signature] TITLE  DATE

CONDITIONS OF APPROVAL, IF ANY:

NEW MEXICO OIL CONSERVATION COMMISSION  
WELL LOCATION AND ACREAGE DEDICATION PL

Form C-102  
Supersedes C-128  
Effective 1-1-65

All distances must be from the outer boundaries of the Section.

Operator <b>Taylor Pruitt</b>		Lease <b>Anderson State</b>		Well No. <b>2</b>	
Unit Letter <b>J</b>	Section <b>36</b>	Township <b>7 South</b>	Range <b>32 East</b>	County <b>Roosevelt</b>	

Actual Footage Location of Well:


<b>1980</b>	feet from the <b>South</b>	line and	<b>1980</b>	feet from the <b>East</b>	line
Ground Level Elev. <del>4442</del> <b>4445</b>	Producing Formation <b>San Andres</b>		Pool <b>Undes. Chaveroo</b>	Dedicated Acreage: <b>40</b> Acres	

1. Outline the acreage dedicated to the subject well by colored pencil or hachure marks on the plat below.
2. If more than one lease is dedicated to the well, outline each and identify the ownership thereof (both as to working interest and royalty).
3. If more than one lease of different ownership is dedicated to the well, have the interests of all owners been consolidated by communitization, unitization, force-pooling, etc?

☐ Yes ☐ No If answer is "yes," type of consolidation \_\_\_\_\_

If answer is "no," list the owners and tract descriptions which have actually been consolidated. (Use reverse side of this form if necessary.) \_\_\_\_\_

No allowable will be assigned to the well until all interests have been consolidated (by communitization, unitization, forced-pooling, or otherwise) or until a non-standard unit, eliminating such interests, has been approved by the Commission.

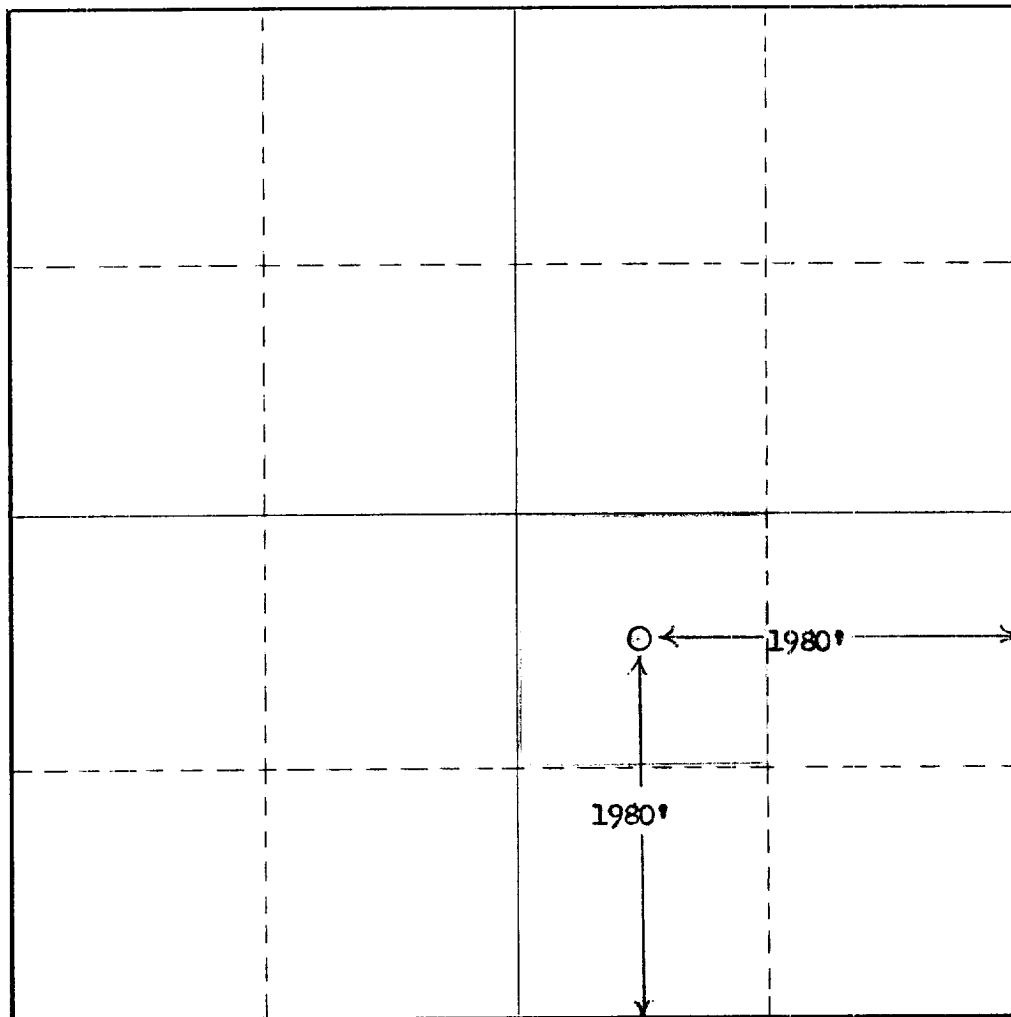

CERTIFICATION

I hereby certify that the information contained herein is true and complete to the best of my knowledge and belief.

Name **H. L. Smith**

Position  
**Agent**

Company  
**Taylor Pruitt**

Date  
**July 18, 1967**

I hereby certify that the well location shown on this plat was plotted from field notes of actual surveys made by me or under my supervision, and that the same is true and correct to the best of my knowledge and belief.

Date Surveyed

**6-28-67**

Registered Professional Engineer  
and/or Land Surveyor

No.  
**1069**

Certificate No.

**1069**

