

NO. OF COPIES RECEIVED	
DISTRIBUTION	
SANTA FE	
FILE	
U.S.G.S.	
LAND OFFICE	
OPERATOR	

NEW MEXICO OIL CONSERVATION COMMISSION

HOBBES OFFICE O.C.C.

JUL 31 1 16 PM '67

Form C-101
Revised 1-1-65

5A. Indicate Type of Lease	
STATE <input checked="" type="checkbox"/>	FEE <input type="checkbox"/>
5. State Oil & Gas Lease No.	
OG-1017	
7. Unit Agreement Name	
8. Farm or Lease Name	
KOS	
9. Well No.	
2	
10. Field and Pool, or Wildcat	
Unders. Cherokee-SA	
12. County	
Reconville	
19. Proposed Depth	19A. Formation
4400	San Andres
20. Rotary or C.T.	
Rotary	
21. Elevations (Show whether DF, RT, etc.)	21A. Kind & Status Plug. Bond
4440 CL	Blanket
21B. Drilling Contractor	22. Approx. Date Work will start
Chico Drilling Co.	August 2, 1967

1a. Type of Work	
b. Type of Well	
DRILL <input checked="" type="checkbox"/>	DEEPEN <input type="checkbox"/>
OIL WELL <input checked="" type="checkbox"/>	GAS WELL <input type="checkbox"/>
2. Name of Operator	
Taylor Pruitt	
3. Address of Operator	
c/o Oil Reports & Gas Services, Box 763, Hobbs, New Mexico	
4. Location of Well	
UNIT LETTER I	LOCATED 1980 FEET FROM THE South LINE
AND 660 FEET FROM THE East LINE OF SEC. 36 TWP. 7S RGE. 32E NMPM	
21. Elevations (Show whether DF, RT, etc.)	
4440 CL	
21A. Kind & Status Plug. Bond	
Blanket	
21B. Drilling Contractor	
Chico Drilling Co.	
22. Approx. Date Work will start	
August 2, 1967	

PROPOSED CASING AND CEMENT PROGRAM

SIZE OF HOLE	SIZE OF CASING	WEIGHT PER FOOT	SETTING DEPTH	SACKS OF CEMENT	EST. TOP
12 1/4	8 5/8	24#	365	250	circ.
7 7/8	4 1/2	9.5#	4400	250	3300

APPROVAL VALID
FOR 90 DAYS UNLESS
DRILLING COMMENCED,

EXPIRES 11-1-67

IN ABOVE SPACE DESCRIBE PROPOSED PROGRAM: IF PROPOSAL IS TO DEEPEN OR PLUG BACK, GIVE DATA ON PRESENT PRODUCTIVE ZONE AND PROPOSED NEW PRODUCTIVE ZONE. GIVE BLOWOUT PREVENTER PROGRAM, IF ANY.

I hereby certify that the information above is true and complete to the best of my knowledge and belief.

ORIG. SIGNED
BY M. L. SMITH

Signed _____ Title _____ Agent _____ Date _____ July 31, 1967

(This space for State Use)

APPROVED BY _____ TITLE _____ DATE _____

CONDITIONS OF APPROVAL, IF ANY:

N MEXICO OIL CONSERVATION COMMISS
WELL LOCATION AND ACREAGE DEDICATION PLAT

Form O-102
Superseded O-128
Effective 1-1-61

All distances must be from the corner boundaries of the Section

WILBBS OFFICE O. G. S.
JUL 31 16 PM '67


Operator Taylor Pruitt		Lease JUL 31 16 PM '67		Well No. 2
Tract Letter I	Section 36	Township 7 S	Range 32 E	County Roosevelt
Actual Footage Location of Well:				
1980 feet from the South		line and 560 feet from the East line		
Ground Level Elev. 4448	Producing Formation San Andres	Pool Indes. Chaveroo San Andres	Dedicated Acreage 40	

- Outline the acreage dedicated to the subject well by colored pencil or hatchure marks on the plat below.
- If more than one lease is dedicated to the well, outline each and identify the ownership thereof (both as to working interest and royalty).
- If more than one lease of different ownership is dedicated to the well, have the interests of all owners been consolidated by communitization, unitization, force-pooling, etc?

☐ Yes ☐ No If answer is "yes" type of consolidation _____

If answer is "no" list the owners and tract descriptions which have actually been consolidated. (Use reverse side of this form if necessary.) _____

No allowable will be assigned to the well until all interests have been consolidated (by communitization, unitization, force-pooling, or otherwise) or until a non-standard unit, eliminating such interests, has been approved by the Commission.

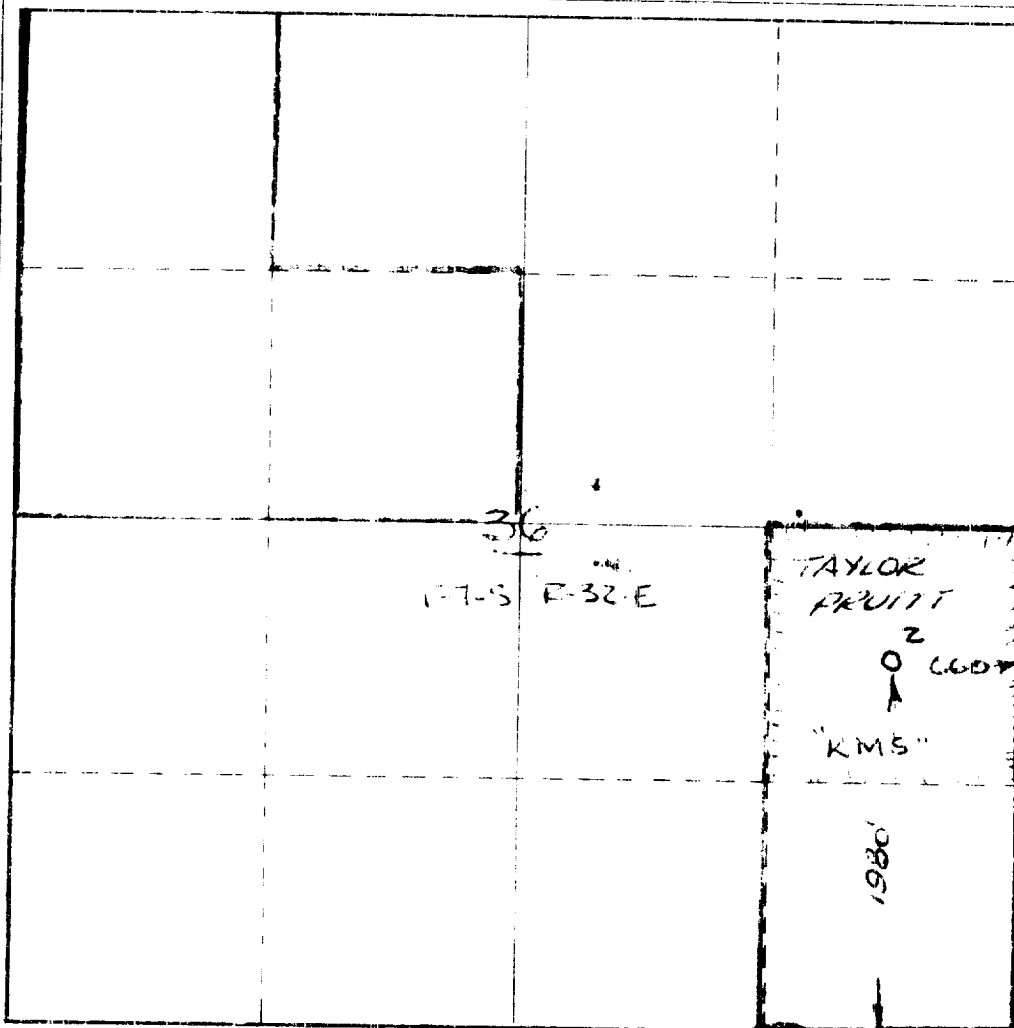

CERTIFICATION

I hereby certify that the information contained herein is true and complete to the best of my knowledge and belief.

Name *Donna Walker*

Position
Agent

Company
Taylor Pruitt

Date
July 31, 1967

I hereby certify that the well location shown on this plat was plotted from field notes of actual surveys made by me or under my supervision, and that the same is true and correct to the best of my knowledge and belief.


Date Surveyed

7/24/67

Registered Professional Engineer and/or Land Surveyor

No. **1069**

Certificate No.

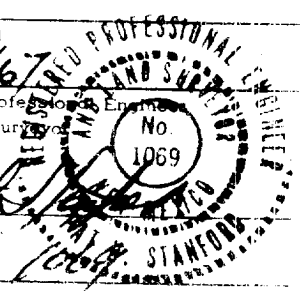

473