

NO. OF COPIES RECEIVED	
DISTRIBUTION	
SANTA FE	
FILE	
U.S.G.S.	
LAND OFFICE	
OPERATOR	

NEW MEXICO OIL CONSERVATION COMMISSION

Form C-101
Revised 1-1-65

5A. Indicate Type of Lease	
STATE <input checked="" type="checkbox"/>	FEE <input type="checkbox"/>
5. State Oil & Gas Lease No.	
B-8638	

APPLICATION FOR PERMIT TO DRILL, DEEPEN, OR PLUG BACK

1a. Type of Work		7. Unit Agreement Name	
b. Type of Well OIL WELL <input checked="" type="checkbox"/> GAS WELL <input type="checkbox"/> OTHER <input type="checkbox"/>		8. Farm or Lease Name	
DRILL <input checked="" type="checkbox"/> DEEPEN <input type="checkbox"/> PLUG BACK <input type="checkbox"/>		CMS	
2. Name of Operator		9. Well No.	
Taylor Pruitt		2	
3. Address of Operator		10. Field and Pool, or Wildcat	
c/o Oil Reports & Gas Services, Box 763, Hobbs, New Mexico		Chaveroo San Andres	
4. Location of Well		12. County	
UNIT LETTER N LOCATED 660 FEET FROM THE South LINE		Roosevelt	
AND 1980 FEET FROM THE West LINE OF SEC. 36 TWP. 7 S RGE. 32 E NMPM			
19. Proposed Depth		19A. Formation	20. Rotary or C.T.
4450		San Andres	Rotary
21. Elevations (Show whether DF, RT, etc.)	21A. Kind & Status Plug. Bond	21B. Drilling Contractor	22. Approx. Date Work will start
4464.1 GL	Blanket	Verna Drilling Co	2/5/68

23.

PROPOSED CASING AND CEMENT PROGRAM

SIZE OF HOLE	SIZE OF CASING	WEIGHT PER FOOT	SETTING DEPTH	SACKS OF CEMENT	EST. TOP
12 1/4	8 5/8	20#	325	Circ	
7 7/8	5 1/2	14#	4450	250	3050

APPROVAL VALID FOR 90 DAYS UNLESS REVISED OR CANCELLED.
4-24-68

APPROVAL VALID FOR 90 DAYS UNLESS REVISED OR CANCELLED.
4-24-68

IN ABOVE SPACE DESCRIBE PROPOSED PROGRAM: IF PROPOSAL IS TO DEEPEN OR PLUG BACK, GIVE DATA ON PRESENT PRODUCTIVE ZONE AND PROPOSED NEW PRODUCTIVE ZONE. GIVE BLOWOUT PREVENTER PROGRAM, IF ANY.

I hereby certify that the information above is true and complete to the best of my knowledge and belief.

Signed *Donna Heller* Title **Agent** Date **1/23/68**

(This space for State Use)

APPROVED BY *Joe X. [Signature]* TITLE **DEPUTY DISTRICT** DATE **1/23/68**

CONDITIONS OF APPROVAL, IF ANY:

NEW MEXICO OIL CONSERVATION COMMISSION
WELL LOCATION AND ACREAGE DEDICATION PLAT

Form C-102
Supersedes C-128
Effective 1-1-65

All distances must be from the outer boundaries of the Section.


Operator TAYLOR PRUITT			Lease "CWS"		Well No. 2
North Letter N	Section 36	Township 7 SOUTH	Range 32 EAST	County ROOSEVELT	
Actual Portage Location of Well: 660 feet from the SOUTH line and 1980 feet from the WEST line					
Ground Level Elev. 4464.1	Producing Formation San Andres		Pool Chavero	Dedicated Acreage 40	

- Outline the acreage dedicated to the subject well by colored pencil or hatchure marks on the plat below.
- If more than one lease is dedicated to the well, outline each and identify the ownership thereof (both as to working interest and royalty).
- If more than one lease of different ownership is dedicated to the well, have the interests of all owners been consolidated by communitization, unitization, force-pooling, etc?

☐ Yes ☐ No If answer is "yes," type of consolidation _____

If answer is "no," list the owners and tract descriptions which have actually been consolidated. (Use reverse side of this form if necessary.) _____

No allowable will be assigned to the well until all interests have been consolidated (by communitization, unitization, forced-pooling, or otherwise) or until a non-standard unit, eliminating such interests, has been approved by the Commission.

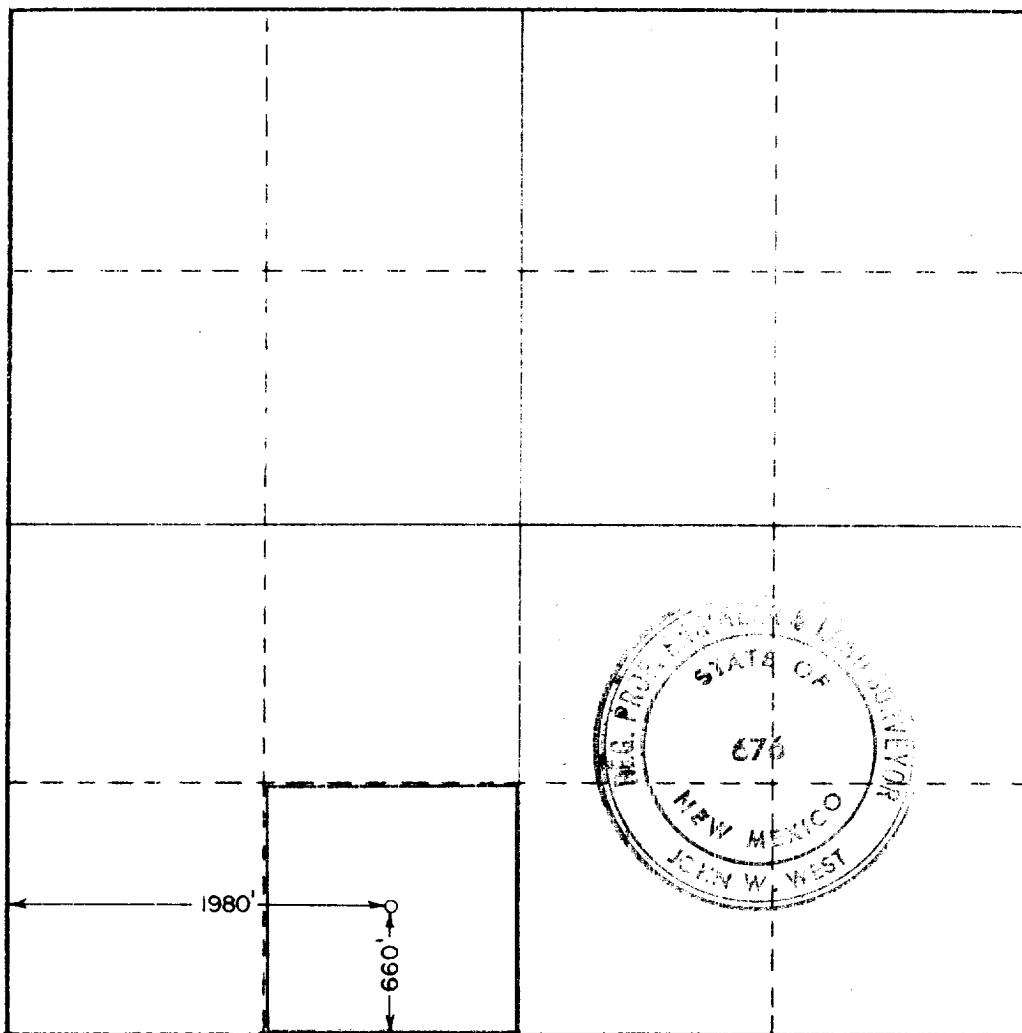

CERTIFICATION

I hereby certify that the information contained herein is true and complete to the best of my knowledge and belief.

By *Donna Volles*
Agent

For Taylor Pruitt

Date
1/23/68

I hereby certify that the well location shown on this plat was plotted from field notes of actual surveys made by me or under my supervision, and that the same is true and correct to the best of my knowledge and belief.

Date Surveyed

JANUARY 22, 1968

Registered Professional Engineer and/or Land Surveyor

John W West
Certificate No. **676**

