

NO. OF COPIES RECEIVED	
DISTRIBUTION	
SANTA FE	
FILE	
U.S.G.S.	
LAND OFFICE	
OPERATOR	

NEW MEXICO OIL CONSERVATION COMMISSION

Form C-101
Revised 1-1-65

Dec 1 2 44 PM '68

5A. Indicate Type of Lease	
STATE <input type="checkbox"/>	FEE <input checked="" type="checkbox"/>

5. State Oil & Gas Lease No.

APPLICATION FOR PERMIT TO DRILL, DEEPEN, OR PLUG BACK

1a. Type of Work		7. Unit Agreement Name	
b. Type of Well OIL WELL <input checked="" type="checkbox"/> GAS WELL <input type="checkbox"/> OTHER <input type="checkbox"/>		8. Farm or Lease Name Tucker-Hall	
2. Name of Operator Taylor Pruitt		9. Well No. 4	
3. Address of Operator e/o Oil Reports & Gas Services, Box 763, Hobbs, New Mexico		10. Field and Pool, or Wildcat Chaveroo San Andres	
4. Location of Well UNIT LETTER B LOCATED 660 FEET FROM THE North LINE 1980 AND East FEET FROM THE LINE OF SEC. 25 TWP. 7 S RGE. 32 E NMPM		12. County Roosevelt	
19. Proposed Depth 4500		19A. Formation San Andres	
20. Rotary or C.T. Rotary		21. Elevations (Show whether DE, RT, etc.) 4435.4 GL	
21A. Kind & Status Plug. Bond Blanket		21B. Drilling Contractor Verna Drilling Co.	
22. Approx. Date Work will start 12/6/68			

23.

PROPOSED CASING AND CEMENT PROGRAM

SIZE OF HOLE	SIZE OF CASING	WEIGHT PER FOOT	SETTING DEPTH	SACKS OF CEMENT	EST. TOP
12 1/4	8 5/8	20#	325	225	Circ.
7 7/8	5 1/2	14#	4500	250	3000

THE COMMISSION MUST BE NOTIFIED
24 HOURS BEFORE TO RUNNIN
CASING

APPROVAL VALID
FOR 90 DAYS UNLESS
DRILLING COMMENCED

EXPIRES **3-4-69**

IN ABOVE SPACE DESCRIBE PROPOSED PROGRAM: IF PROPOSAL IS TO DEEPEN OR PLUG BACK, GIVE DATA ON PRESENT PRODUCTIVE ZONE AND PROPOSED NEW PRODUCTIVE ZONE. GIVE BLOWOUT PREVENTER PROGRAM, IF ANY.

I hereby certify that the information above is true and complete to the best of my knowledge and belief.

Signed *W. L. Smith* Title Agent Date 12/3/68

(This space for State Use)

APPROVED BY *Joe A. [Signature]* TITLE _____ DATE _____

CONDITIONS OF APPROVAL, IF ANY:

NEW MEXICO OIL CONSERVATION COMMISSION
WELL LOCATION AND ACREAGE DEDICATION PLAT

Form C-102
Supersedes C-128
Effective 1-1-65

All distances must be from the outer boundaries of the Section


Operator TAYLOR PRUITT, INC.			Lease LEC 1 100 TUCKER-HALL		Well No. 4
Tract Letter B	Section 25	Township 7 SOUTH	Range 32 EAST	County ROOSEVELT	
Actual Footage Location of Well: 660 feet from the NORTH line and 1980 feet from the EAST line					
Ground Level Elev. 4435.4	Producing Formation San Andres		Pool Chaveroo		Dedicated Acreage: 40 Acres

1. Outline the acreage dedicated to the subject well by colored pencil or hachure marks on the plat below.
2. If more than one lease is dedicated to the well, outline each and identify the ownership thereof (both as to working interest and royalty).
3. If more than one lease of different ownership is dedicated to the well, have the interests of all owners been consolidated by communitization, unitization, force-pooling, etc?

☐ Yes ☐ No If answer is "yes," type of consolidation _____

If answer is "no," list the owners and tract descriptions which have actually been consolidated. (Use reverse side of this form if necessary.) _____

No allowable will be assigned to the well until all interests have been consolidated (by communitization, unitization, forced-pooling, or otherwise) or until a non-standard unit, eliminating such interests, has been approved by the Commission.

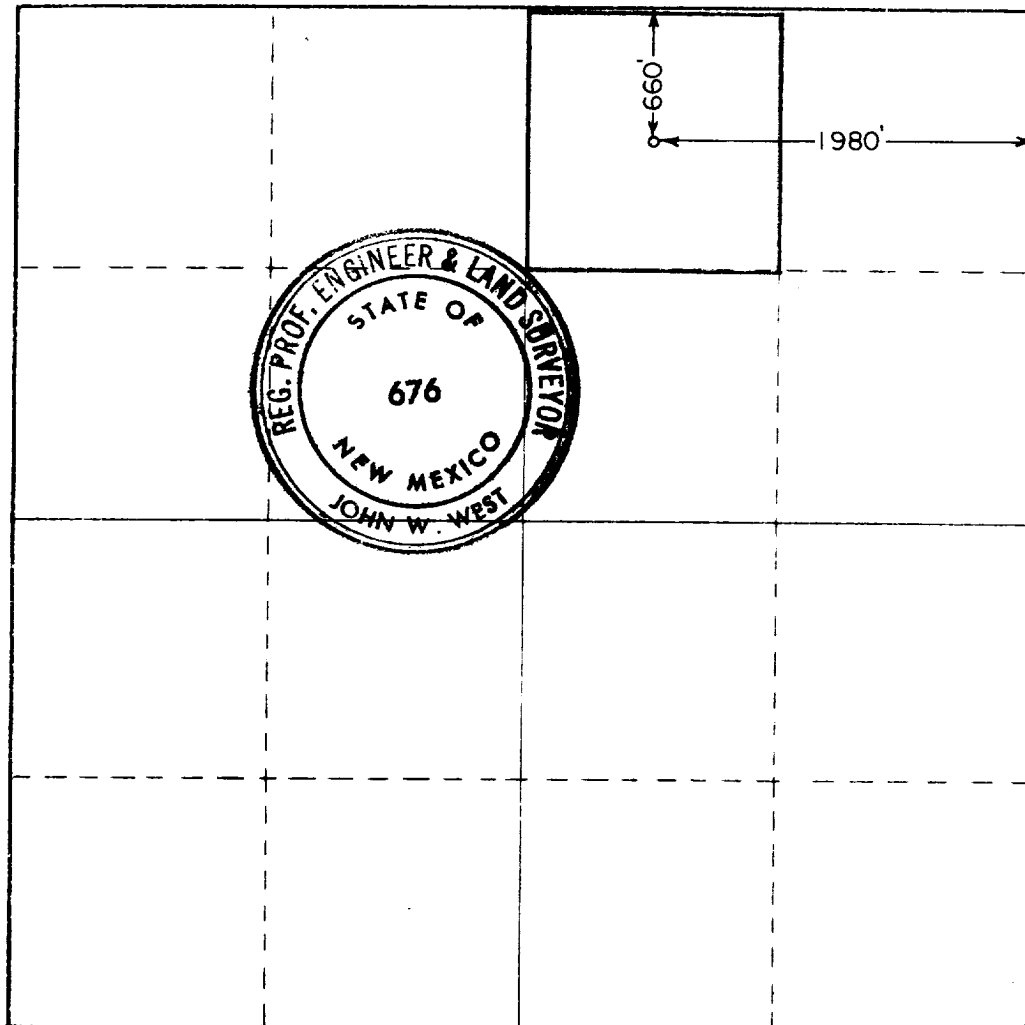

CERTIFICATION

I hereby certify that the information contained herein is true and complete to the best of my knowledge and belief.

By: *H. L. Smet*

Position:
Agent

For: **Taylor Pruitt**

Date:
12/3/68

I hereby certify that the well location shown on this plat was plotted from field notes of actual surveys made by me or under my supervision, and that the same is true and correct to the best of my knowledge and belief.

Date Surveyed:

SEPTEMBER 21, 1968

Registered Professional Engineer and/or Land Surveyor

John W. West
Certificate No. **676**

