

NO. OF COPIES RECEIVED	
DISTRIBUTION	
SANTA FE	
FILE	
U.S.G.S.	
LAND OFFICE	
OPERATOR	

NEW MEXICO OIL CONSERVATION COMMISSION

30-000-20351
Form C-101
Revised 1-1-65

5A. Indicate Type of Lease
STATE <input checked="" type="checkbox"/> FEE <input type="checkbox"/>
5. State Oil & Gas Lease No.
Unknown

APPLICATION FOR PERMIT TO DRILL, DEEPEN, OR PLUG BACK

1a. Type of Work	DRILL <input checked="" type="checkbox"/> DEEPEN <input type="checkbox"/> PLUG BACK <input type="checkbox"/>
b. Type of Well	OIL WELL <input checked="" type="checkbox"/> GAS WELL <input type="checkbox"/> OTHER <input type="checkbox"/>
2. Name of Operator	Stolts, Wagner and Brown
3. Address of Operator	c/o Oil Reports & Gas Services, Inc., Box 763, Hobbs, N. M. 88240
4. Location of Well	UNIT LETTER A LOCATED 660 FEET FROM THE North LINE
AND 510 FEET FROM THE East LINE OF SEC. 36 TWP. 7 S RGE. 30 E NMPM	
12. County	Chaves
19. Proposed Depth	3800
19A. Formation	San Andres
20. Rotary or C.T.	Rotary
21. Elevations (Show whether DF, RT, etc.)	4223 GL
21A. Kind & Status Plug. Bond	Blanket
21B. Drilling Contractor	Not Let
22. Approx. Date Work will start	9/25/70

PROPOSED CASING AND CEMENT PROGRAM					
SIZE OF HOLE	SIZE OF CASING	WEIGHT PER FOOT	SETTING DEPTH	SACKS OF CEMENT	EST. TOP
11	8 5/8	24#	300	Circ.	
7 7/8	4 1/2	10.5#	3800	150	3150

APPROVAL VALID
FOR 90 DAYS UNLESS
RENEWED OR EXTENDED,

EXPIRES 12-28-70

THE COMMISSION MUST BE NOTIFIED
90 DAYS PRIOR TO RUNNING
CASING.

IN ABOVE SPACE DESCRIBE PROPOSED PROGRAM: IF PROPOSAL IS TO DEEPEN OR PLUG BACK, GIVE DATA ON PRESENT PRODUCTIVE ZONE AND PROPOSED NEW PRODUCTIVE ZONE. GIVE BLOWOUT PREVENTER PROGRAM, IF ANY.

I hereby certify that the information above is true and complete to the best of my knowledge and belief.

Signed Margaret Holles Title Agent Date 9/25/70

(This space for State Use)

APPROVED BY [Signature] TITLE Commissioner DATE SEP 28 1970

CONDITIONS OF APPROVAL, IF ANY:

RECEIVED

SEP 25 1970

**OIL CONSERVATION COMM.
HOBBS, N. M.**

**NEW MEXICO OIL CONSERVATION COMMISSION
WELL LOCATION AND ACREAGE DEDICATION PLAT**

Form C-102
Supersedes C-128
Effective 1-4-65

All distances must be from the outer boundaries of the Section.


Operator STOLTZ, WAGNER and BROWN			Lease CROSBY		Well No. 1
Unit Letter A	Section 36	Township 7 South	Range 30 East	County CHAVES	
Actual Footage Location of Well: 660 feet from the North line and 510 feet from the East line					
Ground Level Elev. 4223	Producing Formation San Andres		Pool Undes. Cato	Dedicated Acreage: 40 Acres	

1. Outline the acreage dedicated to the subject well by colored pencil or hachure marks on the plat below.
2. If more than one lease is dedicated to the well, outline each and identify the ownership thereof (both as to working interest and royalty).
3. If more than one lease of different ownership is dedicated to the well, have the interests of all owners been consolidated by communitization, unitization, force-pooling, etc?

☐ Yes ☐ No If answer is "yes," type of consolidation _____

If answer is "no," list the owners and tract descriptions which have actually been consolidated. (Use reverse side of this form if necessary.) _____

No allowable will be assigned to the well until all interests have been consolidated (by communitization, unitization, forced-pooling, or otherwise) or until a non-standard unit, eliminating such interests, has been approved by the Commission.

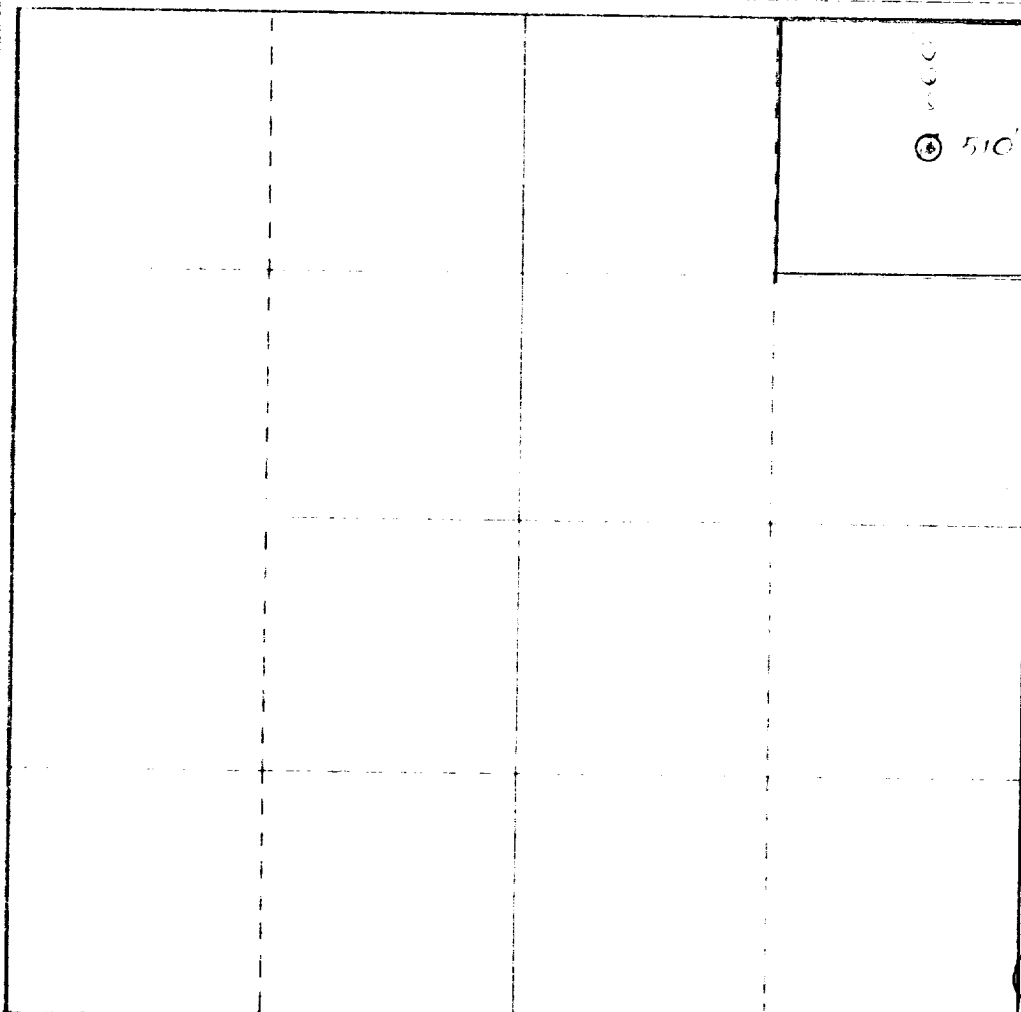

CERTIFICATION

I hereby certify that the information contained herein is true and complete to the best of my knowledge and belief.


Name *Wonna Kolles*
 Position _____
Agent
 Company _____
Stoltz, Wagner & Brown
 Date _____
September 25, 1970

I hereby certify that the well location shown on this plat was plotted from field notes of actual surveys made by me or under my supervision, and that the same is true and correct to the best of my knowledge and belief.

Date Surveyed _____
September 22, 1970
 Registered Professional Engineer
 and/or Land Surveyor

Edna W. Shuman
 Certificate No. _____

1559

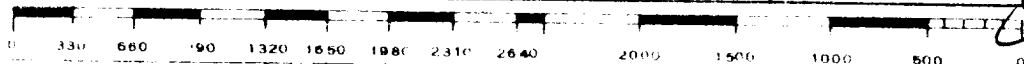

173

RECEIVED

SEP 20 1970
OIL CONSERVATION COMM.
HOBBS, N. M.