

Santa Fe, New Mexico

JAN 31 1951

## NOTICE OF INTENTION TO DRILL

Notice must be given to the Oil Conservation Commission or its proper agent and approval obtained before drilling begins. If changes in the proposed plan are considered advisable, a copy of this notice showing such changes will be returned to the sender. Submit this notice in triplicate. One copy will be returned following approval. See additional instructions in Rules and Regulations of the Commission.

Midland, Texas

January 29, 1951

Place

Date

OIL CONSERVATION COMMISSION,  
Santa Fe, New Mexico,

Gentlemen:

You are hereby notified that it is our intention to commence the drilling of a well to be known as The

Atlantic Refining Co.State "S"Well No. 1in SW/4 of NE/4

Company or Operator

Lease

of Sec. 28, T. 14-S, R. 33-E, N. M., P. M., Saunders Field, Lea County.

N

The well is 1980 feet ~~XX~~ (S.) of the north line and 1980 feet ~~XX~~ (W.) of the east line of Section 28

(Give location from section or other legal subdivision lines. Cross out wrong directions.)

If state land the oil and gas lease is No. B-9115 Assignment No. \_\_\_\_\_

If patented land the owner is \_\_\_\_\_


Address \_\_\_\_\_

If government land the permittee is \_\_\_\_\_

Address \_\_\_\_\_

The lessee is The Atlantic Refining Co.

Address Box #871, Midland, Texas

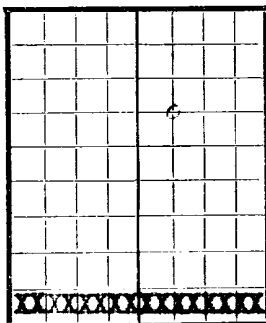

AREA 640 ACRES

LOCATE WELL CORRECTLY

We propose to drill well with drilling equipment as follows: rotary tools from surface to total depth of approximately 10,000 feet

The status of a bond for this well in conformance with Rule 39 of the General Rules and Regulations of the Commission is as follows: Bond No. 44120 (General Casualty Co. of America) in effect.

We propose to use the following strings of casing and to land or cement them as indicated:

| Size of Hole | Size of Casing | Weight Per Foot | New or Second Hand | Depth   | Landed or Cemented | Sacks Cement |
|--------------|----------------|-----------------|--------------------|---------|--------------------|--------------|
| 17-1/4"      | 13-3/8"        | 48#             | New                | 350'    | Cemented           | 350          |
| 12-1/4"      | 9-5/8"         | 36# & 40#       | New                | 4150'   | Cemented           | 3000         |
| 8-3/4"       | 7"             | 23#, 26#, 29#   | New                | 10,000' | Cemented           | 850          |

If changes in the above plan become advisable we will notify you before cementing or landing casing. We estimate that the first productive oil or gas sand should occur at a depth of about 9750 feet.

Additional information:

See plat attached.

Approved JAN 31 1951, 19\_\_\_\_

except as follows:

Sincerely yours,

THE ATLANTIC REFINING COMPANY

Company or Operator

By J. C. Frick T. C. Frick

Position Division Operations Supervisor

Send communications regarding well to

Name THE ATLANTIC REFINING COMPANY



Address Box #871, Midland, Texas

OIL CONSERVATION COMMISSION,

By Ray Guibree

Title Oil & Gas Inspector

R. 33 E.

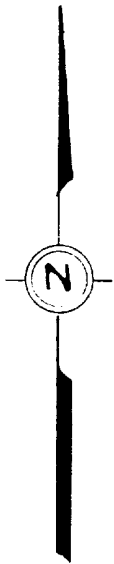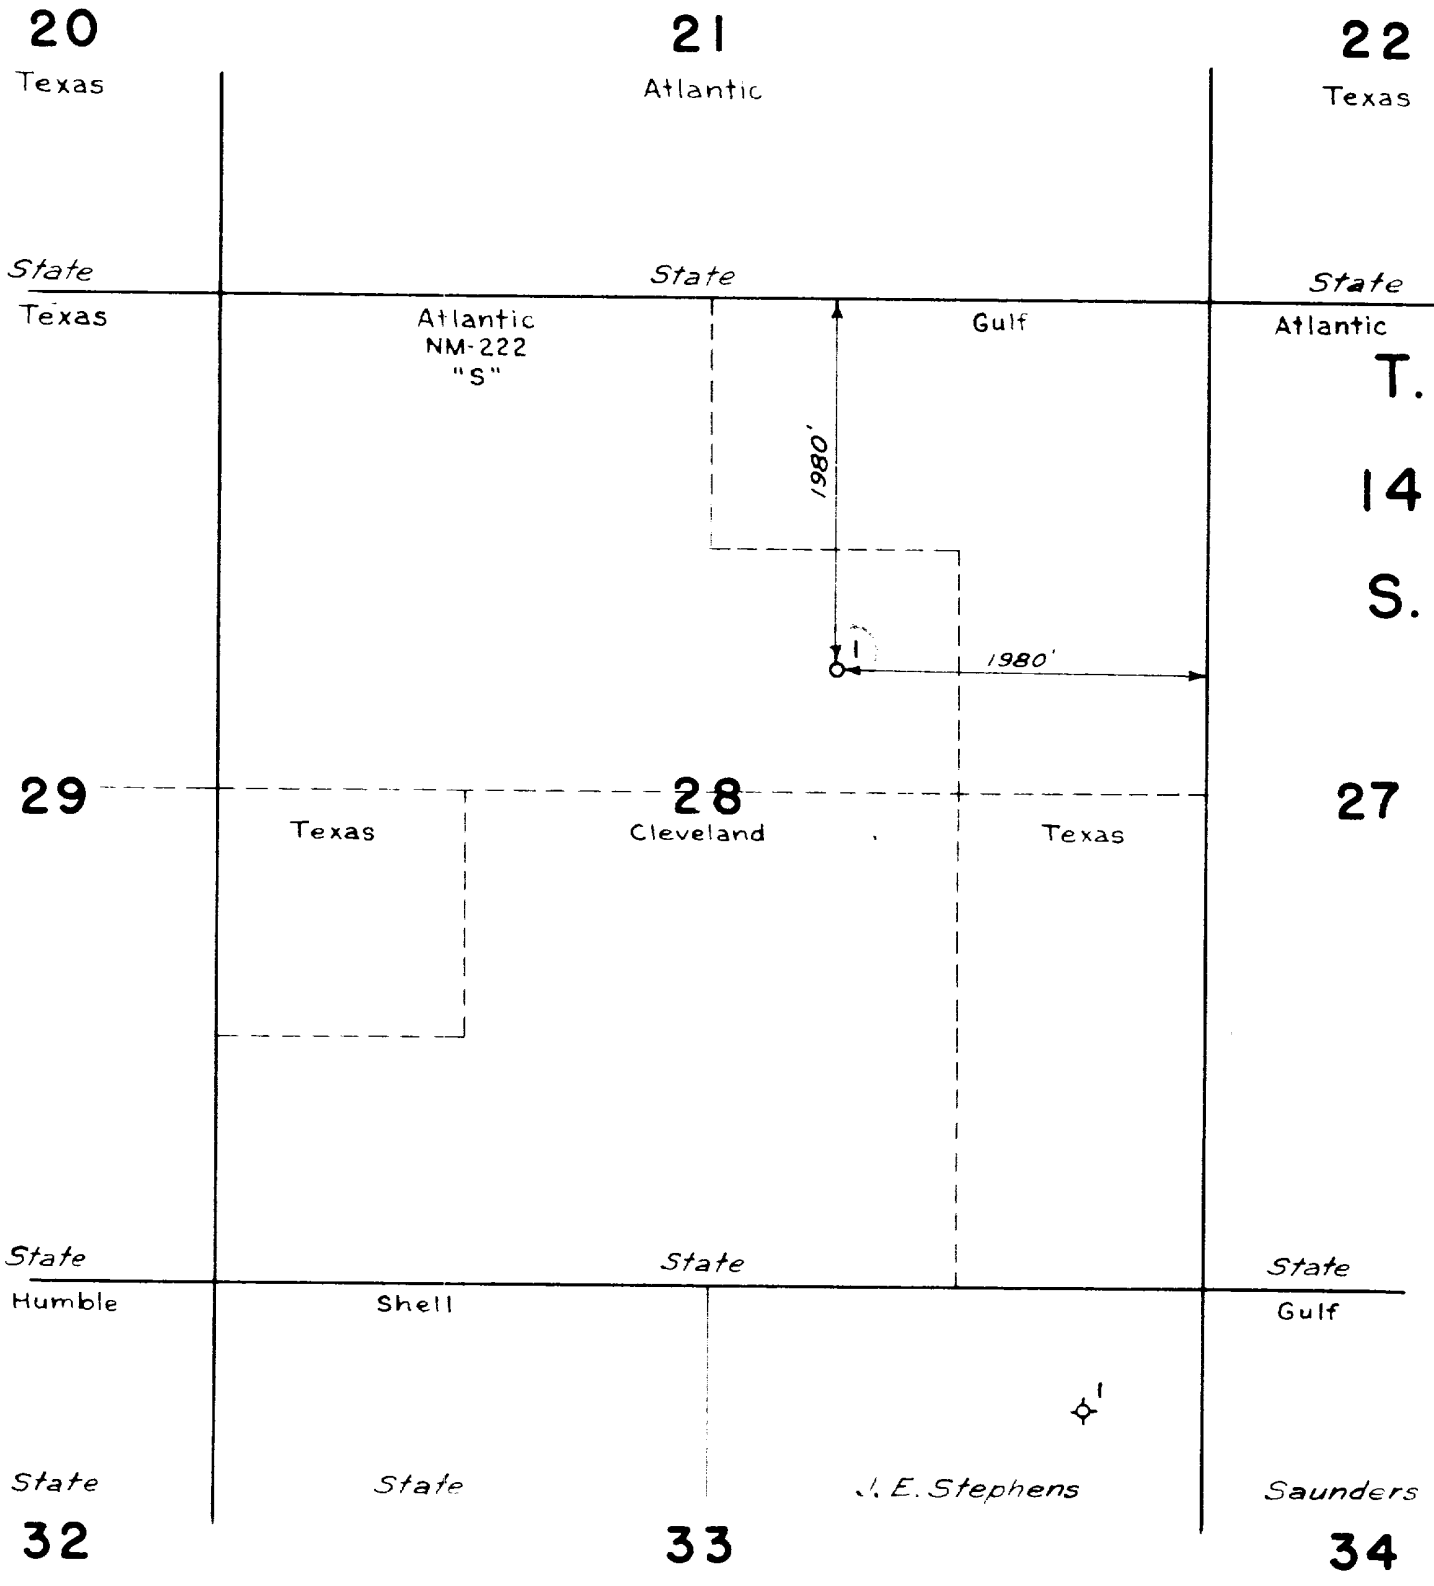

Operator: THE ATLANTIC REFINING COMPANY  
Lease: STATE OF NEW MEXICO-"S"- NO. B-9115  
Field: SAUNDERS POOL  
Description: Sec. 28 T. 14 S., R. 33 E., Lea Co., New Mexico  
Date Plat Drawn: Jan. 24, 1951

NM-222

Scale: 1"=1000'

|   |             |                                   |                 |
|---|-------------|-----------------------------------|-----------------|
| THE ATLANTIC REFINING CO<br>SURVEYING DEPT.<br>DALLAS, TEXAS. | Sur. R.A.W. | Approved:<br><i>W. J. Burkart</i> | Date: 1-24-51   |
|   | Dwn. R.A.W. |                                   | Rev.:<br>A-1273 |