

NO. OF COPIES RECEIVED	
DISTRIBUTION	
SANTA FE	
FILE	
U.S.G.S.	
LAND OFFICE	
OPERATOR	

NEW MEXICO OIL CONSERVATION COMMISSION

Form C-101
Revised 1-1-65

5A. Indicate Type of Lease
STATE ☒ FEE ☐
5. State Oil & Gas Lease No.
K-4807

APPLICATION FOR PERMIT TO DRILL, DEEPEN, OR PLUG BACK

1a. Type of Work b. Type of Well OIL WELL <input checked="" type="checkbox"/> GAS WELL <input type="checkbox"/> OTHER <input type="checkbox"/> SINGLE ZONE <input checked="" type="checkbox"/> MULTIPLE ZONE <input type="checkbox"/>		7. Unit Agreement Name	
2. Name of Operator Coastal States Gas Producing Company		8. Farm or Lease Name State "31"	
3. Address of Operator c/o Oil Reports & Gas Services, Box 763, Hobbs, New Mexico		9. Well No. 1	
4. Location of Well UNIT LETTER L LOCATED 1881 FEET FROM THE South LINE AND 759 FEET FROM THE West LINE OF SEC. 31 TWP. 13S RGE. 33E NMPM		10. Field and Pool, or Wildcat Undes. Baum Wolfcamp	
12. County Lea			
19. Proposed Depth 10,200		19A. Formation Wolfcamp	
20. Rotary or C.T. Rotary			
21. Elevations (Show whether DF, RT, etc.) 4284.8 GR	21A. Kind & Status Plug. Bond Blanket	21B. Drilling Contractor Moran Drilling Co.	22. Approx. Date Work will start 3/8/68

23. PROPOSED CASING AND CEMENT PROGRAM

SIZE OF HOLE	SIZE OF CASING	WEIGHT PER FOOT	SETTING DEPTH	SACKS OF CEMENT	EST. TOP
17 1/2	13 3/8	48#	350	350	Circ
11	8 5/8	24# & 32#	4000	300	3000
7 7/8	5 1/2	15.5# & 17#	10,200	200	9200

IN ABOVE SPACE DESCRIBE PROPOSED PROGRAM: IF PROPOSAL IS TO DEEPEN OR PLUG BACK, GIVE DATA ON PRESENT PRODUCTIVE ZONE AND PROPOSED NEW PRODUCTIVE ZONE. GIVE BLOWOUT PREVENTER PROGRAM, IF ANY.

I hereby certify that the information above is true and complete to the best of my knowledge and belief.

Signed H. L. Smith Title Agent Date March 5, 1968

(This space for State Use)

APPROVED BY [Signature] TITLE STATE OIL & GAS COMMISSIONER DATE March 5, 1968

CONDITIONS OF APPROVAL, IF ANY:

13 3/8

E-7-68

NEW MEXICO OIL CONSERVATION COMMISSION
WELL LOCATION AND ACREAGE DEDICATION PLAT

Form C-102
Supersedes C-128
Effective 1-1-65

All distances must be from the outer boundaries of the Section


Operator Coastal States Gas Producing Co.			Lease State		Well No. 1
Unit Letter L	Section 31	Township 13 South	Range 33 East	County Lea	
Actual Footage Location of Well: 1381 feet from the south line and 759 feet from the west line					
Ground Level Elev. 4284.8	Producing Formation Wolfcamp		Pool Undes. Baum	Dedicated Acreage: 80 75.07 Acres	

1. Outline the acreage dedicated to the subject well by colored pencil or hachure marks on the plat below.
2. If more than one lease is dedicated to the well, outline each and identify the ownership thereof (both as to working interest and royalty).
3. If more than one lease of different ownership is dedicated to the well, have the interests of all owners been consolidated by communitization, unitization, force-pooling, etc?

☐ Yes ☐ No If answer is "yes," type of consolidation _____

If answer is "no," list the owners and tract descriptions which have actually been consolidated. (Use reverse side of this form if necessary.) _____

No allowable will be assigned to the well until all interests have been consolidated (by communitization, unitization, forced-pooling, or otherwise) or until a non-standard unit, eliminating such interests, has been approved by the Commission.

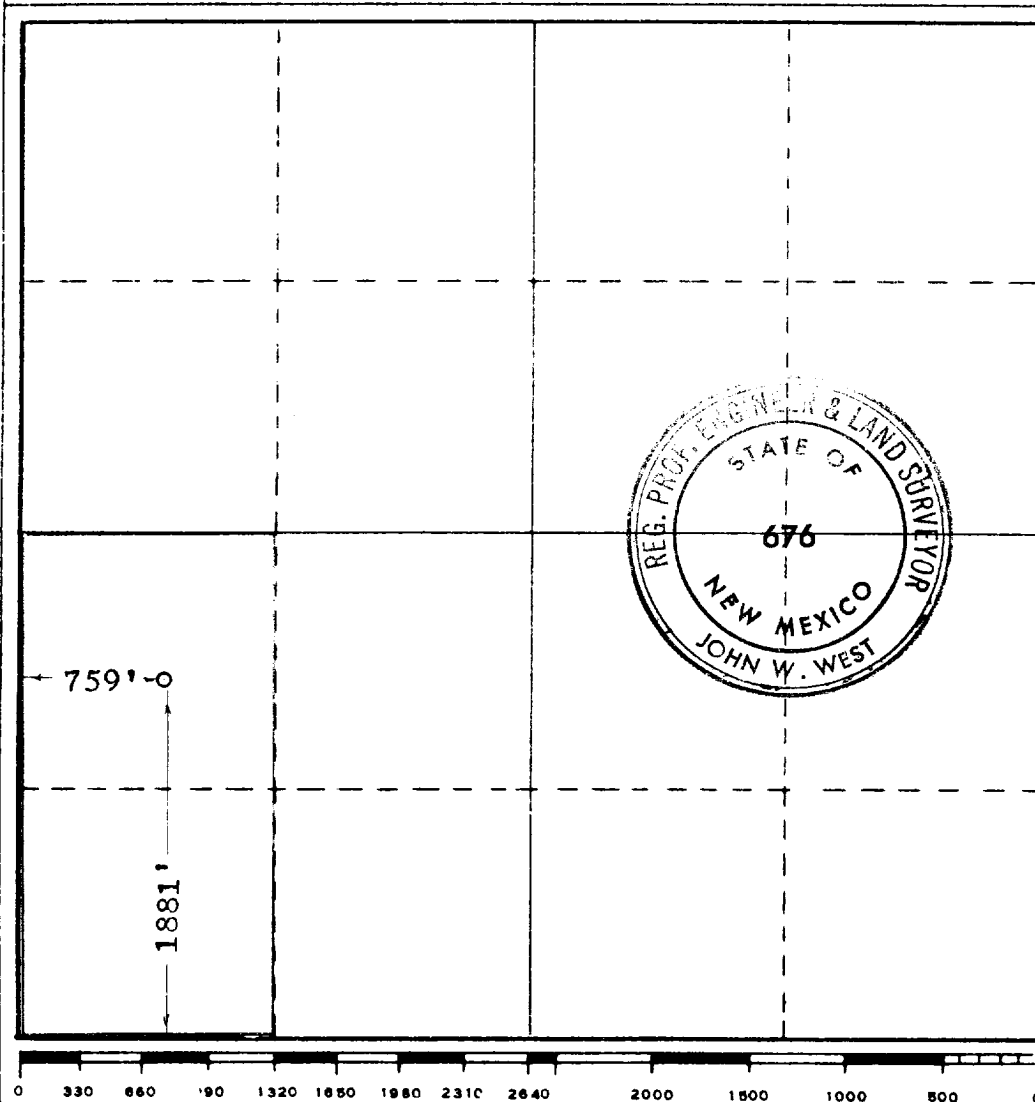

CERTIFICATION

I hereby certify that the information contained herein is true and complete to the best of my knowledge and belief.

Name **J. L. Smith**

Position
Agent

Company
Coastal States Gas Prod. Co.

Date
3/5/68

I hereby certify that the well location shown on this plat was plotted from field notes of actual surveys made by me or under my supervision, and that the same is true and correct to the best of my knowledge and belief.

Date Surveyed

Mar. 5, 1968

Registered Professional Engineer and/or Land Surveyor

John W. West

Certificate No.

676