

STATE OF NEW MEXICO
ENERGY AND MINERALS DEPARTMENT

OIL CONSERVATION DIVISION
P. O. BOX 2088
SANTA FE, NEW MEXICO 87501

Form C-101
Revised 10-1-78

NO. OF COPIES RECEIVED	
DISTRIBUTION	
SANTA FE	
FILE	
U.S.G.S.	
LAND OFFICE	
OPERATOR	

5A. Indicate Type of Lease
STATE ☐ REC ☒
5. State Oil & Gas Lease No.

APPLICATION FOR PERMIT TO DRILL, DEEPEN, OR PLUG BACK

1a. Type of Work DRILL <input type="checkbox"/> Re-enter <input type="checkbox"/> DEEPEN <input type="checkbox"/> PLUG BACK <input type="checkbox"/>		7. Unit Agreement Name
b. Type of Well OIL WELL <input type="checkbox"/> GAS WELL <input type="checkbox"/> OTHER <input checked="" type="checkbox"/> Water Disposal		8. Farm or Lease Name Lovington
2. Name of Operator Gill-Mc Oil Corporation		9. Well No. 2
3. Address of Operator c/o Oil Reports & Gas Services, Inc., Box 763, Hobbs, NM 88240		10. Field and Pool, or Wildcat Wildcat
4. Location of Well UNIT LETTER <u>P</u> LOCATED <u>660</u> FEET FROM THE <u>South</u> LINE AND <u>660</u> FEET FROM THE <u>East</u> LINE OF SEC. <u>14</u> TWP. <u>16S</u> RGE. <u>36E</u> NMPM		12. County Lea
19. Proposed Depth 8100		19A. Formation Glorieta
20. Rotary or C.T. Reverse Unit		
21. Elevations (Show whether DE, RT, etc.) 3861 GR	21A. Kind & Status Plug. Bond Blanket	21B. Drilling Contractor Baber Well Service
22. Approx. Date Work will start Upon Approval		

23.

PROPOSED CASING AND CEMENT PROGRAM

SIZE OF HOLE	SIZE OF CASING	WEIGHT PER FOOT	SETTING DEPTH	SACKS OF CEMENT	EST. TOP
17 1/4	13 3/8	54#	353	375	Circ.
11	8 5/8	32#	4829	3250	Circ.
7 7/8	5 1/2	15.5# & 17#	9614-10610	200	10,100

Above pipe now in hole

It is proposed to drill out to 9650, circulate hole clean,
spot 50 sx plug at 8100' & convert to disposal well

Formerly Shell Oil Company, Montieth #1, TD 11,226
P&A 1/12/54

IN ABOVE SPACE DESCRIBE PROPOSED PROGRAM; IF PROPOSAL IS TO DEEPEN OR PLUG BACK, GIVE DATA ON PRESENT PRODUCTIVE ZONE AND PROPOSED NEW PRODUCTIVE ZONE. GIVE BLOWOUT PREVENTER PROGRAM, IF ANY.

I hereby certify that the information above is true and complete to the best of my knowledge and belief.

Signed Hermann Hols Title Agent Date 5/23/80

(This space for State Use)

APPROVED BY Garry Sexton TITLE SUPERVISOR DISTRICT 1 DATE May 15 1980

CONDITIONS OF APPROVAL, IF ANY:

**NEW MEXICO OIL CONSERVATION COMMISSION
WELL LOCATION AND ACREAGE DEDICATION PLAT**

Form C-102
Supersedes C-128
Effective 1-1-65

All distances must be from the outer boundaries of the Section.


Operator Gil-Mc Oil Corporation			Lease Lovington		Well No. 2
Unit Letter P	Section 14	Township 16 S	Range 36 E	County Lea	
Actual Fringe Location of Well: 660 feet from the South line and 660 feet from the East line					
Ground Level Elev. 3861	Producing Formation Glorieta		Pool Wildcat		Dedicated Acreage: 40 Acres

1. Outline the acreage dedicated to the subject well by colored pencil or hachure marks on the plat below.
2. If more than one lease is dedicated to the well, outline each and identify the ownership thereof (both as to working interest and royalty).
3. If more than one lease of different ownership is dedicated to the well, have the interests of all owners been consolidated by communitization, unitization, force-pooling, etc?

☐ Yes ☐ No If answer is "yes," type of consolidation _____

If answer is "no," list the owners and tract descriptions which have actually been consolidated. (Use reverse side of this form if necessary.) _____

No allowable will be assigned to the well until all interests have been consolidated (by communitization, unitization, forced-pooling, or otherwise) or until a non-standard unit, eliminating such interests, has been approved by the Commission.

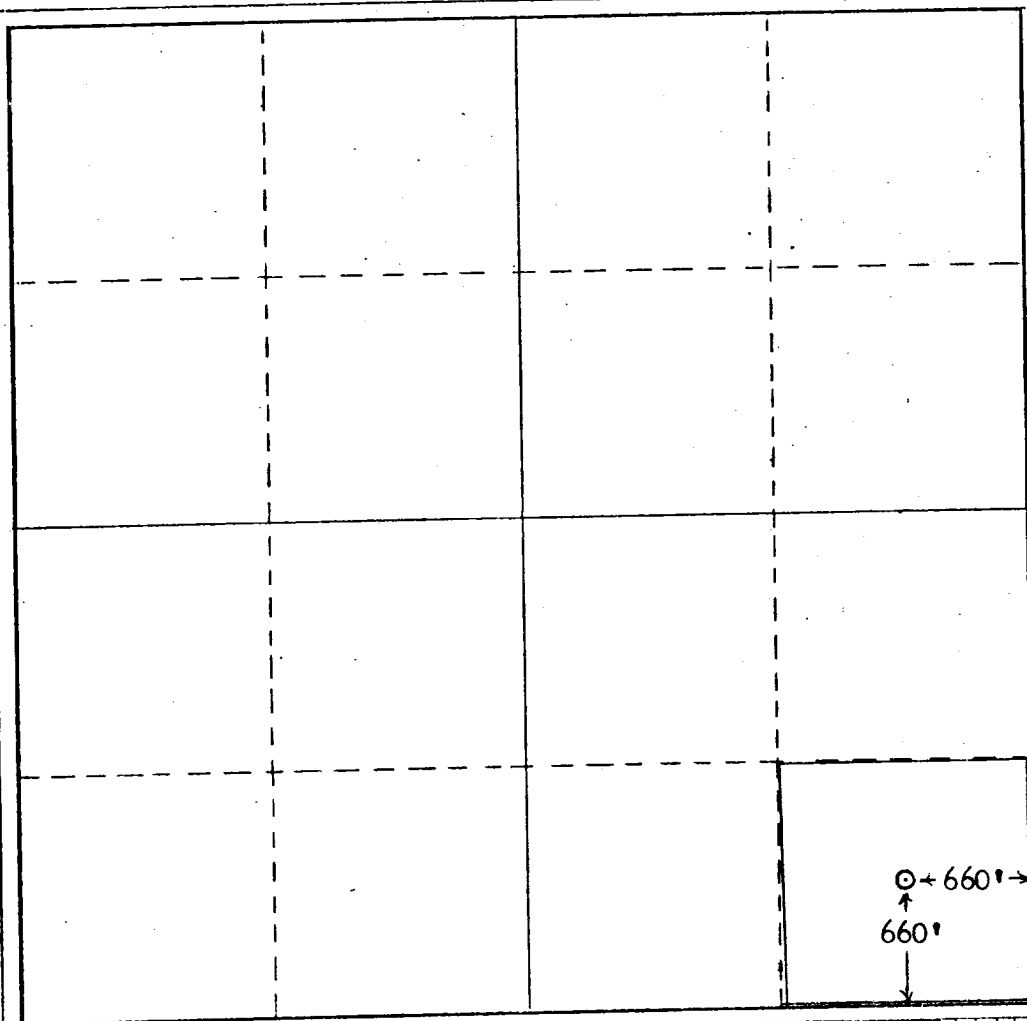

CERTIFICATION

I hereby certify that the information contained herein is true and complete to the best of my knowledge and belief.

Name
Danva Hollis
Position
Agent

Company
Gil-Mc Oil Corporation

Date
May 23, 1980

I hereby certify that the well location shown on this plat was plotted from field notes of actual surveys made by me or under my supervision, and that the same is true and correct to the best of my knowledge and belief.

Date Surveyed

Registered Professional Engineer and/or Land Surveyor

Certificate No.

0 330 660 990 1320 1650 1980 2310 2640 2000 1500 1000 500 0