

## NEW MEXICO OIL CONSERVATION COMMISSION

Santa Fe, New Mexico

## NOTICE OF INTENTION TO DRILL

MAR 26 1945


Notice must be given to the Oil Conservation Commission or its proper agent and approval obtained before drilling begins. If changes in the proposed plan are considered advisable, a copy of this notice showing such changes will be returned to the sender. Submit this notice in triplicate. One copy will be returned following approval. See additional instructions in Rules and Regulations of the Commission.

Dallas, Texas  
PlaceMarch 17, 1945  
Date

OIL CONSERVATION COMMISSION,  
Santa Fe, New Mexico.  
Gentlemen:

You are hereby notified that it is our intention to commence the drilling of a well to be known as \_\_\_\_\_

Magnolia Petroleum Company State "Q" Well No. 3 in C SW SW  
Company or Operator Lease  
of Sec. 33, T. 16S, R. 36E, N. M. P.M., S. Lovington Field, Lea County.  
N. 16S  
The well is 660 feet (N.) (~~S~~) of the S line and 660 feet

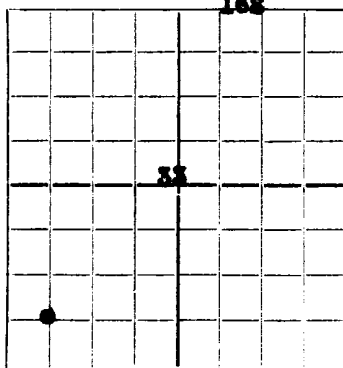

AREA 640 ACRES  
LOCATE WELL CORRECTLY

(E.) (~~W~~) of the W line of SW 1/4 Section

(Give location from section or other legal subdivision lines. Cross out wrong directions.)

If state land the oil and gas lease is No. \_\_\_\_\_, Assignment No. \_\_\_\_\_

If patented land the owner is \_\_\_\_\_

Address \_\_\_\_\_

If government land the permittee is \_\_\_\_\_

Address \_\_\_\_\_

The lessee is Magnolia Petroleum Company

Address Box 900. Dallas 1, Texas

We propose to drill well with drilling equipment as follows: Rotary

The status of a bond for this well in conformance with Rule 39 of the General Rules and Regulations of the Commission is as follows: Financial statement of Magnolia Petroleum Company filed with Commission and in First Judicial District of New Mexico.

We propose to use the following strings of casing and to land or cement them as indicated:

| Size of Hole | Size of Casing | Weight Per Foot | New or Second Hand | Depth | Landed or Cemented | Sacks Cement |
|--------------|----------------|-----------------|--------------------|-------|--------------------|--------------|
| 17"          | 13 5/8"        | 48              | New                | 250'  | Cemented           | 250          |
| 11"          | 8 5/8"         | 28              | New                | 2000' | Cemented           | 250          |
| 7 7/8"       | 5 1/2"         | 14              | New                | 5000' | Cemented           | 200          |

If changes in the above plan become advisable we will notify you before cementing or landing casing. We estimate that the first productive oil or gas sand should occur at a depth of about 5000 feet.

Additional information:

MAR 26 1945

Approved \_\_\_\_\_, 19\_\_\_\_  
except as follows:

"APPROVAL CONDITIONED UPON  
COMPLIANCE WITH REQUIREMENTS  
OF ORDER NO. 157"

OIL CONSERVATION COMMISSION,

By

Title

Sincerely yours,

Magnolia Petroleum Company  
Company or Operator

By

Position Clerk

Send communication regarding well to

Name K. BullockAddress Box 900 - Dallas 1, Texas

THE UNIVERSITY OF CHICAGO

DEPARTMENT OF THE HISTORY OF ARTS

THE UNIVERSITY OF CHICAGO PRESS  
54 EAST LAKE STREET, CHICAGO, ILLINOIS 60601-1306  
TEL: 773-936-3400 FAX: 773-936-3401

THE UNIVERSITY OF CHICAGO PRESS  
54 EAST LAKE STREET, CHICAGO, ILLINOIS 60601-1306  
TEL: 773-936-3400 FAX: 773-936-3401  
WWW.CHICAGO.PRESS.EDU

THE UNIVERSITY OF CHICAGO PRESS  
54 EAST LAKE STREET, CHICAGO, ILLINOIS 60601-1306  
TEL: 773-936-3400 FAX: 773-936-3401  
WWW.CHICAGO.PRESS.EDU

# Magnolia Petroleum Company

**PRODUCING DEPARTMENT**

Location made March 16, 195


State Q Well No. 3

Lea District

Lease NM-604 acres 520, Sec. 33, T 16 S, R 36 E } District  
Township

Lea County, New Mexico

Scale 1" = 500' N S E W

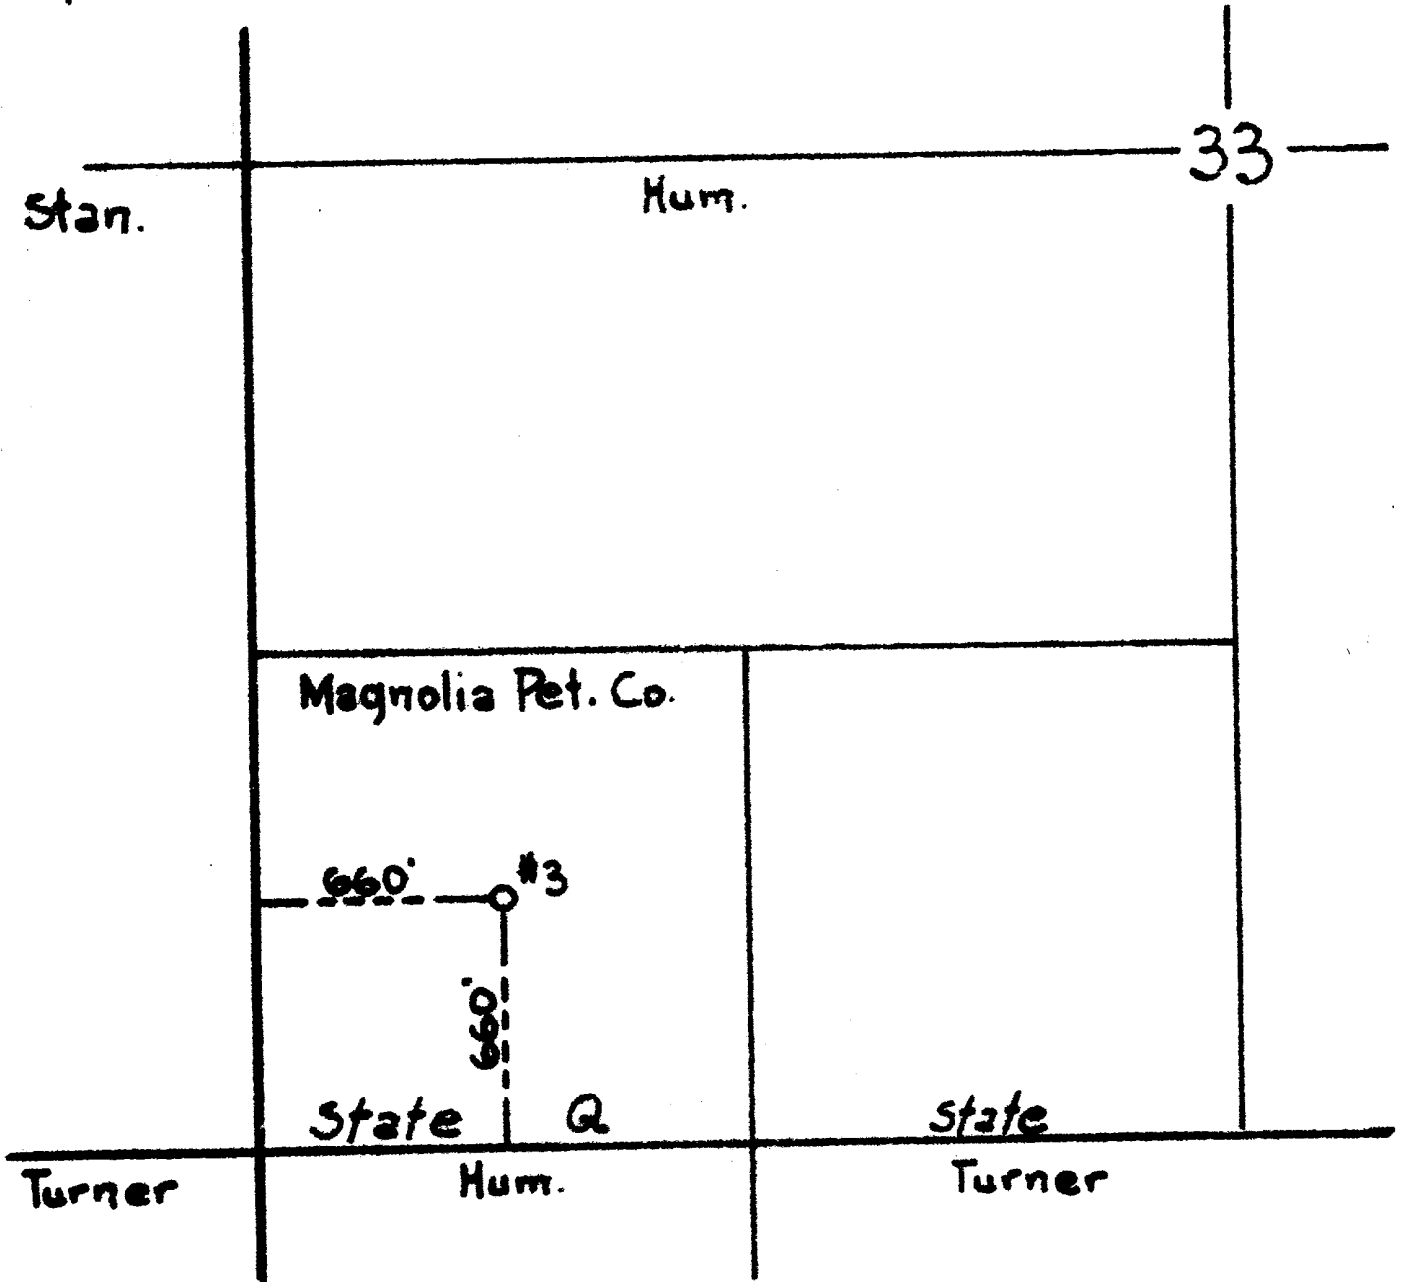

Reserve None

Special instructions \_\_\_\_\_

ion changed on account of \_\_\_\_\_

work is commenced \_\_\_\_\_, 194\_\_\_\_\_ Supt.

on approved by \_\_\_\_\_ Plat made by Ben L. Johnson

**Magnolia Petroleum Company**  
**PRODUCING DEPARTMENT**

Location for Well No. \_\_\_\_\_

File No. \_\_\_\_\_