

Santa Fe, New Mexico

Corrected

## NOTICE OF INTENTION TO DRILL

Notice must be given to the Oil Conservation Commission or its proper agent and approval obtained before drilling begins. If changes in the proposed plan are considered advisable, a copy of this notice showing such changes will be returned to the sender. Submit this notice in triplicate. One copy will be returned following approval. See additional instructions in Rules and Regulations of the Commission.

Bartlesville, Oklahoma4-24-1951

Place

Date

OIL CONSERVATION COMMISSION,  
Santa Fe, New Mexico,

Gentlemen:

You are hereby notified that it is our intention to commence the drilling of a well to be known as \_\_\_\_\_


Phillips Petroleum Company  
Company or Operator

Denton  
Lease

Well No. 2 in SE/4 NE/4

of Sec. 11, T. 15S, R. 37E, N. M., P. M., Denton Field, Lea County.

N

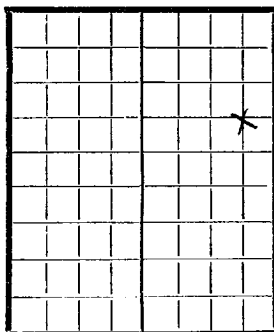

AREA 640 ACRES

LOCATE WELL CORRECTLY

The well is 658 feet (N.) (~~SW~~ of the South line and 662 feet (E.) ~~SW~~ of the West line of NE/4

(Give location from section or other legal subdivision lines. Cross out wrong directions.)

If state land the oil and gas lease is No. \_\_\_\_\_ Assignment No. \_\_\_\_\_

If patented land the owner is James M. Denton

Address Brownfield, Texas

If government land the permittee is \_\_\_\_\_

Address \_\_\_\_\_

The lessee is Phillips Petroleum Company J. H. McClure (Assignor)

Address Bartlesville, Oklahoma Midland, Texas

We propose to drill well with drilling equipment as follows: Drill with rotary

to depth sufficient to the Devonian.

The status of a bond for this well in conformance with Rule 39 of the General Rules and Regulations of the Commission is as follows: Blanket Bond

We propose to use the following strings of casing and to land or cement them as indicated:

Size of Hole	Size of Casing	Weight Per Foot	New or Second Hand	Depth	Landed or Cemented	Sacks Cement
17 1/4"	13 3/8"	27.3#	New	300'	Cemented	Circulate
11"	8 5/8"	28 & 32#	New	4,800'	Cemented	Circulate
7 7/8"	5 1/2"	17 & 20#	New	11,500'	Cemented	Sufficient cement to tie in base of 8 5/8"

If changes in the above plan become advisable we will notify you before cementing or landing casing. We estimate that the first productive oil or gas sand should occur at a depth of about 11,500 feet.

Additional information: Corrected form being furnished to change well location.

MAY 14 1951

Approved \_\_\_\_\_, 19\_\_\_\_

except as follows:

Sincerely yours,

Phillips Petroleum Company  
Company or Operator

By B. H. Pulsifer

Position Asst. Chief Clerk

Send communications regarding well to

Name Mr. C. P. Dimit, Vice-President

Address Bartlesville, Oklahoma

OIL CONSERVATION COMMISSION,

By R. R. Garrison

Title SECRETARY DIRECTOR

Gulf

Atlantic  
Dallas, Tex.


Gulf  
Houston Tex.

Atlantic

Shell  
Houston, Tex.

Phillips Petr. Co.  
"Denton"

Atlantic

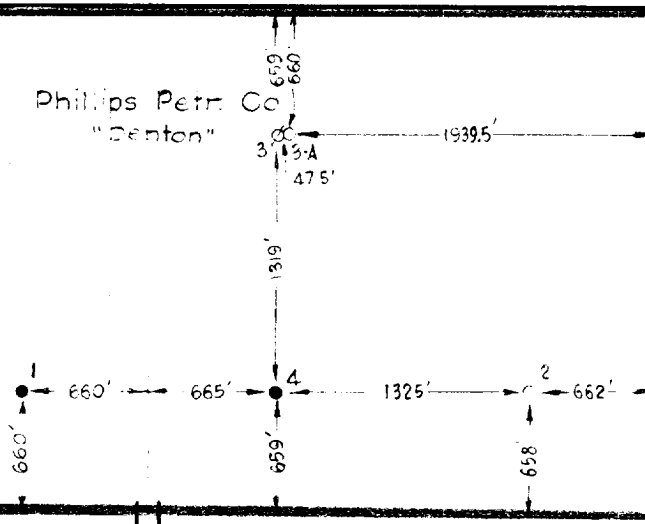

Ohio Oil  
Findlay, Ohio

H.L. Lowe  
Address Unknown

Gulf

W.L. Duthitt  
Address Unknown

Atlantic

PHILLIPS PETROLEUM CO.

BARTLESVILLE, OKLA.

DENTON LEASE - 320.0 ACRES  
N.  $\frac{1}{2}$  OF SEC. II, TWP. 15 S. R. 37 E.  
LEA CO. NEW MEXICO

DRAWN BY R.E.V.

8-28-50

SCALE 1"=1000'

CONTRACT NO.

DRAWING NO.

I,..... R. L. Pulsifer....., being first duly sworn on oath, state that I have knowledge of the facts and matter herein set forth on this plat and that the same are true and correct.

Name..... *R. L. Pulsifer*..... Title..... Asst. Chief Clerk.....  
Subscribed and sworn to before me this *24th* day of *April*, 19*51*.....  
Notary Public..... Washington..... County,..... okla.....

*Mary E. Huling*

RAYE P. ...