

Submit to Appropriate
District Office
State Lease - 6 copies
Fee Lease - 3 copies

State of New Mexico
Energy, Minerals and Natural Resources Department

Form C-101
Revised 1-1-89

OIL CONSERVATION DIVISION

P.O. Box 2088
Santa Fe, New Mexico 87504-2088

DISTRICT I
P.O. Box 1980, Hobbs, NM 88240

DISTRICT II
P.O. Drawer DD, Artesia, NM 88210

DISTRICT III
1000 Rio Brazos Rd., Aztec, NM 87410

API NO. (assigned by OCD on New Wells)
30-025-31030
5. Indicate Type of Lease STATE ☒ FEE ☐
6. State Oil & Gas Lease No. B7896

APPLICATION FOR PERMIT TO DRILL, DEEPEN, OR PLUG BACK					
1a. Type of Work: DRILL ☒ RE-ENTER ☐ DEEPEN ☐ PLUG BACK ☐				7. Lease Name or Unit Agreement Name	
b. Type of Well: OIL WELL ☒ GAS WELL ☐ OTHER ☐				Lovington San Andres Unit	
2. Name of Operator Greenhill Petroleum Corporation				8. Well No. 67	
3. Address of Operator 16010 Barker's Point Lane, Ste. 325, Houston, Texas 77079				9. Pool name or Wildcat Lovington Grayburg San Andres	
4. Well Location Unit Letter <u>I</u> : <u>2444</u> Feet From The <u>South</u> Line and <u>281</u> Feet From The <u>West</u> Line Section <u>31</u> Township <u>16 South</u> Range <u>37 East</u> NMPM <u>Lea</u> County					
10. Proposed Depth 5100'		11. Formation San Andres		12. Rotary or C.T. Rotary	
13. Elevations (Show whether DF, RT, GR, etc.) 3827.4 GR		14. Kind & Status Plug. Bond Blanket on File		15. Drilling Contractor TBD	
16. Approx. Date Work will start 10/01/90					
17. PROPOSED CASING AND CEMENT PROGRAM					
SIZE OF HOLE	SIZE OF CASING	WEIGHT PER FOOT	SETTING DEPTH	SACKS OF CEMENT	EST. TOP
12 1/4	8 3/8	24	350'	300	Surface
7 7/8	5 1/2	15.5	5100'	500	3000'

IN ABOVE SPACE DESCRIBE PROPOSED PROGRAM: IF PROPOSAL IS TO DEEPEN OR PLUG BACK, GIVE DATA ON PRESENT PRODUCTIVE ZONE AND PROPOSED NEW PRODUCTIVE ZONE. GIVE BLOWOUT PREVENTER PROGRAM, IF ANY.

I hereby certify that the information above is true and complete to the best of my knowledge and belief.

SIGNATURE Richard J. Newport TITLE Landman DATE 9/13/90
TYPE OR PRINT NAME Michael J. Newport TELEPHONE NO. 713 9551146

(This space for State Use)

Orig. Sign.
Paul Kautz
Geologist

APPROVED BY _____ TITLE _____ DATE OGT 02 1990

CONDITIONS OF APPROVAL, IF ANY:

Permit Expires 6 Months From Approval
Date Unless Drilling Underway

NSL-2878

acreage 49.56

Submit to Appropriate
District Office
State Lease - 4 copies
Fee Lease - 3 copies

State of New Mexico
Bureau of Geology, Minerals and Natural Resources Department

Form C-102
Revised 1-1-89

OIL CONSERVATION DIVISION

P.O. Box 2088
Santa Fe, New Mexico 87504-2088

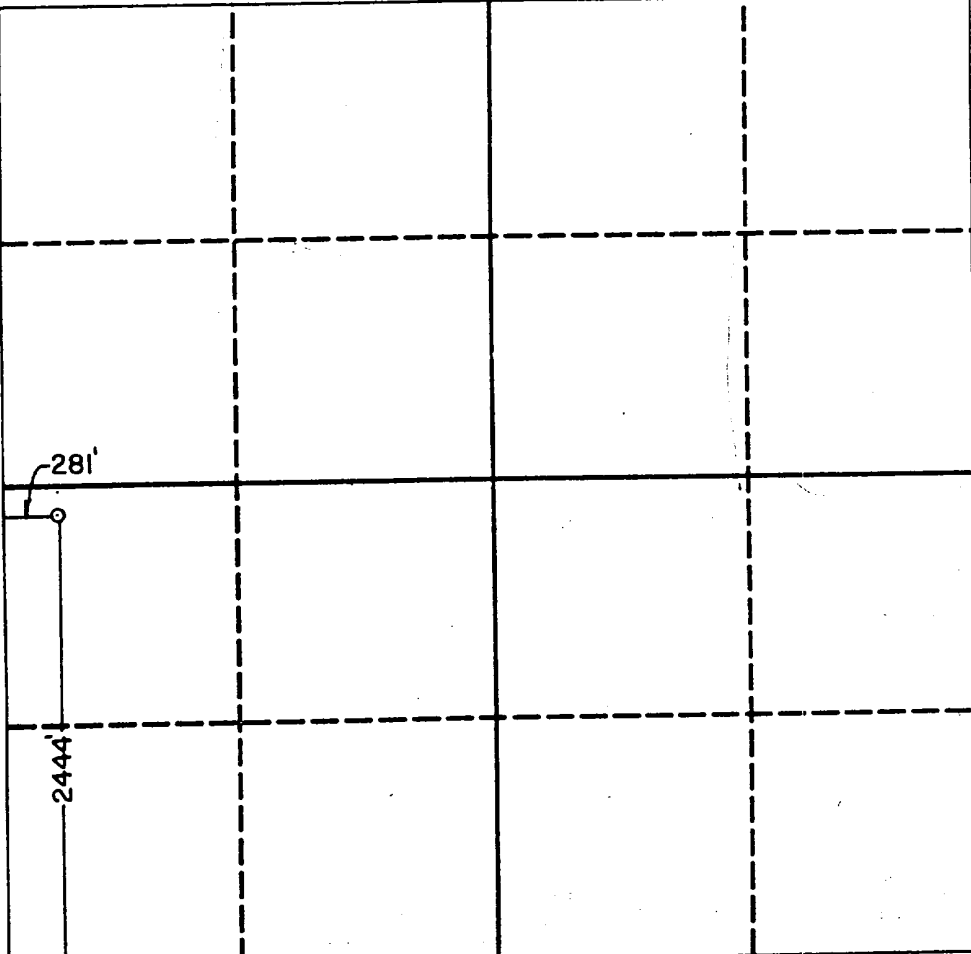
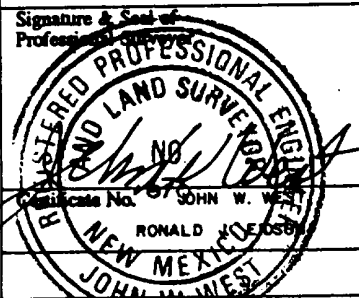
DISTRICT I
P.O. Box 1980, Hobbs, NM 88240

DISTRICT II
P.O. Drawer DD, Artesia, NM 88210

DISTRICT III
1000 Rio Brazos Rd., Aztec, NM 87410

WELL LOCATION AND ACREAGE DEDICATION PLAT

All Distances must be from the outer boundaries of the section

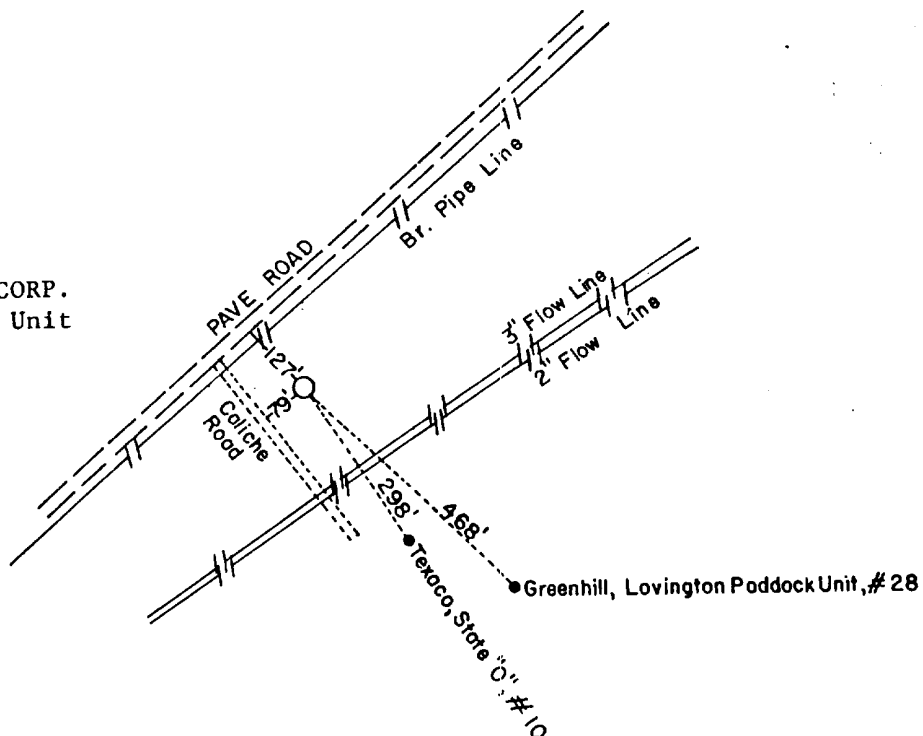
Operator GREENHILL PETROLEUM CORP.		Lease Lovington San Andres Unit		Well No. 67
Unit Letter L	Section 31	Township 16 South	Range 37 East	County Lea
Actual Footage Location of Well: 2444 feet from the South line and 281 feet from the West line				
Ground level Elev. 3827.4	Producing Formation San Andres	Pool Lovington GB/SA	Dedicated Acreage: 49.50 Acres	
1. Outline the acreage dedicated to the subject well by colored pencil or hatchure marks on the plat below. 2. If more than one lease is dedicated to the well, outline each and identify the ownership thereof (both as to working interest and royalty). 3. If more than one lease of different ownership is dedicated to the well, have the interest of all owners been consolidated by communitization, unitization, force-pooling, etc.? ☐ Yes ☐ No If answer is "yes" type of consolidation <u>Unitized</u> If answer is "no" list the owners and tract descriptions which have actually been consolidated. (Use reverse side of this form if necessary.) No allowable will be assigned to the well until all interests have been consolidated (by communitization, unitization, forced-pooling, or otherwise) or until a non-standard unit, eliminating such interest, has been approved by the Division.				
			OPERATOR CERTIFICATION I hereby certify that the information contained herein is true and complete to the best of my knowledge and belief. Signature: <u>Michael J. Newport</u> Printed Name: <u>Michael J. Newport</u> Position: <u>Landman</u> Company: <u>Greenhill Pet. Corp.</u> Date: <u>9-13-90</u>	
			SURVEYOR CERTIFICATION I hereby certify that the well location shown on this plat was plotted from field notes of actual surveys made by me or under my supervision, and that the same is true and correct to the best of my knowledge and belief. Date Surveyed: <u>August 21, 1990</u> Signature & Seal of Professional Surveyor:  Certificate No. <u>676</u> RONALD W. WEST JOHN W. WEST 3239	

SECTION 31, TOWNSHIP
LEA COUNTY,

16 SOUTH, RANGE 37 EAST, N.M.P.M.,
NEW MEXICO



GREENHILL PETROLEUM CORP.
Lovington San Andres Unit
Well No. 67
Gr. Elev. 3827.4



I HEREBY CERTIFY THAT THIS PLAT
WAS MADE FROM NOTES TAKEN IN THE FIELD
IN A BONA FIDE SURVEY MADE UNDER MY
SUPERVISION, AND THAT THE SAME IS TRUE
AND CORRECT TO THE BEST OF MY KNOWL-
EDGE AND BELIEF.

John W. West
JOHN W. WEST, N.M. P.E. & L.S. No. 676
TEXAS R.P.S. No. 1138
RONALD J. EIDSON, N.M. L.S. No. 3239
TEXAS R.P.S. No. 1883

GREENHILL PETROLEUM CORP.

Topo around the Lovington San Andres Unit, Well
No. 67, located 2444 feet from the South line
and 281 feet from the West line of Section 31,
Township 16 South, Range 37 East, N.M.P.M.,
Lea County, New Mexico.

JOHN W. WEST ENGINEERING COMPANY

CONSULTING ENGINEERS

HOBBS, NEW MEXICO

Scale: 1"=300'

Drawn By: Presley

Date: 8/27/90

Ch. GJ

Sheet 1 of 1 Sheets