

NEW XICO OIL CONSERVATION COMMISSION
WELL LOCATION AND ACREAGE DEDICATION PLAT

Form C-128
Supersedes C-128
Effective 1-1-66

All distances must be from the outer boundaries of the Section.


Operator Amerada Petroleum Corporation			Lease H.D. McKinley		Well No. 9
Section F	Section 30	Township 18-S	Range 38-E	County Lea	
Actual Well Location of Well 2392.5		West 2557.5		North	
Ground Level Elev. Ogallala		Undesignated		Estimated Acreage 40	

1. Outline the acreage dedicated to the subject well by colored pencil or lecture marks on the plat below.
2. If more than one lease is dedicated to the well, outline each and identify the ownership thereof (both as to working interest and royalty).
3. If more than one lease of different ownership is dedicated to the well, have the interests of all owners been consolidated by communitization, unitization, force pooling, etc?

☐ Yes ☐ No If answer is "yes," type of consolidation _____

If answer is "no," list the owners and tract descriptions which have actually been consolidated. (Use reverse side of this form if necessary.) _____

No allowable will be assigned to the well until all interests have been consolidated (by communitization, unitization, forced-pooling, or otherwise) or until a non-standard unit, eliminating such interests, has been approved by the Commission.

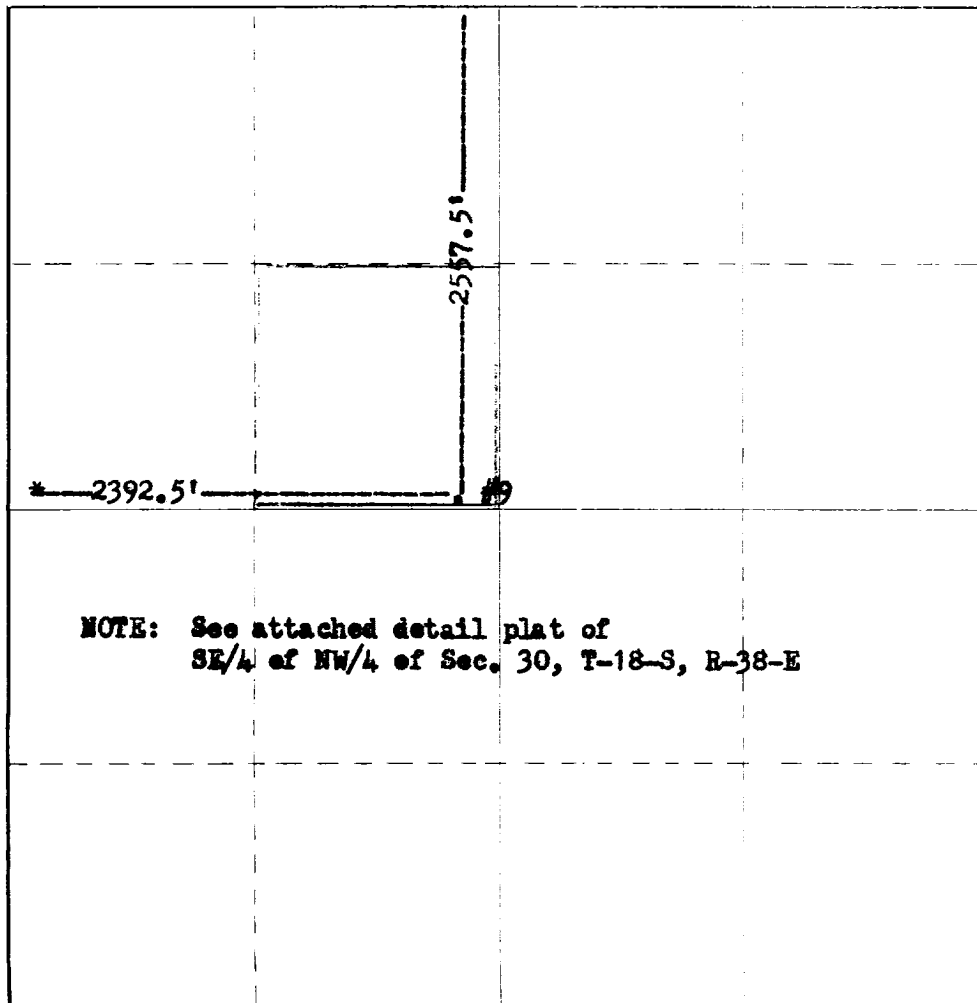

CERTIFICATION

I hereby certify that the information contained herein is true and complete to the best of my knowledge and belief.

B. J. King
District Superintendent
Amerada Petroleum Corp.

June 23, 1967

I hereby certify that the well location shown on this plat was plotted from field notes of actual surveys made by me or under my supervision, and that the same is true and correct to the best of my knowledge and belief.

June 22, 1967
District Superintendent


By District Superintendent

June 22, 1967
District Superintendent

0 350 650 950 485750

AMERADA PETROLEUM CORP.

JUN 27 11 25 AM '67

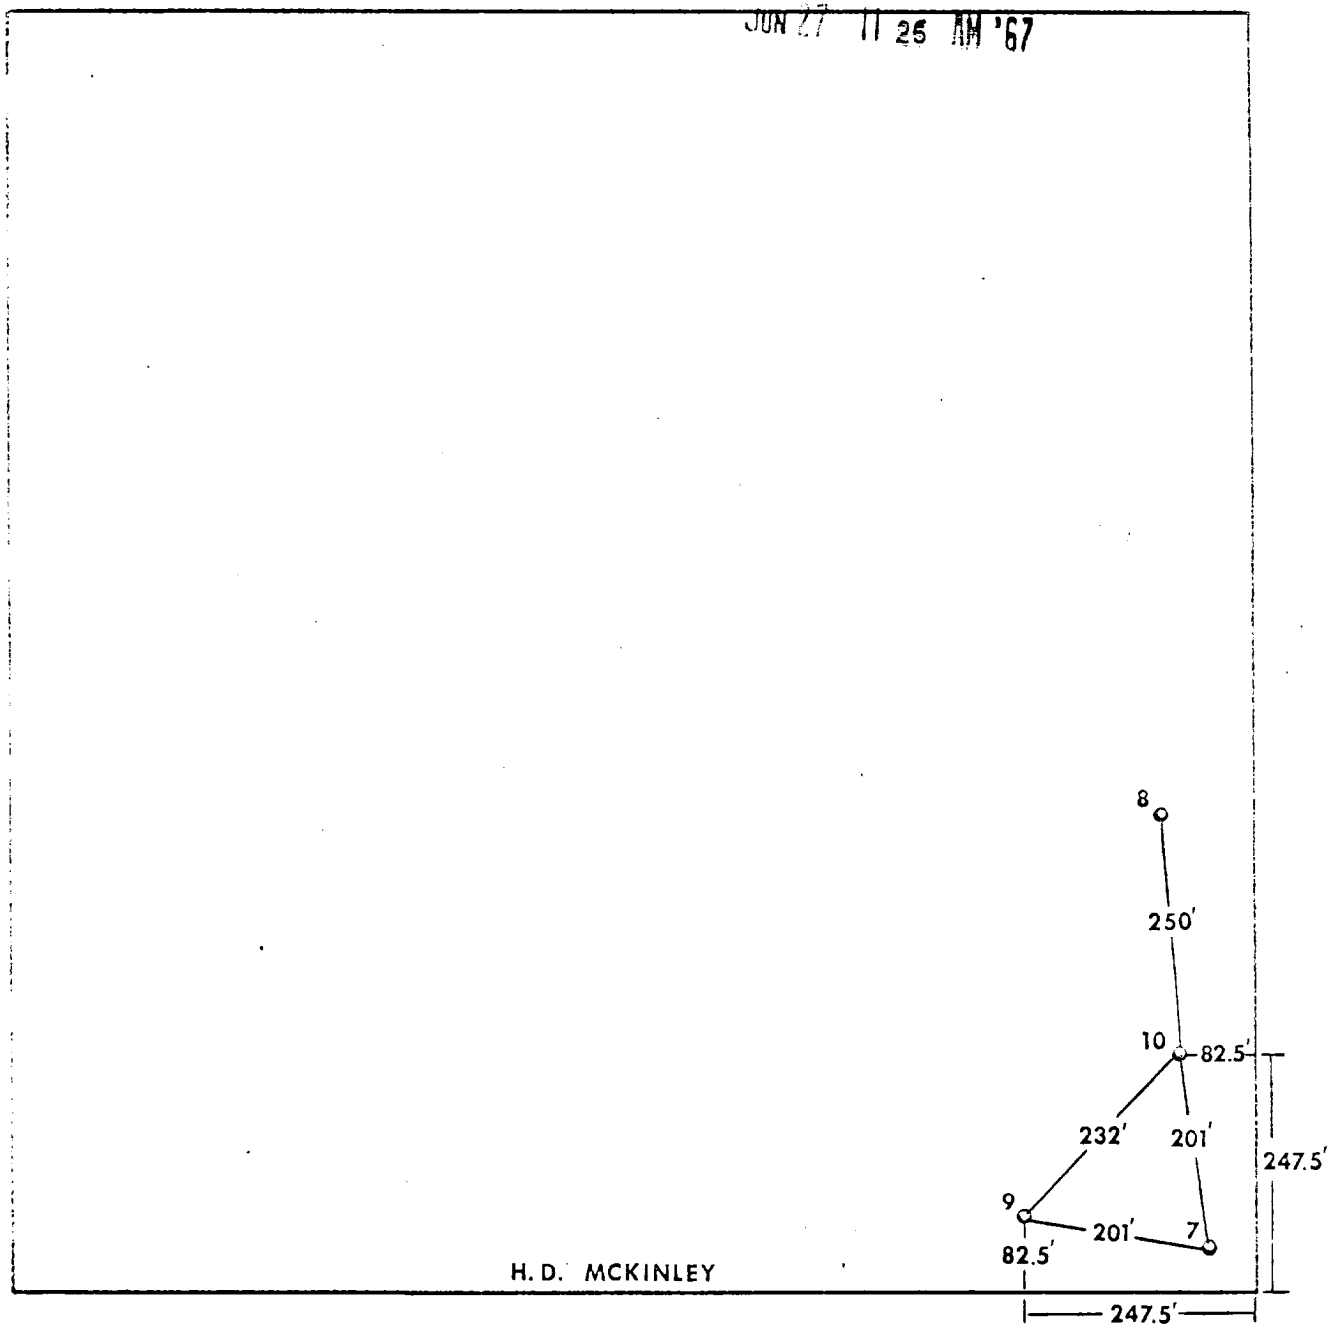

AMERADA PETROLEUM CORPORATION

OGALLALA FORMATION

LEA COUNTY, NEW MEXICO

SE 1/4 OF NW 1/4

SEC. 30, T-18-S, R-38-E

SCALE 1" = 200'