

NEW MEXICO OIL CONSERVATION COMMISSION

Santa Fe, New Mexico

NOTICE OF INTENTION TO DRILL

Notice must be given to the Oil Conservation Commission or its proper agent and approval obtained before drilling begins. If changes in the proposed plan are considered advisable, a copy of this notice showing such changes will be returned to the sender. Submit this notice in triplicate. One copy will be returned following approval. See additional instructions in Rules and Regulations of the Commission.

Dallas, Texas

Place

August 24, 1944

Date

OIL CONSERVATION COMMISSION,
Santa Fe, New Mexico.

Gentlemen:

You are hereby notified that it is our intention to commence the drilling of a well to be known as

Magnolia Petroleum Company

State "R"

Well No. 6

in C. of NW NE

Company or Operator

Lease

of Sec. 4, T. 17S, R. 36E, N. M. P. M., N. Lovington Field, Lea County

N.

The well is 660 feet ~~xx~~ (S.) of the N. line and 660 feet

(E.) ~~xx~~ of the W line of NE $\frac{1}{4}$

(Give location from section or other legal subdivision lines. Cross out wrong directions)

If state land the oil and gas lease is No. No. D-3009 Assignment No. Original

If patented land the owner is

Address


If government land the permittee is

Address

The lessee is Magnolia Petroleum Company

Address Box 900 - Dallas 1, Texas

We propose to drill well with drilling equipment as follows: Rotary Tools

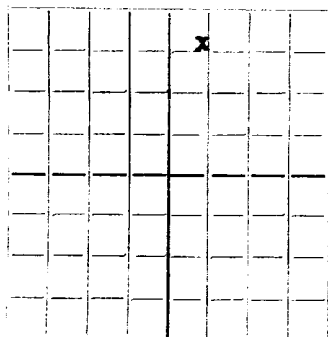

AREA 640 ACRES
LOCATE WELL CORRECTLY

The status of a bond for this well in conformance with Rule 39 of the General Rules and Regulations of the Commission is as follows: Financial statement of Magnolia Petroleum Company filed with Commission and in First Judicial District of New Mexico.

We propose to use the following strings of casing and to land or cement them as indicated:

Size of Hole	Size of Casing	Weight Per Foot	New or Second Hand	Depth	Landed or Cemented	Sacks Cement
17"	13"	48	New	250	Cemented	250
11"	8 5/8"	28	New	2000	Cemented	250
7 7/8"	5 1/2"	14	New	5000	Cemented	200

If changes in the above plan become advisable we will notify you before cementing or landing casing. We estimate that the first productive oil and gas sand should occur at a depth of about 5000 feet.

Additional information:

Approved _____, 19_____
except as follows:

Sincerely yours,

MAGNOLIA PETROLEUM COMPANY

Company or Operator

By

A. Bullock

Position

Clerk

Send communications regarding well to

Name

K. Bullock

Address

Box 900 - Dallas 1, Texas

OIL CONSERVATION COMMISSION

By

Roy Yarbrough

Title

Magnolia Petroleum Company
PRODUCING DEPARTMENT

Location made August 24, 1944


State "R" Well No. 6

Lea District

Lease NM-614, acres 717.78 Lots 1 & 2, Sec. 4, T17S, R36E { District Township

Lea County, New Mexico

Scale 1" = 800' N S E W

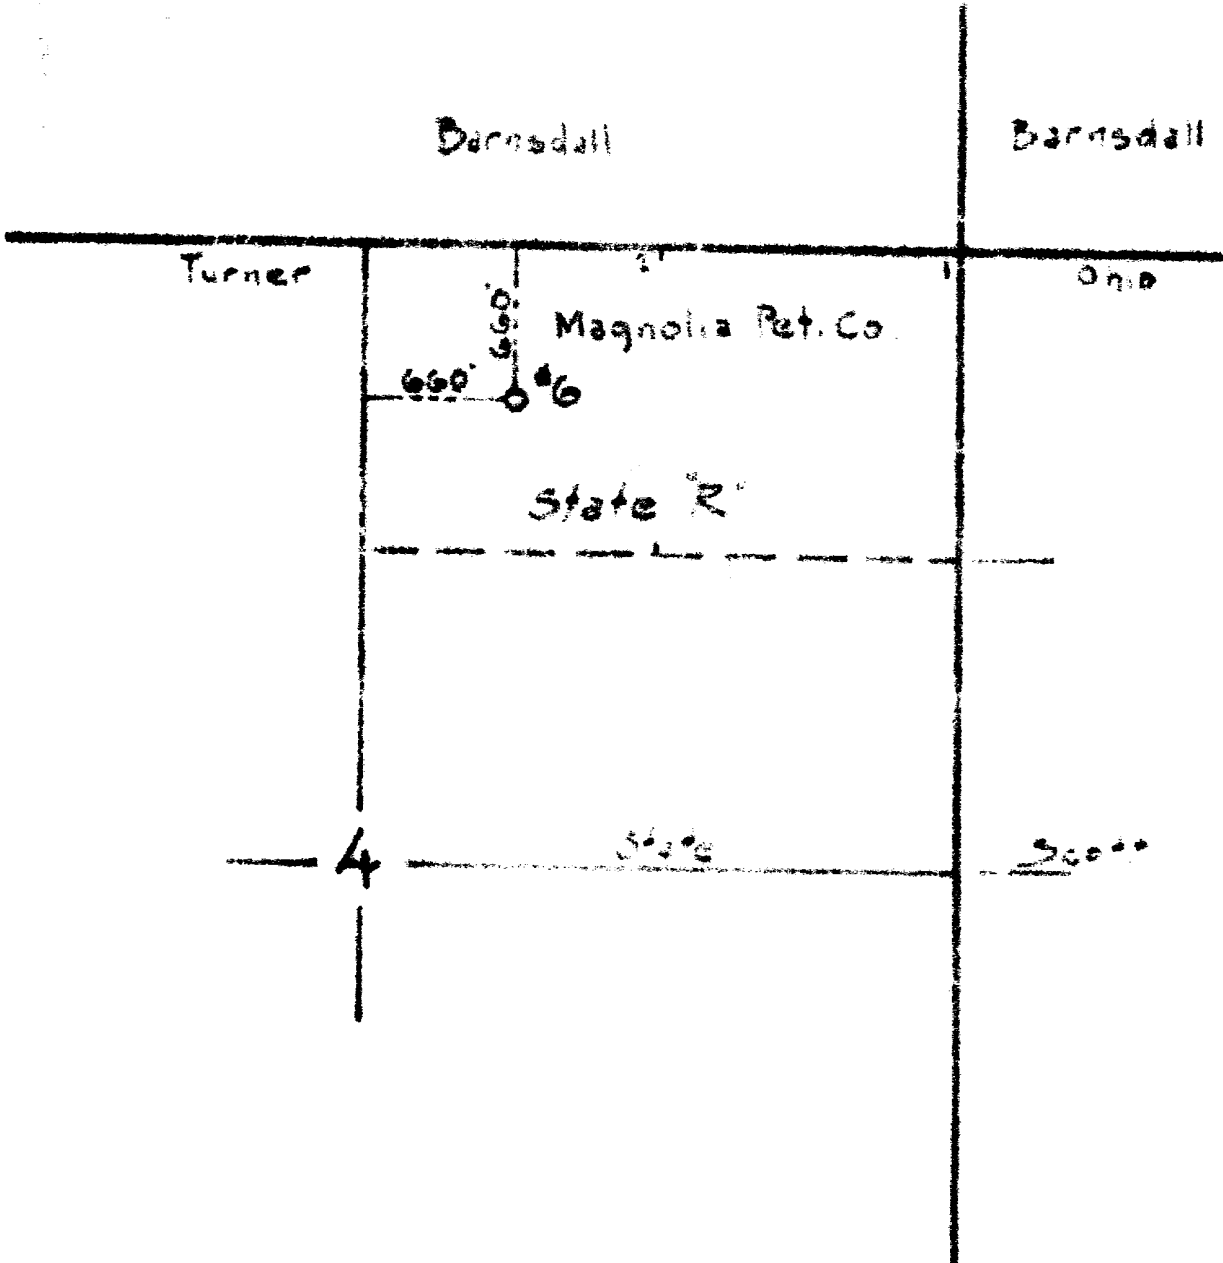

Reserve None

Special instructions

Location changed on account of

Date work is commenced _____, 194____ Supt.

Location approved by _____ Plat made by Ben C. Johnson

Magnolia Petroleum Company
PRODUCING DEPARTMENT

Location for Well No. _____

File No. _____