

NEW MEXICO OIL CONSERVATION COMMISSION
WELL LOCATION AND ACREAGE DEDICATION

RECORD COPY
ODESSA CENTRAL FILES


All distances must be from the outer boundaries of the Section

Phillips Petroleum Company		State 22	
D	22	17 South	35 East
660	North	660	West
3949.8'	Atoka	Wildcat Wolfcamp	160 40
		South Shoe Bar-Atoka	

- 1 Outline the acreage dedicated to the subject well by colored pencil or hatchure marks on the plat below
 - 2 If more than one lease is dedicated to the well, outline each and identify the ownership thereof (both as to working interest and royalty)
 - 3 If more than one lease of different ownership is dedicated to the well, have the interests of all owners been consolidated by communitization, unitization, force-pooling, etc?
- ☐ Yes ☐ No If answer is "Yes" type of consolidation _____

If answer is "no" list the owners and tract descriptions which have actually been consolidated (Use reverse side of this form if necessary) _____

No allowable will be assigned to the well until all interests have been consolidated (by communitization, unitization, forced-pooling, or otherwise) or until a non-standard unit, eliminating such interests, has been approved by the Commission.

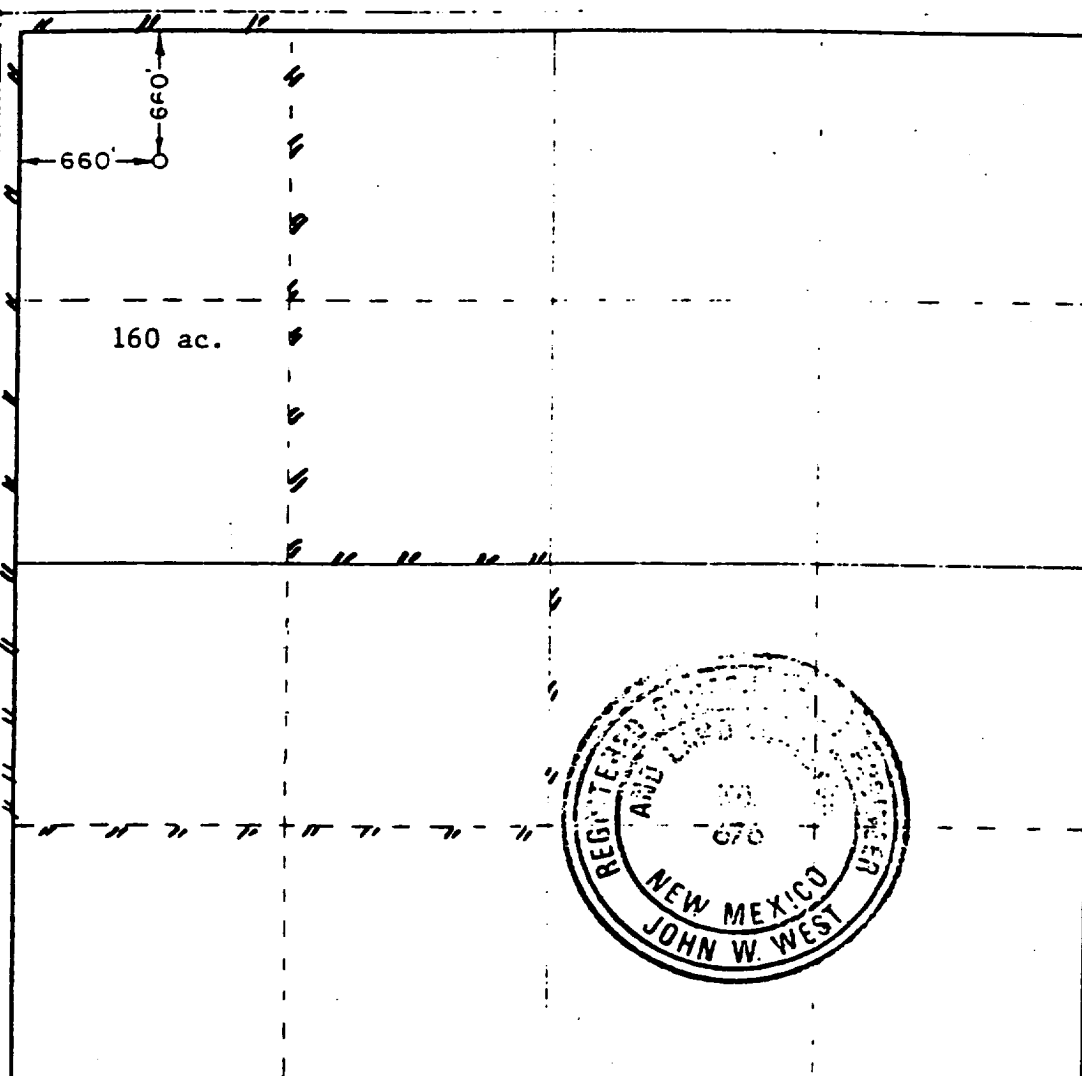

CERTIFICATION

I hereby certify that the information contained herein is true and complete to the best of my knowledge and belief

Larry M. Sanders
Larry M. Sanders

Supervisor, Regulation & Pro-
ratic
Phillips Petroleum Co.

2/14/89

I hereby certify that the well location shown on this plat was plotted from field notes of actual surveys made by me or under my supervision and that the same is true and correct to the best of my knowledge and belief

John W. West
Certificate No. JOHN W. WEST
RECORDED 2 15 89