

**NEW MEXICO
OIL CONSERVATION COMMISSION**

Gas Well Plat

Date August 16, 1954

Skelly Oil Company

Mexico "X" COM

1

Operator

Lease

Well No. 25

Name of Producing Formation


Queen

Pool

Eumont

No. Acres Dedicated to the Well 160

SECTION 29 TOWNSHIP 19S RANGE 37E

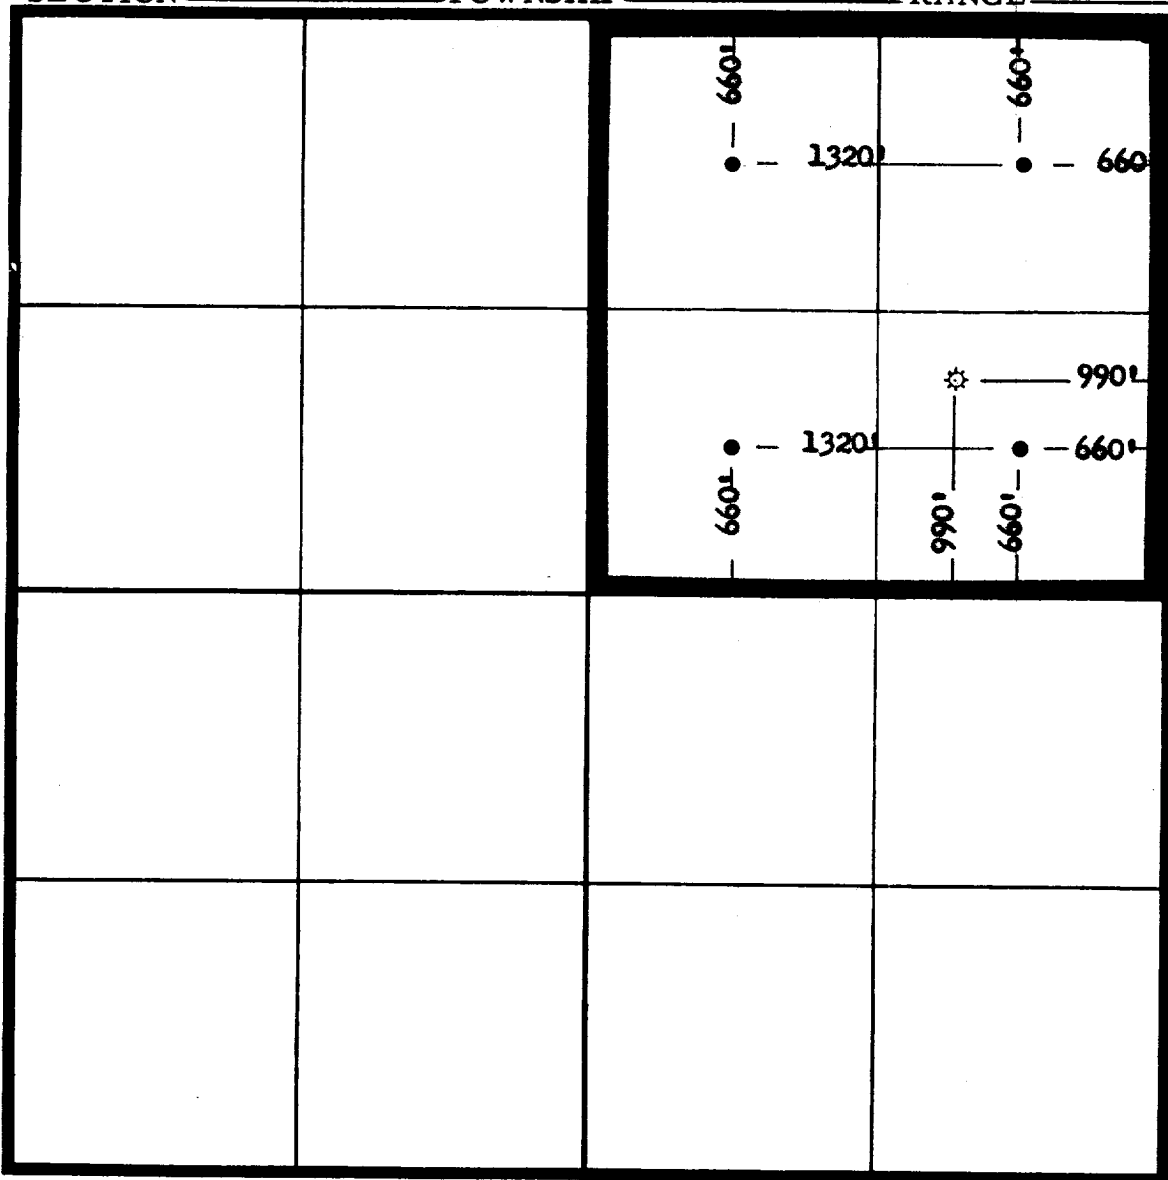

I hereby certify that the information given above is true and complete to the best of my knowledge.

- oil well
- ⊙ gas well

Blue lines - lease line

Red lines - dedicated acres

Name J. J. Dunlap
 Position Dist. Supt.
 Representing Skelly Oil Co.
 Address Box 38, Hobbs, N.M.

(over)

INSTRUCTIONS

1. Is this gas well a dual completion? Yes No X.
2. If the answer to Question 1 is Yes, are there any other dually completed wells within the dedicated acreage? Yes No

A separate plat must be filed for each gas well, outlining the area dedicated to such well and showing the location of all other wells (oil and gas) within the outlined area.

Mail in duplicate to the district office for the district in which the well is located.