

30-025-27399

NO. OF COPIES RECEIVED
DISTRIBUTION
SANTA FE
FILE
U.S.G.S.
LAND OFFICE
OPERATOR

NEW MEXICO OIL &amp; GAS COMMISSION

APPROVAL VALID FOR 180 DAYS  
 PERMIT EXPIRES 10/30/81  
 UNLESS DRILLING UNDERWAY

Lease Type of Lease
DATE <input type="checkbox"/> FEE <input checked="" type="checkbox"/>
Oil & Gas Lease No.
Agreement Name
Operator Name
C. H. Weir "A"
13
Well and Pool, or Wildcat
Monument Tubb
County
Lea
Rotary
May 15, 1981

## APPLICATION FOR PERMIT TO DRILL, DEEPEN, OR REWORK

1a. Type of Work

b. Type of Well DRILL ☐ DEEPEN ☐ REWORK ☒

2. Name of Operator

Texaco Inc.

3. Address of Operator

P. O. Box 3109 - Midland, Texas 79702

4. Location of Well

2307 East 12 20-S 37-E

6650' Monument Tubb

3559' Gr.

SIZE OF HOLE	SIZE OF CASING	WELL DEPTH	EST. TOP
15"	11-3/4"	42#H-40,STC 1450	Circulate
11"	8-5/8"	24#K-55,STC 2000)	
		28#H-40,STC 2550)	
		28#S-80,STC 3450)	
7-7/8"	5-1/2"	14#K-55,STC 5400	
		15.5#K-55,STC 6650	Circulate

Surface Csg. 900 Sxs. Class "C" w/2% CC, 4% Gel (13.7 ppg, 1.67 ft<sup>3</sup>/sx) followed by 200 sxs. Class "C" w/2% CC (14.8 ppg, 1.32 ft<sup>3</sup>/sx). Cement must circulate

Intermediate Csg: 1st Stage: 700 sxs. Class "C" w/4% gel, 2% CC (13.7 ppg, 1.67 ft<sup>3</sup>/sx) followed by 200 sxs. Class "C" Neat (14.8 ppg, 1.32 ft<sup>3</sup>/sx). 2nd Stage: 500 sxs. Class "C" Neat (14.8 ppg, 1.32 ft<sup>3</sup>/sx).

Production Casing: 875 sxs. TLW w/1/4# Flocele/sx (12.14 ppg, 1.69 ft<sup>3</sup>/sx) followed by 400 sxs. Class "C" w/1/4# flocele/sx (14.8 ppg, 1.32 ft<sup>3</sup>/sx).

IN ABOVE SPACE DESCRIBE PROPOSED PROGRAM; IF PROPOSED IS TO BE A REWORK, DESCRIBE REASON FOR REWORK, REACTIVE ZONE AND PROPOSED NEW PRODUCTION ZONE. GIVE BLOWOUT PREVENTER PROGRAM, IF ANY.

I hereby certify that the information above is true and complete to the best of my knowledge.

Signed Leslie A. Clements Title Asst. Petr. Engr. Mgr. Date 4/28/81

(This space for State use)

APPROVED BY Leslie A. Clements TITLE

OIL & GAS INSPECTOR

CONDITIONS OF APPROVAL, IF ANY:

NEW MEXICO OIL CONSERVATION COMMISSION  
WELL LOCATION AND ACREAGE DEDICATION PLAT

Form C-102  
Supersedes C-128  
Effective 1-1-65

All distances must be from the outer boundaries of the Section.


Operator <b>TEXACO Inc.</b>			Lease <b>C. H. Weir "A"</b>		Well No. <b>13</b>
Unit Letter <b>G</b>	Section <b>12</b>	Township <b>20 South</b>	Range <b>37 East</b>	County <b>Lea</b>	
Actual Footage Location of Well: <b>2210</b> feet from the <b>North</b> line and <b>2307</b> feet from the <b>East</b> line <b>Sec. 12</b>					
Ground Level Elev. <b>3559'</b>	Producing Formation <b>Monument Tubb</b>	Pool <b>Monument Tubb</b>	Dedicated Acreage: <b>80</b> Acres		

1. Outline the acreage dedicated to the subject well by colored pencil or hachure marks on the plat below.
2. If more than one lease is dedicated to the well, outline each and identify the ownership thereof (both as to working interest and royalty).
3. If more than one lease of different ownership is dedicated to the well, have the interests of all owners been consolidated by communitization, unitization, force-pooling, etc?

☒ Yes ☐ No If answer is "yes," type of consolidation Operating Agreement

If answer is "no," list the owners and tract descriptions which have actually been consolidated. (Use reverse side of this form if necessary.)

No allowable will be assigned to the well until all interests have been consolidated (by communitization, unitization, forced-pooling, or otherwise) or until a non-standard unit, eliminating such interests, has been approved by the Commission.

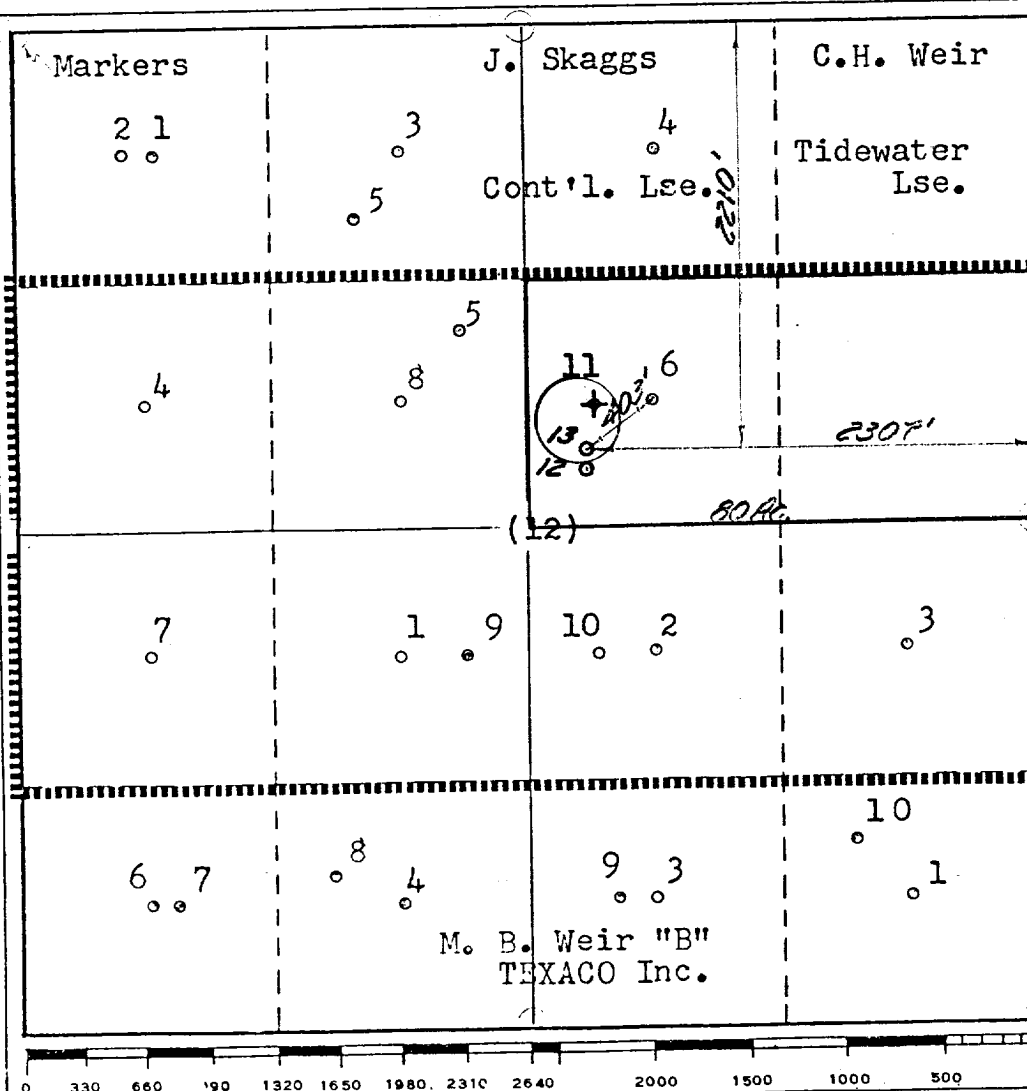

CERTIFICATION

I hereby certify that the information contained herein is true and complete to the best of my knowledge and belief.

*B. L. Eiland*

Name  
**B. L. Eiland**

Position  
**Division Surveyor**

Company  
**Texaco Inc.**

Date  
**4-27-81**

I hereby certify that the well location shown on this plat was plotted from field notes of actual surveys made by me or under my supervision, and that the same is true and correct to the best of my knowledge and belief.



**4-22-81**

Date Surveyed

Registered Professional Engineer and/or Land Surveyor

*B. L. Eiland*  
**B. L. Eiland**

Certificate No.  
**4386**

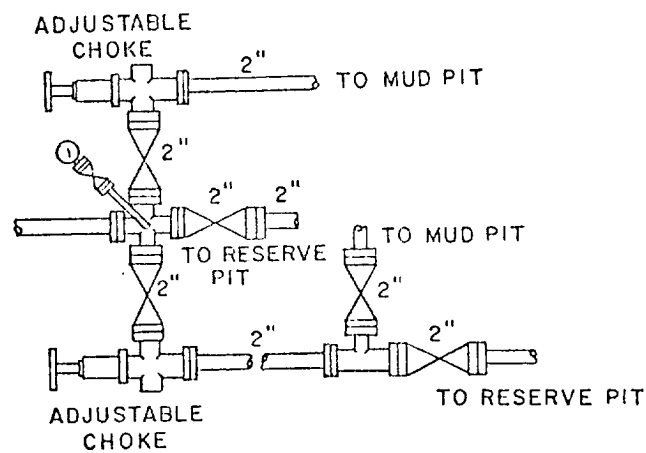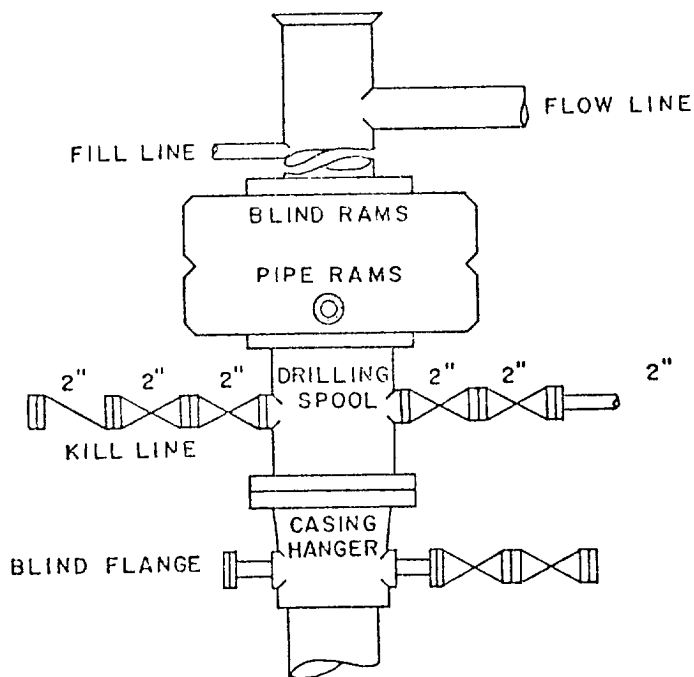

SCALE: NONE	DATE	EST. NO.	DRG. NO.
DRAWN BY JWD			
CHECKED BY RDW			
APPROVED BY			



TEXACO, INC.  
PRODUCING DEPARTMENT-U.S. (EAST)  
MIDLAND, TEXAS



EXHIBIT "B"

RECEIVED

473

APR 29 1981

OIL CONSERVATION DIV.