

LITHOLOGY RECORD

WELL LOG

DRILLING SUMMARY
GULF W 1227-B

Attachment - VMCCD Form C-105

DATE April 22, 1953

SHEET NO. 3

Northeast Drinkard Unit

Harry Leonard "A"

WELL NO. 24-224

FIELD Hare

LEASE

DEPTH	FEET	DESCRIPTION
0	14.30	Distance from Top Kelly Drive Bushing to Ground
50	35.70	Surface Sand and Caliche - Spudded 17-1/2" hole
891	841	Red Bed - Reduced to 12-1/4" hole at 240'
1400	509	Red Bed and Red Rock - Reached 1000' at 7:30PM 2-20-53
1462	62	Gyp and Anhydrite
1532	70	Anhydrite
2777	1245	Salt and Anhydrite - Reached 2000' 3:PM 2-21-53
2962	185	Anhydrite - Reduced to 8-3/4" hole at 2954'
2965	3	Sand
2980	15	Anhydrite
2990	10	Sand
3329	339	Anhydrite - Reached 3000' 12:PM 2-23-53
7682	4353	Lime - Reached 4000' 1:AM 3-1-53, Reached 5000' 3:PM 3-4-53, Reached 6000' 10:30PM 3-8-53, Reached 7000' 3:30AM 3-16-53
7856	174	Lime and Shale
7878	22	Shale
7916	38	Lime and Shale
8034	118	Shale - Reached 8000' 9:15PM 3-29-53
8196	162	Shale and Sand
8246	50	Shale, Lime and Sand
8368	122	Shale and Lime
8411	43	Shale, Lime and Sand
8466	55	Shale and Sand
8485	19	Shale
8539	54	Shale and Sand
8671	132	Shale
8685	14	Sand and Lime
8700	15	Shale
8195	-	Plugged back from 8700'

Submit to Appropriate
District Office
State Lease - 4 copies
Fee Lease - 3 copies

State of New Mexico
Energy, Minerals and Natural Resources Department

Form C-102
Revised 1-1-89

OIL CONSERVATION DIVISION

P.O. Box 2088
Santa Fe, New Mexico 87504-2088

DISTRICT I
P.O. Box 1980, Hobbs, NM 88240

DISTRICT II
P.O. Drawer DD, Artesia, NM 88210

DISTRICT III
1000 Rio Brazos Rd., Aztec, NM 87410

WELL LOCATION AND ACREAGE DEDICATION PLAT
All Distances must be from the outer boundaries of the section

Operator Shell Western E&P Inc.		Lease NORTHEAST DRINKARD UNIT		Well No. 224
Unit Letter J	Section 2	Township 21S	Range 37E	County NMPM LEA
Actual Footage Location of Well: 4302.8 feet from the SOUTH line and 2317 feet from the EAST line				
Ground level Elev. 3496'	Producing Formation BLINEBRY/TUBB/DRINKARD		Pool N. EUNICE BLINEBRY-TUBB-DRINKARD	Dedicated Acreage: 40 Acres

1. Outline the acreage dedicated to the subject well by colored pencil or hatchure marks on the plat below.

2. If more than one lease is dedicated to the well, outline each and identify the ownership thereof (both as to working interest and royalty).

3. If more than one lease of different ownership is dedicated to the well, have the interest of all owners been consolidated by communitization, unitization, force-pooling, etc.?


☒ Yes

☐ No

If answer is "yes" type of consolidation UNITIZATION

If answer is "no" list the owners and tract descriptions which have actually been consolidated. (Use reverse side of this form if necessary.)

No allowable will be assigned to the well until all interests have been consolidated (by communitization, unitization, forced-pooling, or otherwise) or until a non-standard unit, eliminating such interest, has been approved by the Division.

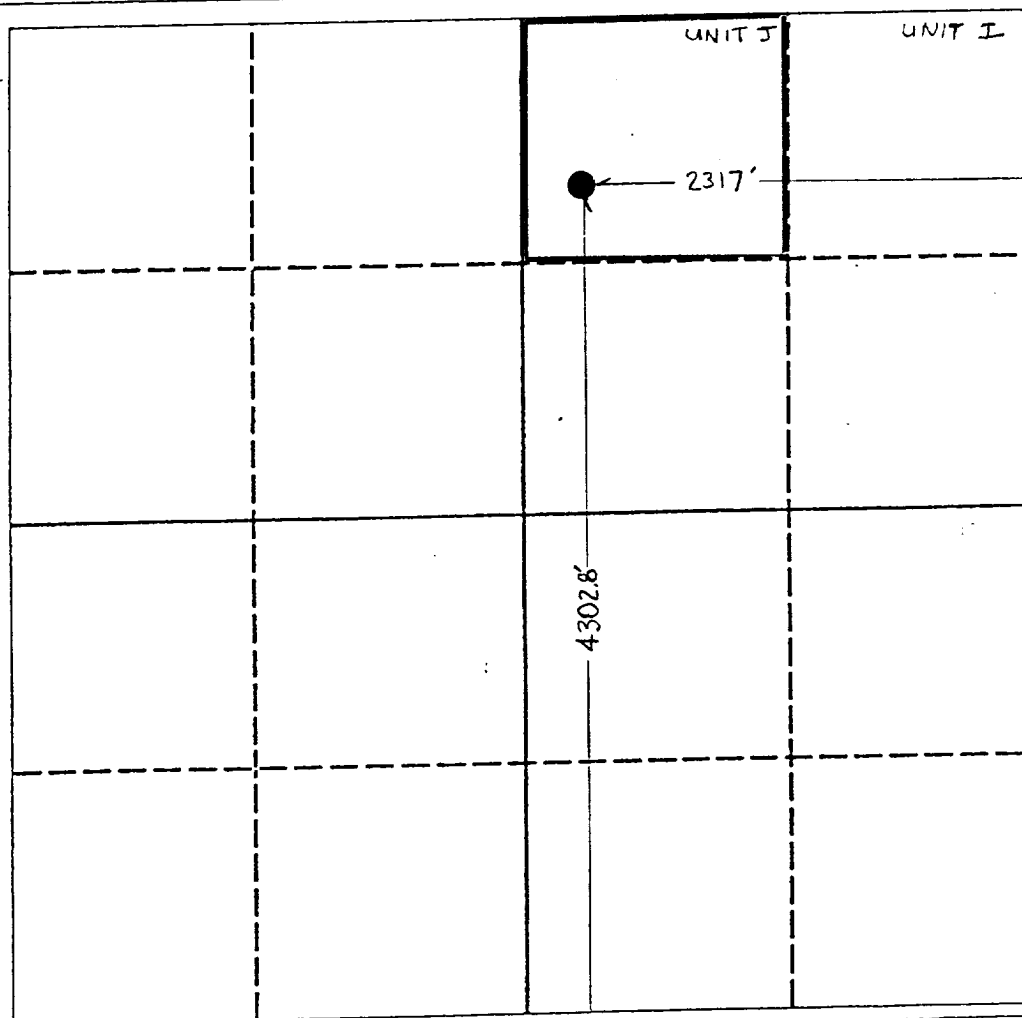

OPERATOR CERTIFICATION

I hereby certify that the information contained herein is true and complete to the best of my knowledge and belief.

Signature

Printed Name

W. F. N. KELLDORF

Position

TECH. MANAGER - ENVIR. ENG.

Company

SHELL WESTERN E&P INC.

Date

6/15/92

SURVEYOR CERTIFICATION

I hereby certify that the well location shown on this plat was plotted from field notes of actual surveys made by me or under my supervision, and that the same is true and correct to the best of my knowledge and belief.

Date Surveyed

Signature & Seal of
Professional Surveyor

Certificate No.