

Santa Fe, New Mexico

NOTICE OF INTENTION TO DRILL

Notice must be given to the Oil Conservation Commission or its proper agent and approval obtained before drilling begins. If changes in the proposed plan are considered advisable, a copy of this notice showing such changes will be returned to the sender. Submit this notice in triplicate. One copy will be returned following approval. See additional instructions in Rules and Regulations of the Commission.

Neville G. Penrose

Fort Worth, Texas

11-5-51

Place

Date

OIL CONSERVATION COMMISSION,
Santa Fe, New Mexico,

Gentlemen:

You are hereby notified that it is our intention to commence the drilling of a well to be known as

Neville G. Penrose

State

well No.

No. 1


in SE4/SW4

Company or Operator

Lease

of Sec. 17, T. 20S, R. 39E, N. M., P. M., Wildcat Field, Lea County.

N

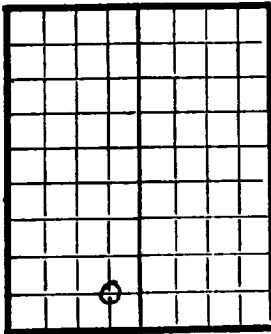

AREA 640 ACRES

LOCATE WELL CORRECTLY

The well is 660 feet (N.) ~~xxx~~ of the South line and 1980 feet (E.) ~~xxx~~ of the West line of 17-20S-39E

(Give location from section or other legal subdivision lines. Cross out wrong directions.)

If state land the oil and gas lease is No. _____ Assignment No. _____

If patented land the owner is _____

Address _____

If government land the permittee is _____

Address _____

The lessee is _____

Address _____

We propose to drill well with drilling equipment as follows: Rotary

The status of a bond for this well in conformance with Rule 89 of the General Rules and Regulations of the Commission is as follows:

We propose to use the following strings of casing and to land or cement them as indicated:

Size of Hole	Size of Casing	Weight Per Foot	New or Second Hand	Depth	Landed or Cemented	Seals Cement
	8-5/8	24#	New	300	Cemented	150
	5-1/2	15.5#	New	4800	Cemented	75

If changes in the above plan become advisable we will notify you before cementing or landing casing. We estimate that the first productive oil or gas sand should occur at a depth of about 4800 feet.

Additional information:

NOV 13 1951

Approved _____

19 _____

except as follows: 5 1/2" casing will be

cemented by 2 stage method. at top of salt section. if oil is found in paying quantities

OIL CONSERVATION COMMISSION,

By _____

Title _____

Oil & Gas Inspector

Sincerely yours,

Neville G. Penrose

Company or Operator

By _____

Position _____

Agent

Send communications regarding well to:

Name _____

Neville G. Penrose


Address _____

1815 Fair Building

N

PLAT OF S½SW¼ & LOT 4
Sec. 17-T205-R39E.

Scale 1"=500'

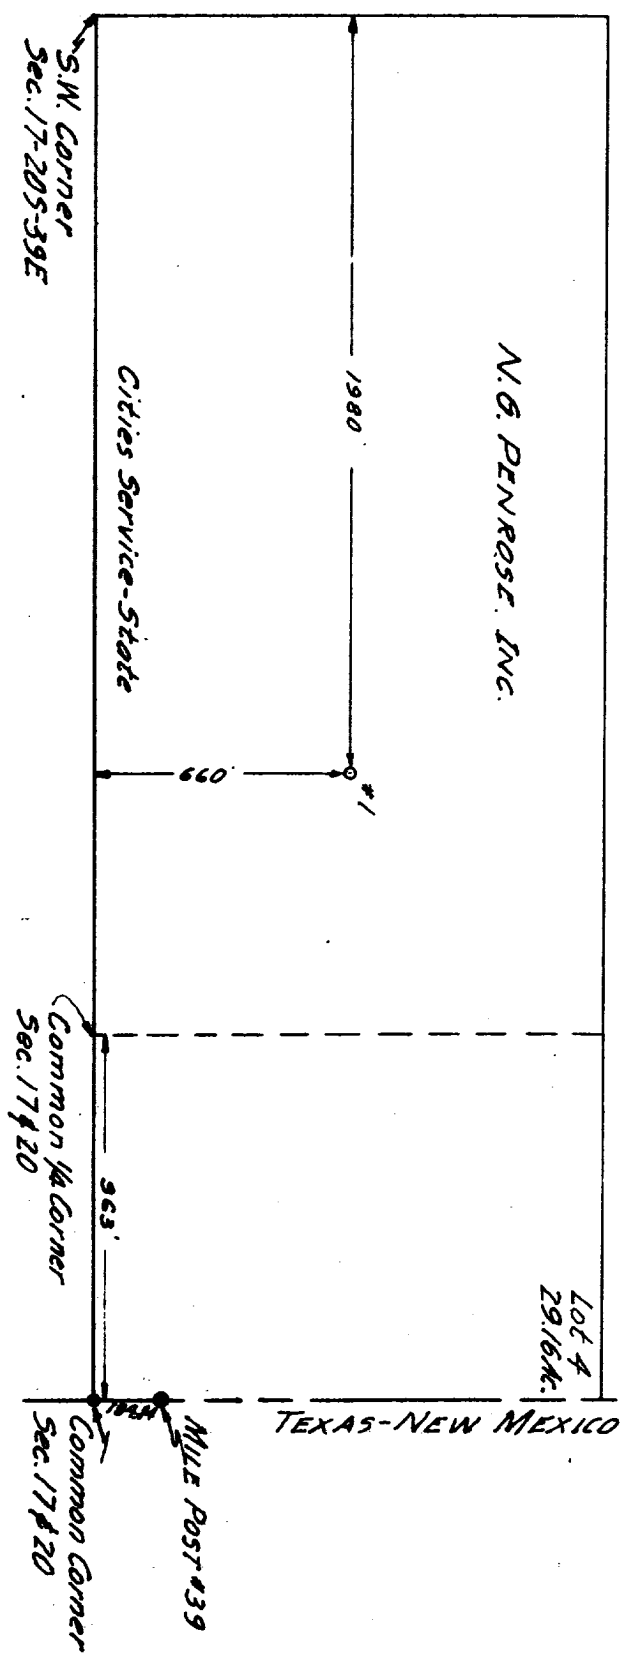

I, Charles I. Miller a licensed surveyor of the state of New Mexico, hereby certify that I have surveyed upon the ground, as platted herewith, a location site for N. G. Penrose, Inc., and that said location site is 660 feet north of the south line and 1980 feet east of the west line of section 17, township 20 south, range 39 east, N.M.P.M.

In witness whereof I hereunto affix my hand and seal this 9th day of November 1951.

Charles I. Miller
Charles I. Miller