

NEW MEXICO LAND CONSERVATION COMMISSION
WELL LOCATION AND ACREAGE DEDICATION PLAT

PLAT NO. 64
SHEET NO. 1


ARCO OIL & GAS CORP.		SEVEN RIVERS QUEEN UNIT		64
E	2	23 SOUTH	36 EAST	LEA
2310	NORTH	660	WEST	
3466.3	SEVEN RIVERS QUEEN	LANGLIE MATTIX	40	

1. Outline the acreage dedicated to the subject well by colored pencil or hachure marks on the plat below.
2. If more than one lease is dedicated to the well, outline each and identify the ownership thereof (both as to working interest and royalty).
3. If more than one lease of different ownership is dedicated to the well, have the interests of all owners been consolidated by communitization, unitization, force-pooling, etc.?

Yes ☐ No ☒ If answer is "yes," type of consolidation _____

If answer is "no," list the owners and tract descriptions which have actually been consolidated (if so) on reverse of this form, if necessary: _____

No allowable will be assigned to the well until all interests have been consolidated (by communitization, unitization, forced-pooling, or otherwise) or until a non-standard unit, eliminating such interests, has been approved by the Conservation Commission.

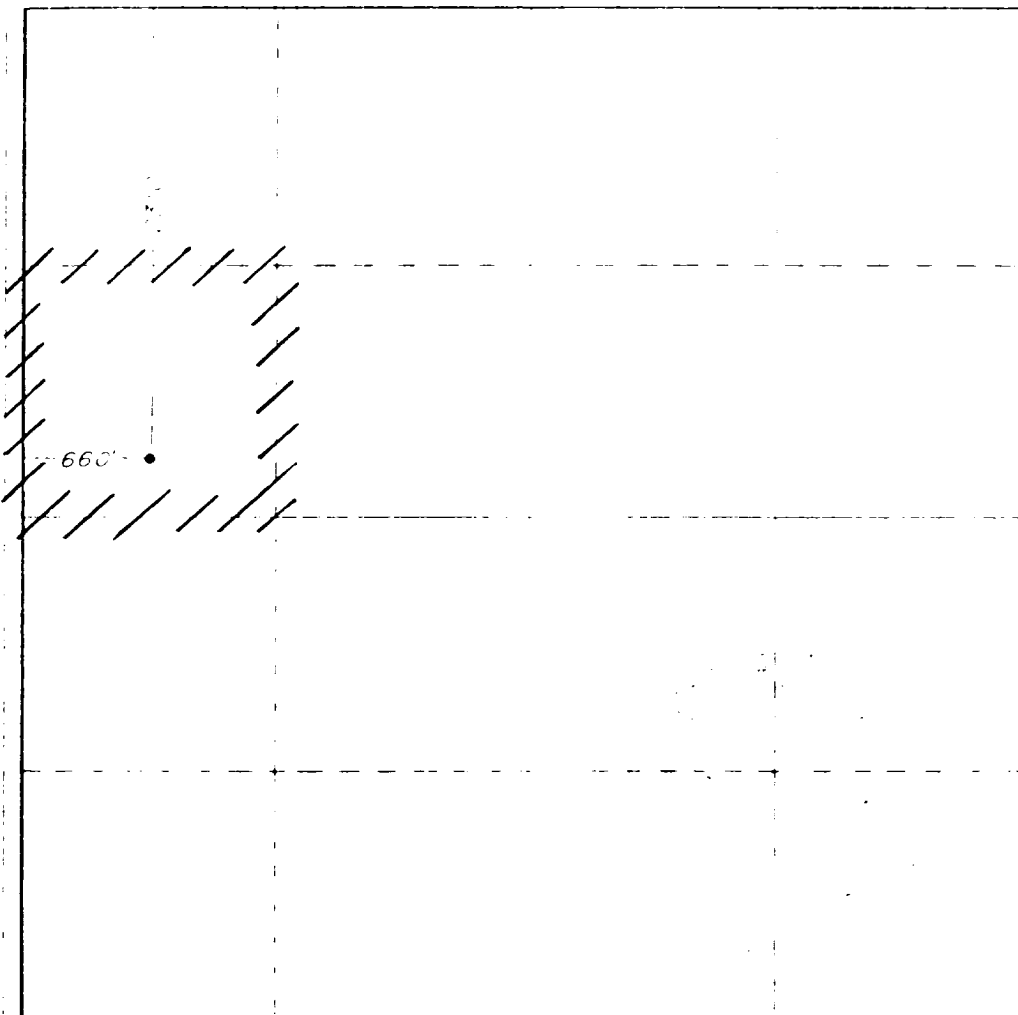

CERTIFICATION

I hereby certify that the information contained herein is true and complete to the best of my knowledge and belief.

Craig L. Paylen
AREA ENGINEER
ARCO OIL AND GAS CO.
12 APRIL, 1984

I hereby certify that the well shown on this plat was located from notes of a land survey made by me under my supervision and that the same is true and correct to the best of my knowledge and belief.

APRIL 6, 1984

Charles W. West
Certified as No. _____
F.N.A.