

NEW MEXICO OIL CONSERVATION COMMISSION
WELL LOCATION AND ACREAGE DEDICATION PLAT

Form C-102
Supersedes C-128
Effective 1-1-65

All distances must be from the outer boundaries of the Section


Operator JACK HUFF		Lease SHEARN STATE		Well No. 1
Unit Letter G	Section 32	Township 26S	Range 37E	County LEA
Actual Footage Location of Well: 544 feet from the SOUTH line and 1980 feet from the EAST line				
Ground Level Elev. (ft.) 2944.6	Producing Formation YATES 7-RIVERS	Pool SCARBOROUGH YATES 7-RIVERS	Dedicated Acreage: 66.1 Acres	

1. Outline the acreage dedicated to the subject well by colored pencil or hatchure marks on the plat below.
2. If more than one lease is dedicated to the well, outline each and identify the ownership thereof (both as to working interest and royalty)
3. If more than one lease of different ownership is dedicated to the well, have the interests of all owners been consolidated by communitization, unitization, force-pooling, etc?

☐ Yes ☐ No If answer is "yes" type of consolidation _____

If answer is "no" list the owners and tract descriptions which have actually been consolidated. (Use reverse side of this form if necessary) _____

No allowable will be assigned to the well until all interests have been consolidated by communitization, unitization, forced-pooling, or otherwise or until a non-standard unit, eliminating such interests, has been approved by the Commission.

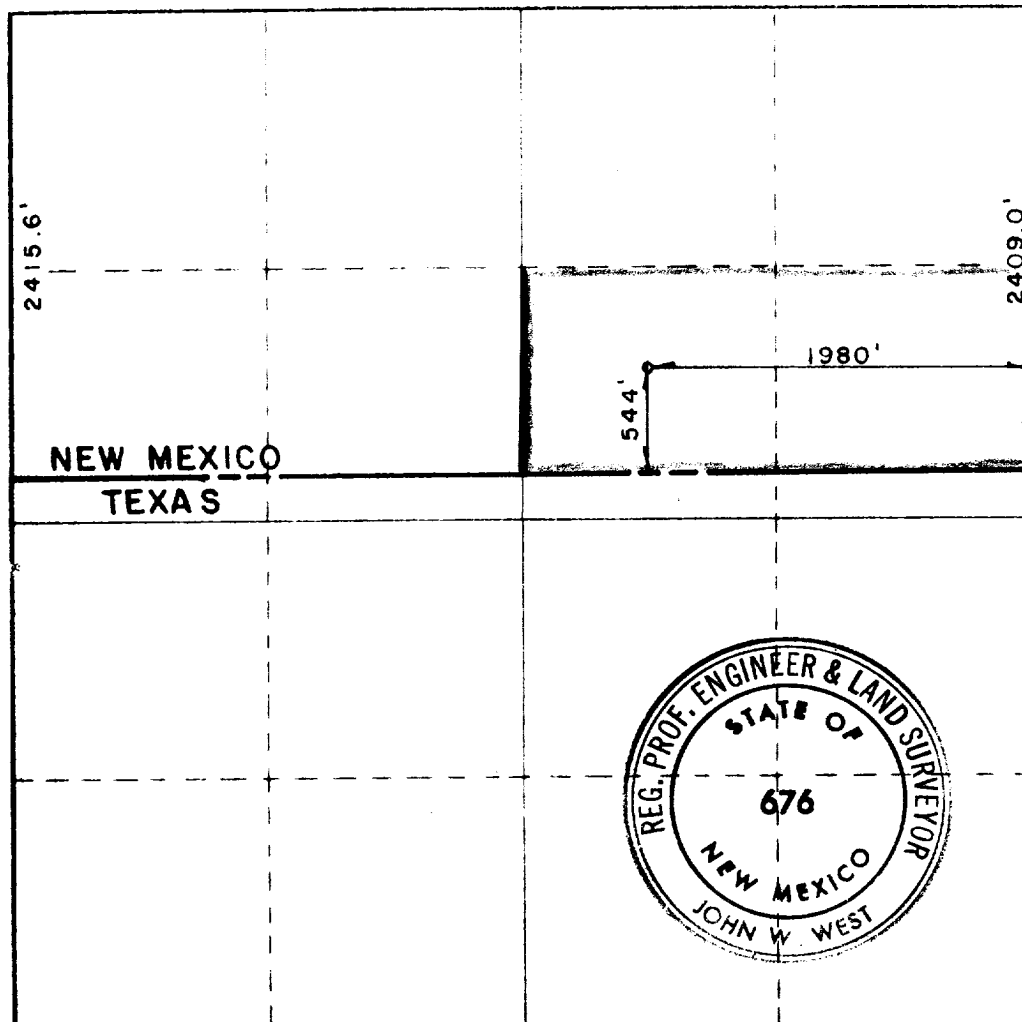

CERTIFICATION

I hereby certify that the information contained herein is true and complete to the best of my knowledge and belief.

Chris Huff

CHRIS HUFF

Position
SUPERINTENDENT

Drawn by
JACK HUFF

Date
OCTOBER 22, 1982

I hereby certify that the well location shown on this plat was plotted from field notes of actual surveys made by me or under my supervision, and that the same is true and correct to the best of my knowledge and belief.

Date Surveyed
10/20/82

Registered Professional Engineer and/or Land Surveyor

John W. West

Certificate No.

0 320 640 960 1280 1600 1920 2240 2560 2640 2000 1500 1000 500 0

RECEIVED
OCT 29 1982
RECEIVED
OCT 25 1982
FBI
FBI
FBI