

REVENUE DEPARTMENT WELL LOCATION AND ACREAGE DECLARATION

REVISED

Form 0-10,
Superseding 0-12a
Effective 1-1-72

All acreage must be from the owner's own survey of the land.


Owner Battis, Boyle & Stovall		Lease No. 7	
Section 20	Township 25S	Range 17E	County Lea
Section 10601	North	Section 1080	West
Section 1075.6	Yates	Section Palmetto	Section 40

- Outline the acreage dedicated to the subject well by colored pencil or ink on the plat below.
- If more than one lease is dedicated to the well, outline each and designate the ownership thereof (both as to working interest and royalty).
- If more than one lease of different ownership is dedicated to the well, have the interests of all owners been consolidated by communitization, unitization, forced-pooling, or otherwise?

☐ Yes ☐ No Answer is "yes" type of consolidation _____

If answer is "no," list the owners and tract descriptions which have actually been consolidated (also on reverse side of this form if necessary): _____

No allowable will be assigned to the well until all interests have been consolidated (by communitization, unitization, forced-pooling, or otherwise) or until a non-standard unit, eliminating such interests, has been approved by the Commission.

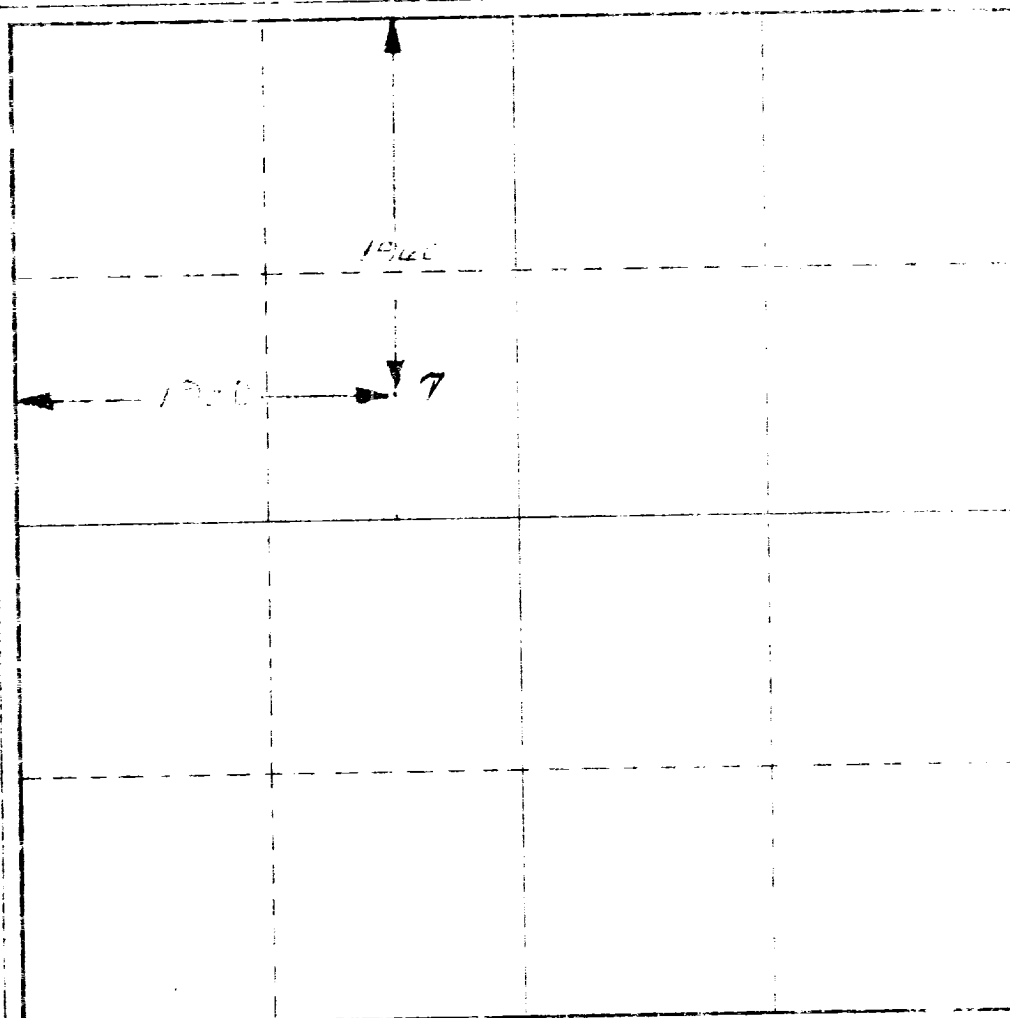

CERTIFICATION

I hereby certify that the information contained herein is true and complete to the best of my knowledge and belief.

Spencer B. Street, Jr.
Name
Spencer B. Street, Jr.

Agent

Battis, Boyle & Stovall

August 21, 1972

I hereby certify that the well location shown on this plat was plotted from field notes of actual surveys made by me or under my supervision, and that the same is true and correct to the best of my knowledge and belief.

Date drawn:

Registered Professional Engineer
State of Texas License No. _____

Certification No. _____

0 500 1000 1500 2000 2500 3000 3500 4000

RECEIVED

AUG 24 1972

OIL CONSERVATION COMM.
HOBBS, N. M.