DISTRICT P.O. Box 1980, Hobbs, NM 88241-1980 DISTRICT II

State of New Mexico Energy, Minerals and Natural Resources Department

Form C-101 Revised February 10,1994 Instructions on back

P.O. Box Drawer DD, Artesia, NM 88211-0719 DISTRICT III

**OIL CONSERVATION DIVISION** P.O. Box 2088

Submit to Appropriate District Office State Lease - 6 Copies

1000 Rio Brazos Rd., Aztec, NM 87410

Santa Fa. New Mexico 87504-2088

DISTRICT IV P.O. Box 2088	•						R, DEEPEN, P			MEND	ED REPORT
TEXACO EX		1	Operator Name :					<u> </u>		<sup>2</sup> OGRI	D Number 2351
P.O. Box 31	09, Midland	i Texas 79	9702						3	API Nu	mber
4 F	Property Code 11097	)				roperty N				6 W	ell No.
	11057	_ <del></del>			-	e Loca					
UI or lot no. D	Section 2	Townsl 25-S		Lot los	Feet From		North/South Line NORTH	Feet From The 330	East/Wes WES		County LEA
			<sup>8</sup> Propos	ed Bottor	n Hole Loc	cation I	f Different Fro	m Surface			
Ul or lot no.	Section	Towns	( )	Lot.idn	Feet From		North/South Line	Feet From The	East/Wes	t Line	County
	1		posed Pool 1 TIS BLINEBRY		i ,			10 Proposed Po			. ,
	k Type Code		<sup>12</sup> WellType C	ode	13 Rotary o		14 Lea	sse Type Code S	<sup>15</sup> Gro	und Leve 31'79	l Elevation
18 Multiple 1 No			<sup>17</sup> Proposed De 7150'	Proposed Depth 7150' E		18 Formation BUINEBRY/TUBB/DRINK		19 Contractor NABORS		<sup>20</sup> Spud Date 12/15/95	
				Propos	ed Casing	and C	ement Prograi	m			
	FHOLE		E OF CASING	WEIGHT	PER FOOT	1000	SETTING DEPTH		FCEMENT	01.1515	EST. TOP
7 7/8		8 5/8 5 1/2		15.5 & 17#	:	7150		525 SACKS 2000 SACKS		SURF	<del></del>
		-				-			<del></del>		
CEMENTIN	G PROGRA	AM:					-· -	t Halasa Dr	Bling Ur	ldet K	εy.
PPG, 1.34 C PRODUCTI 50/50 POZ (	CF/S, 5.3 G ON CASIN CLASS H V	W/S). G - 1500 : V/ 2% GE	SACKS 35/65 PO L 5% SALT, 1/4#	Z CLASS H FLOCELE (	W/ 6% GEL, 14.2 PPG, 1.	5% SAL 35 CF/S,	.74 CF/S, 9.11 GW .T, 1/4# FLOCELE 6.3 GW/S). HAS BEEN FURNI	(12.4 PPG, 2.14 (	CF/S, 11.9 G	W/S). F	/B 500 SACKS
Division has	ve been compli	ed with and	ations of the Oil Conse that the information giv knowledge and belief.				OIL	CONSERVA	TION D	IVISI	ON
Signature		Wale	Growal .			Apı	proved By:				
Printed Nam	ne C.	Wade Ho	oward			Tit	le:				
Title Er	ng. Assistan	ıt				Ap	proval Date: N	DV 03 1995	Expiration D	ate:	
Date 1	 11/1/95		Telepho	nne s	88_4606	Co	nditions of Approve	al:	•		-

DISTRICT 1 P. O. Box 1980, Hobbs, NM 88240

D-STRICT II P. O. Drawer DD, Artesia, NM 88210

DISTRICT III

1000 Rio Brazos Rd., Az:ec. NM 87410 DISTRICT IV

P. O. Box 2088, Santa Fe, NM 87504-2088

State of New Mexico Energy, Minerals and Natural Resources Department

OIL CONSERVATION DIVISION

PO Box 2088 Santa Fe, NM 87504-2088

Form C-102 Revised February 10, 1994

Instructions on back

Submit to Appropriate District Office

State Lease-4 copies Fee Lease-3 copies


AMENDED REPORT

### WELL LOCATION AND ACREAGE DEDICATION PLAT

API Nun	Pool Code  Justis Blinebry; Justis	3 Pool Name Tubb / Drinkard
Property Code	State "BB"	<sup>6</sup> Well Number
OGRID No.	*Operator Name  TEXACO EXPLORATION & PRODUCTION, IN	C. 3179'


					10 Surface L	ocation		<del></del>	
UL or lot no.	Section 2	Township 25-S	Range 37—E	Lot lan	Feet from the 990°	North/South line North	Feet from the 330'	East/West line West	<sup>7</sup> County <b>Lea</b>
			, 11 B	ottom Hol	e Location If	Different From	Surface		· <del> </del>
UL or lot no.	Section	Township	Range	Lot Idn	Feet from the	North/South line	Feet from the	East/West line	<sup>7</sup> County
*Vedicated Acres	13 Jo	int or Infill	<sup>1</sup> Consolid	ation Code	<sup>15</sup> Order No.	l	<u></u>		

NO ALLOWABLE WILL BE ASSIGNED TO THIS COMPLETION UNTIL ALL INTERESTS HAVE BEEN CONSOLIDATED

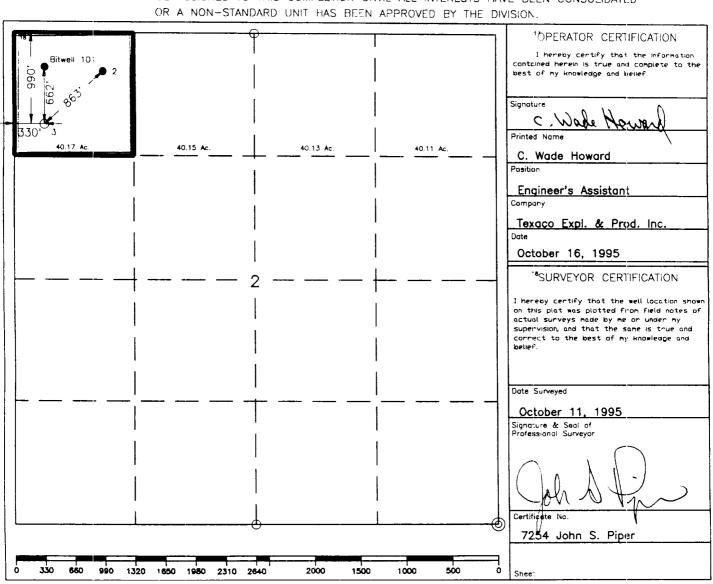

# DRILLING CONTROL CONDITION II-B 3000 WP

## FOR AIR DRILLING OR WHERE NITROGEN OR AIR BLOWS ARE EXPECTED

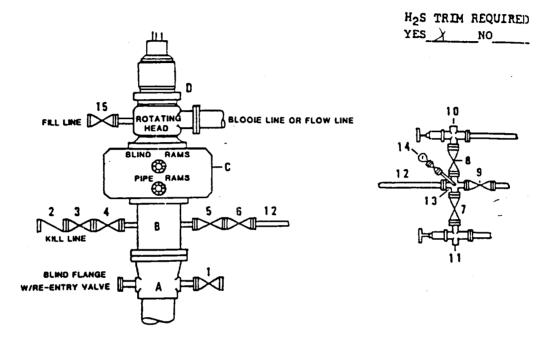

#### DRILLING CONTROL

### MATERIAL LIST - CONDITION II - B

λ	Texaco Wellhead
В .	3000f W.P. drilling spool with a 2" minimum flanged outlet for kill line and 3" minimum flanged outlet for choke line.
c	3000# M.P. Dual ram type preventer, hydraulic operated with 1" steel, 3000# W.P. control lines (where substructure height is adequate, 2 - 3000# W.P. single ram type preventers may be utilized).
D	Rotating Head with fill up outlet and extended Blooie Line.
1,3,4,	2" minimum 3000# W.P. flanged full opening steel gate valve, or Halliburton Lo Torc Plug valve.
2	2" minimum 3000# W.P. back pressure valve.
5,6,9	3" minimum 3000% W.P. flanged full opening steel gate valve, or Halliburton Lo Torc Plug valve.
12	3" minimum schedule 80, Grade "B", seamless line pipe.
13	2" minimum x 3" minimum 3000# W.P. flanged cross.
10,11	2" minimum 3000# W.P. adjustable choke bodies.
14	Cameron Mud Gauge or equivalent ( location optional in choke line).
15	2" minimum 3000# W.P. flanged or threaded full opening steel gate valve, or Halliburton Lo Torc Plug valve.



TEXACO, INC.



DRAWN BY	
CHECKED BY	