

Submit to Appropriate
District Office
State Lease - 4 copies
Fee Lease - 3 copies

State of New Mexico
Energy, Minerals and Natural Resources Department

Form C-102
Revised 1-1-89

OIL CONSERVATION DIVISION

P.O. Box 2088
Santa Fe, New Mexico 87504-2088

DISTRICT I
P.O. Box 1980, Hobbs, NM 88240

DISTRICT II
P.O. Drawer DD, Artesia, NM 88210


DISTRICT III
1000 Rio Brazos Rd., Aztec, NM 87410

WELL LOCATION AND ACREAGE DEDICATION PLAT

All Distances must be from the outer boundaries of the section

Operator V. H. Westbrook			Lease Cities Service Federal		Well No. 2
Unit Letter I	Section 35	Township 24 South	Range 36 East	County Lea	
Actual Footage Location of Well: 1980 feet from the South line and 660 feet from the East line					
Ground level Elev. 3264'	Producing Formation Yates-Seven Rivers		Pool Yates-Tansil-Seven Rivers-Jalmat	Dedicated Acreage: 80 Acres	

- Outline the acreage dedicated to the subject well by colored pencil or hachure marks on the plat below.
- If more than one lease is dedicated to the well, outline each and identify the ownership thereof (both as to working interest and royalty).
- If more than one lease of different ownership is dedicated to the well, have the interest of all owners been consolidated by communitization, unitization, force-pooling, etc.?
☐ Yes ☐ No If answer is "yes" type of consolidation _____
If answer is "no" list the owners and tract descriptions which have actually been consolidated. (Use reverse side of this form if necessary).
No allowable will be assigned to the well until all interests have been consolidated (by communitization, unitization, forced-pooling, or otherwise) or until a non-standard unit, eliminating such interest, has been approved by the Division.

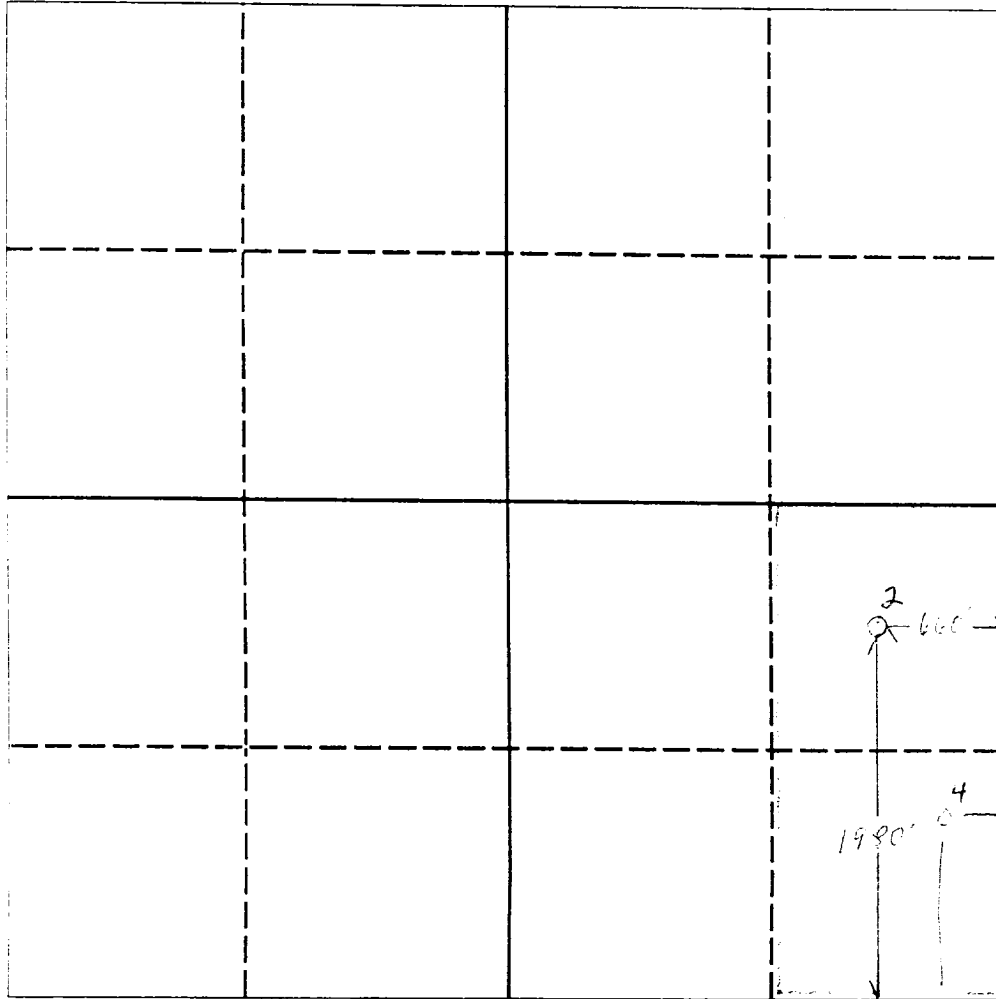

OPERATOR CERTIFICATION

I hereby certify that the information contained herein is true and complete to the best of my knowledge and belief.

Signature
V. H. Westbrook

Printed Name
Operator

Position
V. H. Westbrook

Company
2/25/92

Date

SURVEYOR CERTIFICATION

I hereby certify that the well location shown on this plat was plotted from field notes of actual surveys made by me or under my supervision, and that the same is true and correct to the best of my knowledge and belief.

Date Surveyed

Signature & Seal of
Professional Surveyor

Certificate No.

0 330 660 990 1320 1650 1980 2310 2640 2000 1500 1000 500 0

N.D. 11/11/92

UNITED STATES
DEPARTMENT OF THE INTERIOR
GEOLOGICAL SURVEY

SUNDRY NOTICES AND REPORTS ON WELLS

(Do not use this form for proposals to drill or to deepen or plug back to a different reservoir. Use Form 9-331-C for such proposals.)

1. oil ☐ gas ☒ other ☐
well well

2. NAME OF OPERATOR

ConVest Energy Corporation

3. ADDRESS OF OPERATOR 2401 Fountain View Dr.,
Ste. 700, Houston, Texas 770574. LOCATION OF WELL (REPORT LOCATION CLEARLY. See space 17
below.)

AT SURFACE: 1980' FSL & 660' FEL of Sec. 35,

AT TOP PROD. INTERVAL: T24S, R36E

AT TOTAL DEPTH:

16. CHECK APPROPRIATE BOX TO INDICATE NATURE OF NOTICE,
REPORT, OR OTHER DATAREQUEST FOR APPROVAL TO: ☒ X

SUBSEQUENT REPORT OF:

TEST WATER SHUT-OFF ☐FRACTURE TREAT ☐SHOOT OR ACIDIZE ☐REPAIR WELL ☐PULL OR ALTER CASING ☐MULTIPLE COMPLETE ☐CHANGE ZONES ☐ABANDON* ☐

(other) Extension of T2 status

17. DESCRIBE PROPOSED OR COMPLETED OPERATIONS (Clearly state all pertinent details, and give pertinent dates, including estimated date of starting any proposed work. If well is directionally drilled, give subsurface locations and measured and true vertical depths for all markers and zones pertinent to this work.)*

Requesting extension of temporarily abandoned status. The well was recently acquired and a field-wide study is being made to evaluate the well for work-over proposals.

Subsurface Safety Valve: Make and Type

Set @ _____ Ft.

18. I hereby certify that the foregoing is true and correct

SIGNED

Dan C. Vance

TITLE Area Engineer

DATE

8/13/82

(This space for Federal or State office use)

APPROVED BY

TITLE

DATE

CONDITIONS OF APPROVAL, IF ANY:



STATE OF NEW MEXICO
ENERGY AND MINERALS DEPARTMENT
OIL CONSERVATION DIVISION

July 12, 1982

BRUCE KING
GOVERNOR

LARRY KEHOE
SECRETARY

P.O. BOX 1880
HOBBS, NEW MEXICO 88240
(505) 393-5161

CONVEST ENERGY CORPORATION
c/o OIL REPORTS & GAS SERVICES
BOX 763
HOBBS, N.M. 88240

Gentlemen:

The Oil Conservation Division has for some time been concerned about temporarily abandoned wells in the State and recently it was decided to pick at random a Township in District I to evaluate this problem. The Township selected for evaluating temporarily abandoned wells was Township 24 South in Lea County, New Mexico.

Included in the study area are the following well/wells that you operate:

Well Name	No.	Unit	S - T - R	Pool
Cities Service Federal	2	I	35-24-36	Jalmat-Y-SR
I.B. Ogg "A"	4	D	35-24-36	Jalmat
I.B. Ogg "A"	1	G	35-24-36	Jalmat
I.B. Ogg "A"	2	H	34-24-36	Jalmat
I.B. Ogg "A"	2	B	35-24-36	Jalmat

Please advise as to your plans for each of the above wells, along with the time frame in which these plans are to be executed. This notification should be made on Form C-103 for state and fee wells; for federal wells, Form 9-331 should be submitted to the Minerals Management Service with a copy to this office.

The Division has set a few general guidelines as to what proposed plans will be acceptable. They are as follows:

1. Return well to production
2. Workover of well
3. Plug and abandonment of well
4. Request to Division Director for extension of temporarily abandoned status

This information should be submitted to the District I office of the OCD by September, 15, 1982.

Yours very truly,

OIL CONSERVATION DIVISION

Jerry Sexton
Supervisor, District I

JS/mc