DISTRICT I
1625 N. FRENCH DR., HOBBS, NM 88240
Phone: (575) 393-6161 Fax: (575) 393-0720
DISTRICT II
811 S. FIRST ST., ARTESIA, NM 88210
Phone: (575) 748-1283 Fax: (575) 748-9720
DISTRICT III
1000 RIO BRAZOS RD., AZTEC, NM 87410
Phone: (505) 334-6178 Fax: (505) 334-6170
DISTRICT IV
1220 S. ST. FRANCIS DR., SANTA FE, NM 87505
Phone: (505) 476-3460 Fax: (505) 476-3462

State of New Mexico
Energy, Minerals & Natural Resources Department
OIL CONSERVATION DIVISION
1220 SOUTH ST. FRANCIS DR.
Santa Fe, New Mexico 87505

NM OIL CONSERVATION
ARTESIA DISTRICT
MAY 03 2018
RECEIVED

Form C-102
Revised August 1, 2011
Submit one copy to appropriate District Office

☑ AMENDED REPORT
(As-Drilled)

WELL LOCATION AND ACREAGE DEDICATION PLAT

API Number	Pool Code	Pool Name
30-015-44191	96238	Corral Draw Bone Spring

Property Code	Property Name	Well Number
315207	CEDAR CANYON 21 FEDERAL COM	23H

OGRID No.	Operator Name	Elevation
16696	OXY USA INC.	2931.0

Surface Location

UL or lot No.	Section	Township	Range	Lot Idn	Feet from the	North/South line	Feet from the	East/West line	County
E	21	24-S	29-E		1824	NORTH	141	WEST	EDDY

Bottom Hole Location If Different From Surface

UL or lot No.	Section	Township	Range	Lot Idn	Feet from the	North/South line	Feet from the	East/West line	County
H	21	24-S	29-E		~~2200~~ 2177	NORTH	~~180~~ 175	EAST	EDDY

Dedicated Acres	Joint or Infill	Consolidation Code	~~Order No.~~
160	Y		BP - 2177 FNL 336 FEL TP - 2273 FNL 368 FWL

NO ALLOWABLE WILL BE ASSIGNED TO THIS COMPLETION UNTIL ALL INTERESTS HAVE BEEN CONSOLIDATED OR A NON-STANDARD UNIT HAS BEEN APPROVED BY THE DIVISION

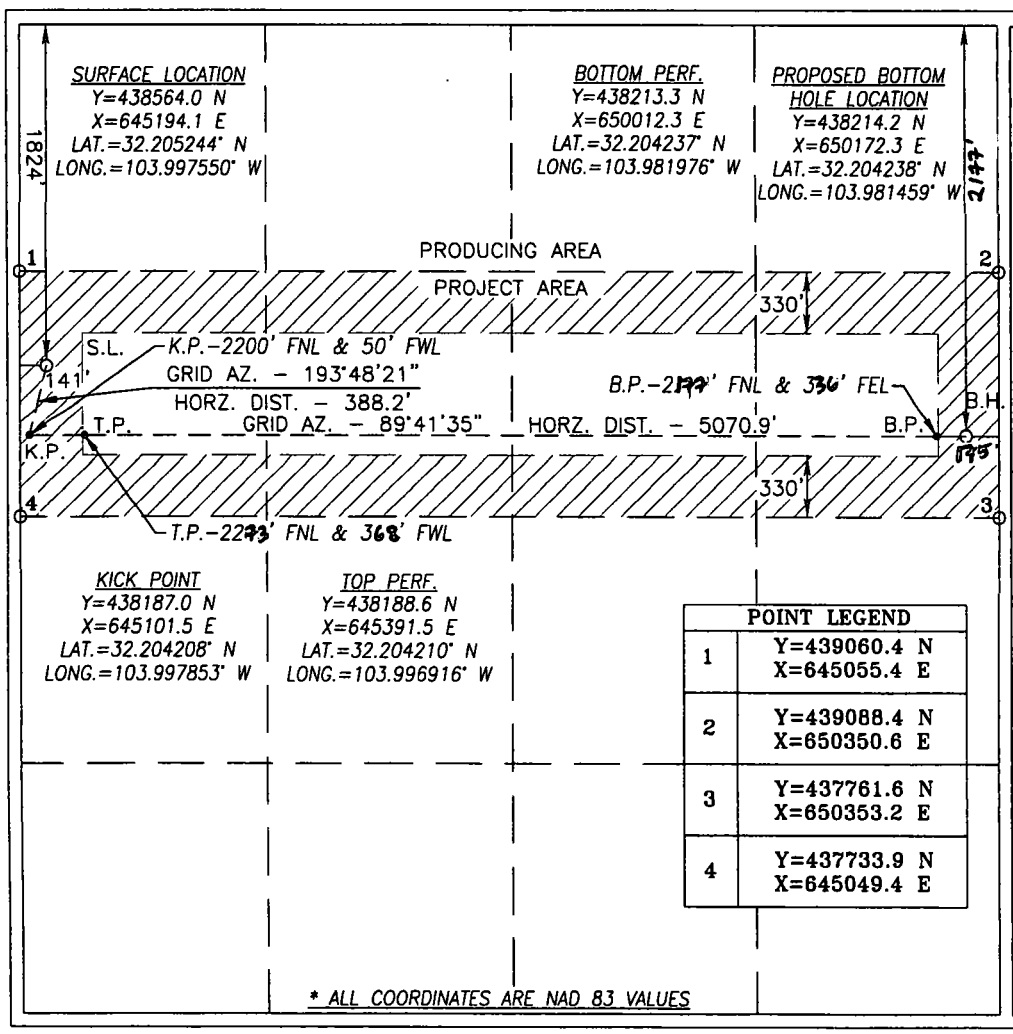

POINT LEGEND	
1	Y=439060.4 N X=645055.4 E
2	Y=439088.4 N X=650350.6 E
3	Y=437761.6 N X=650353.2 E
4	Y=437733.9 N X=645049.4 E

OPERATOR CERTIFICATION

I hereby certify that the information herein is true and complete to the best of my knowledge and belief, and that this organization either owns a working interest or unleased mineral interest in the land including the proposed bottom hole location or has a right to drill this well at this location pursuant to a contract with an owner of such mineral or working interest, or to a voluntary pooling agreement or a compulsory pooling order heretofore entered by the division.

Signature 11/14/17 Date

Jana Mendiola
Printed Name

janalyn_mendiola@oxy.com
E-mail Address

SURVEYOR CERTIFICATION

I hereby certify that the well location shown on this plat was plotted from field notes of actual surveys made by me or under my supervision, and that the same is true and correct to the best of my belief.

JULY 27 2016
Date of Survey

Signature & Seal of Professional Surveyor

CHAD L. HARCROW
NEW MEXICO
17777
LICENSED PROFESSIONAL SURVEYOR

Chad Harcrow 9/19/16
Certificate No. CHAD HARCROW 17777

W.O. #16-726 DRAWN BY: CF