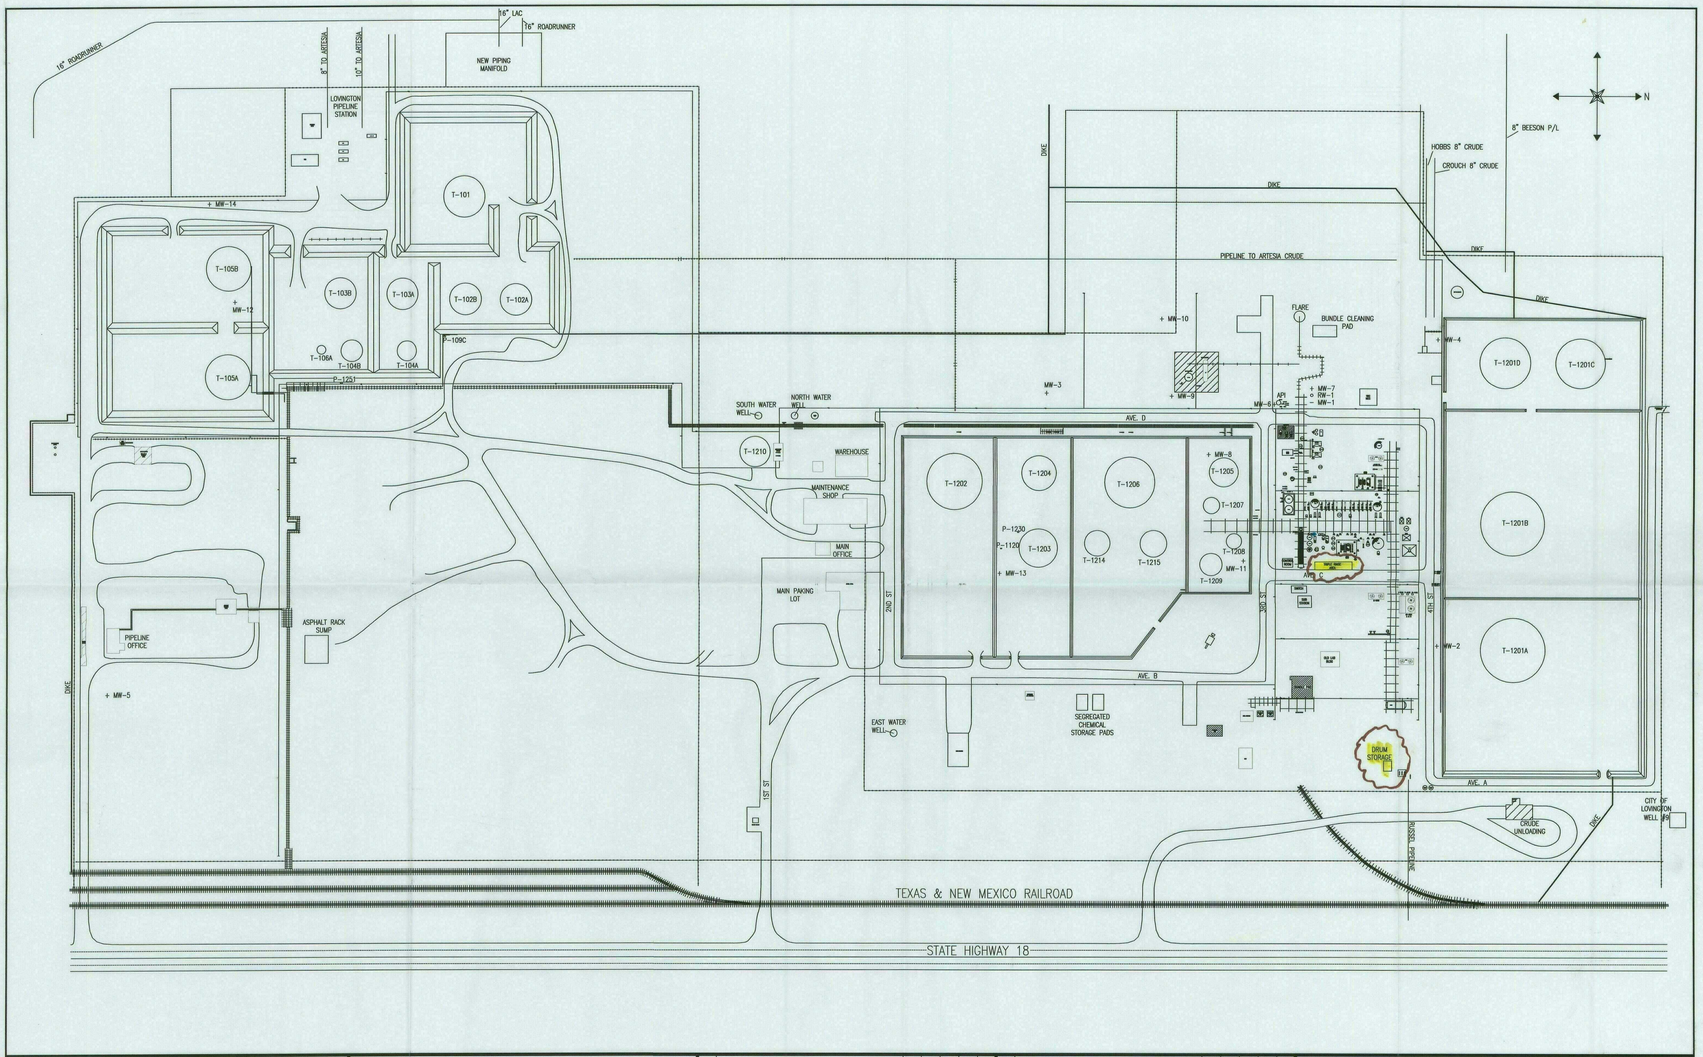

NOTES

REFERENCE DRAWINGS

NO.	REVISIONS	BY	CHK.	DATE	APPR.	APPR.

NO.	REVISIONS	BY	CHK.	DATE	APPR.	APPR.
D	REVISED PER DGM	JNB		1/04/08		
C	REVISED PER DGM	JNB		11/06/06		
B	REVISED PER DGM	JNB		10/06/06		
A	"AS BUILT" PER PLANT WALKDOWN	GEB		9/25/07		

DRAWING TITLE

PLOT PLAN
LEA REFINING
LOVINGTON, NM

NAVAJO REFINING CO.
ENGINEERING DEPARTMENT
P.O. DRAWER 159
ARTESIA, NEW MEXICO

DRAWN BY	CHK'D BY	SCALE	
GEB		NONE	
DATE	APPR. BY	DRAWING NUMBER	REV.
9/25/07		81-Z-03-D-01	D

GW - 014

MODIFICATION REQUESTS (Maps)

2009 - Present