District I 1625 N. French Dr., Hobbs, NM 88240 Phone: (575) 393-6161 Fax: (575) 393-0720 District II 811 S. First St. Artesia NM 88210 Phone: (575) 748-1283 Fax: (575) 748-9720 District III 1000 Rio Brazos Road, Aztec, NM 87410 Phone: (505) 334-6178 Fax: (505) 334-6170 District IV 1220 S. St. Francis Dr., Santa Fe, NM 87505 Phone: (505) 476-3460 Fax: (505) 476-3462

UL or lot no. Section Township

### State of New Mexico

Form C-102 Energy, Minerals & Natural Resources Department PBBS Occubation one copy to appropriate Revised August 1, 2011 OIL CONSERVATION DIVISION District Office

Feet from the

1220 South St. Francis Dr. Santa Fe, NM 87505

AUG 0 5 2014  $\square$  AMENDED REPORT

County

### RECEIVED

East/West line

#### WELL LOCATION AND ACREAGE DEDICATION PLAT

30-025- 42016	57380 <sup>2 Pool Code</sup> Skaggs; Grayburg	<sup>3</sup> Pool Name
<sup>4</sup> Property Code 31670	<sup>5</sup> Property Name SEMU	<sup>6</sup> Well Number 246
OGRID No. 217817	<sup>®</sup> Operator Name ConocoPhillips Company	<sup>9</sup> Elevation 3538'
	<sup>10</sup> Surface Location	


Lot Idn Feet from the North/South line


Range


	19	20 S	38 E		1330	SOUTH	1464	EAST	LEA	ı
			т	5.44 TT	.1. T . / T	CD:CC + D	C C			
			<u>"1</u>	3ottom He	ole Location II	Different From	Surface			
IIL or lot no.	Section	Township	Range	Lot Idn	Feet from the	North/South line	Feet from the	Fast/West line	County	


12 Dedicated Acres 13 Joint or Infill 14 Consolidation Code 15 Order No.

No allowable will be assigned to this completion until all interests have been consolidated or a non-standard unit has been approved by the division.

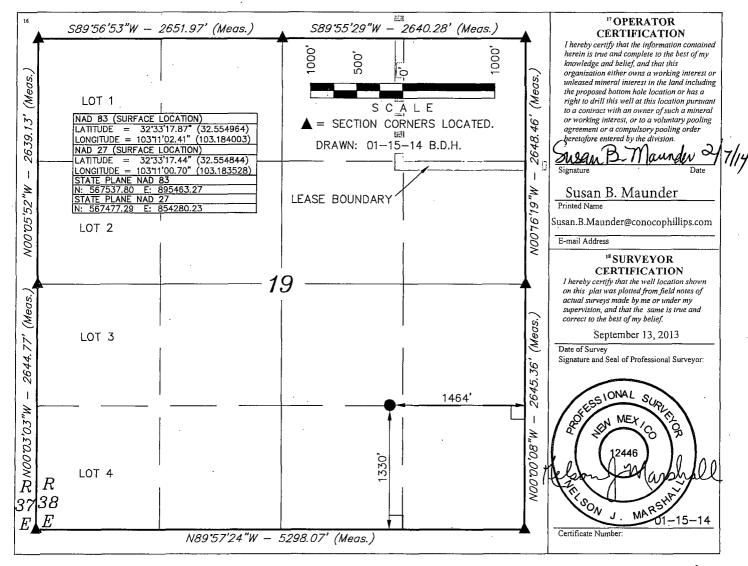

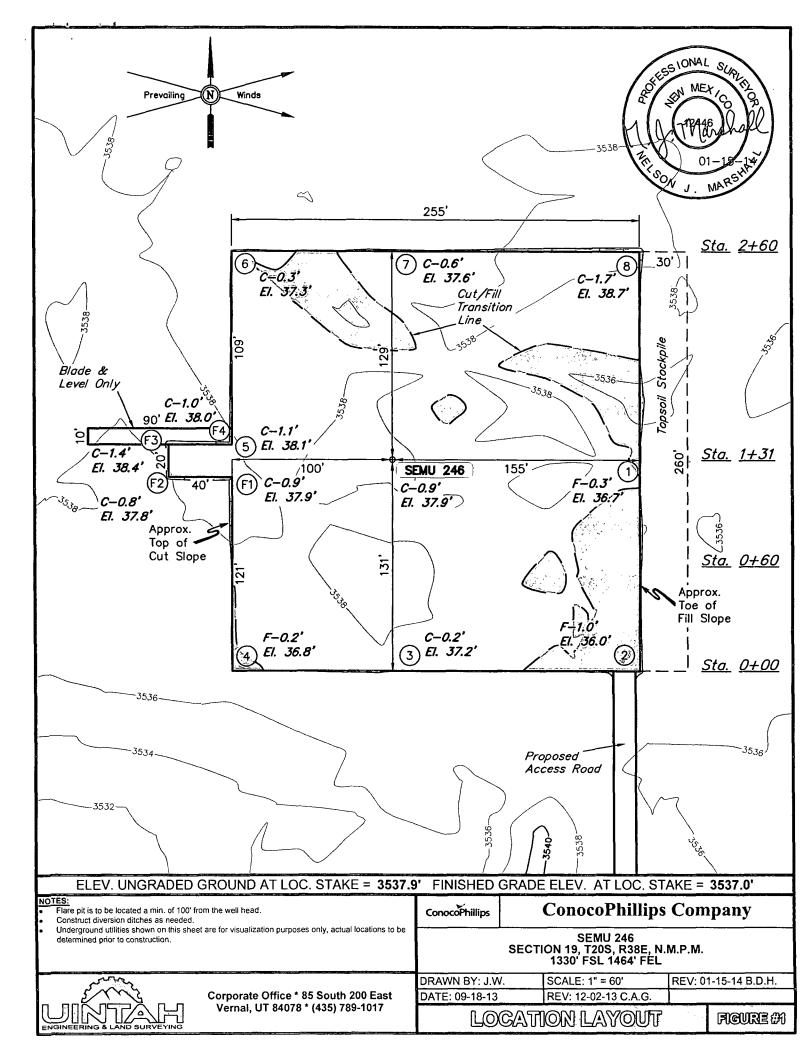


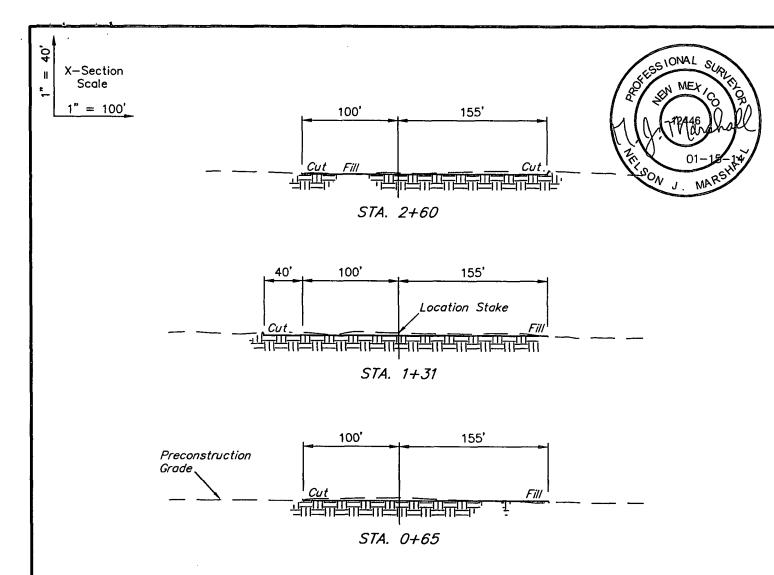


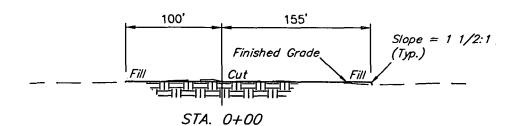


APPROXIMATE EARTHWO	ORK QUANTITIES	APPROXIMATE SURFACE DIS	TURBANCE AREAS	
(6") TOPSOIL STRIPPING	1,260 Cu. Yds.		DISTANCE	ACRES
REMAINING LOCATION	570 Cu. Yds.	WELL SITE DISTURBANCE	NA	±1.738
TOTAL CUT	1,830 Cu. Yds.	ACCESS ROAD DISTURBANCE	±568.69'	±0.261
FILL	570 Cu. Yds.	PIPELINE DISTURBANCE	±4475.57'	±0.616
EXCESS MATERIAL	1,260 Cu. Yds.	POWER LINE DISTURBANCE	±603.62'	±0.139
TOPSOIL	1,260 Cu. Yds.			
EXCESS UNBALANCE (After Interim Rehabilitation)	0 Cu. Yds.	TOTAL DISTURBANCE	±5647.88'	±2.754

1		l ocu, rus.				<del></del>	
L	(After Interim Rehabilitation)				*** •-••		
<u>NO</u>	NOTES:  Fill quantity includes 5% for compaction.  Topsoil should not be stripped below finished grade on substructure area.			ConocoPhillips	ConocoPhillips	Com	npany
				SE	SEMU 246 CTION 19, T20S, R38E, N 1330' FSL 1464' FEL	.M.P.M.	
	many			DRAWN BY: J.W.	SCALE: AS SHOWN	REV: 0	1-15-14 B.D.H.
	<i>-</i>	prporate Office * 85 South 200		DATE: 09-18-13	REV: 12-30-13 B.D.H.		
	IGINEERING & LAND SURVEYING	Vernal, UT 84078 * (435) 789-1017	)17	TYPICAL	CROSS SECTIO		FIGURE #2

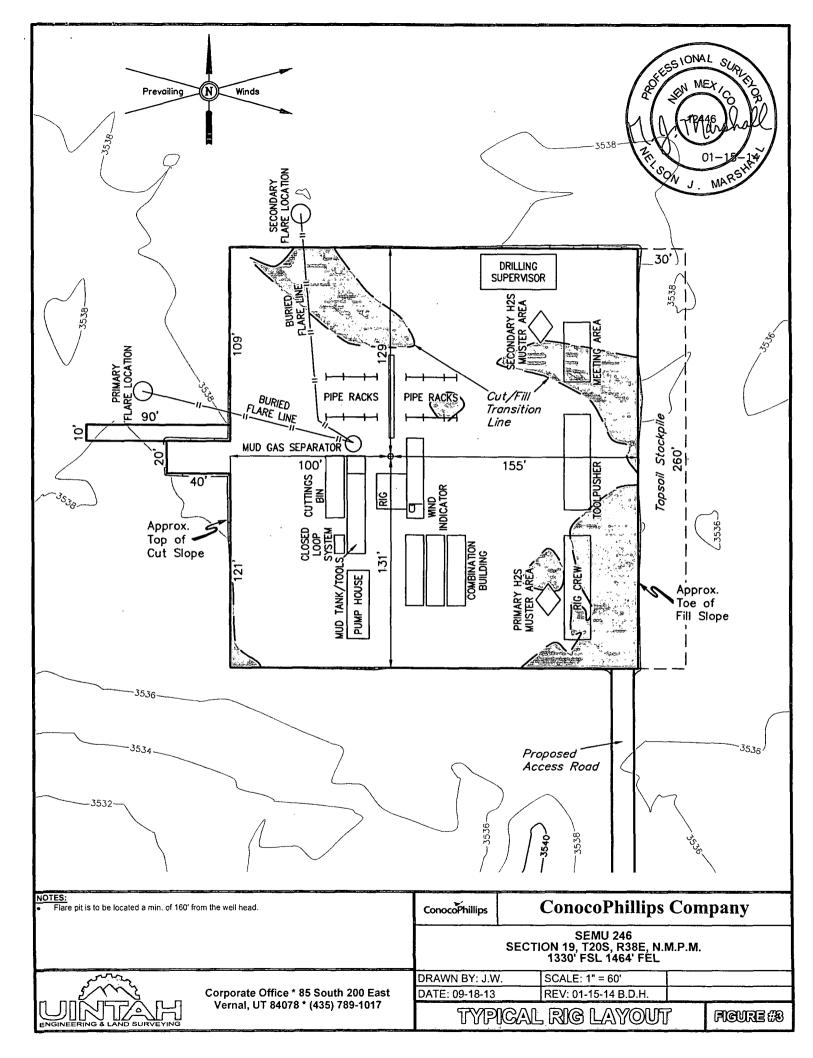

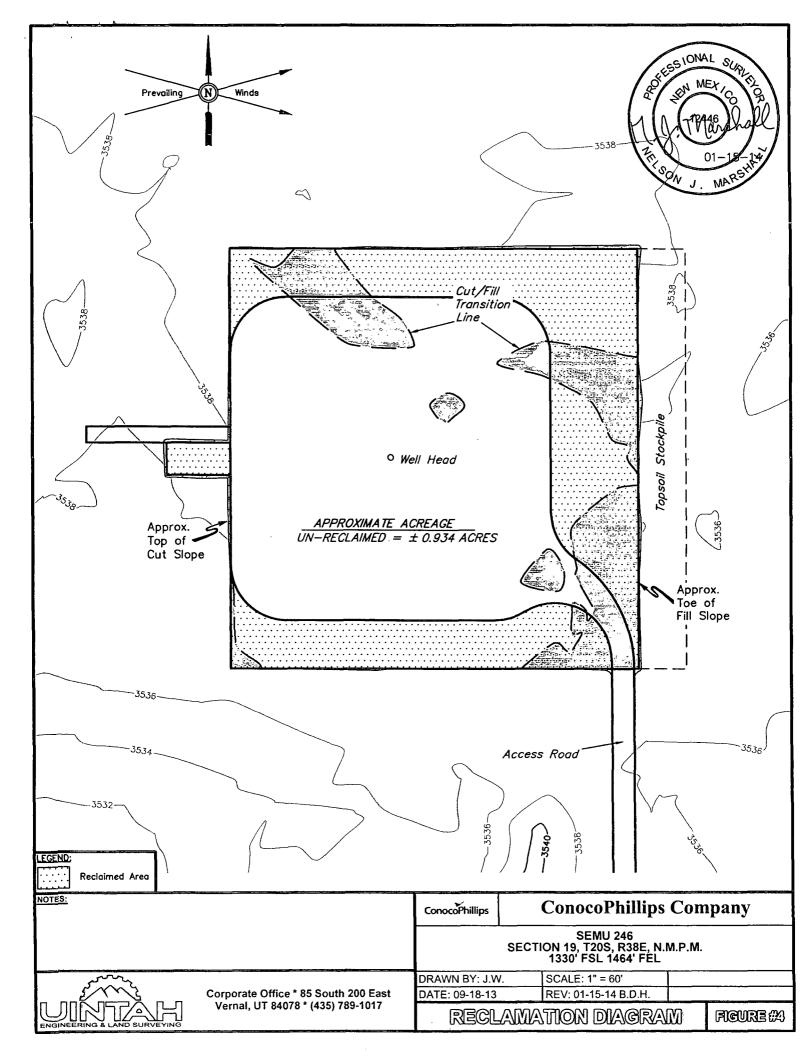


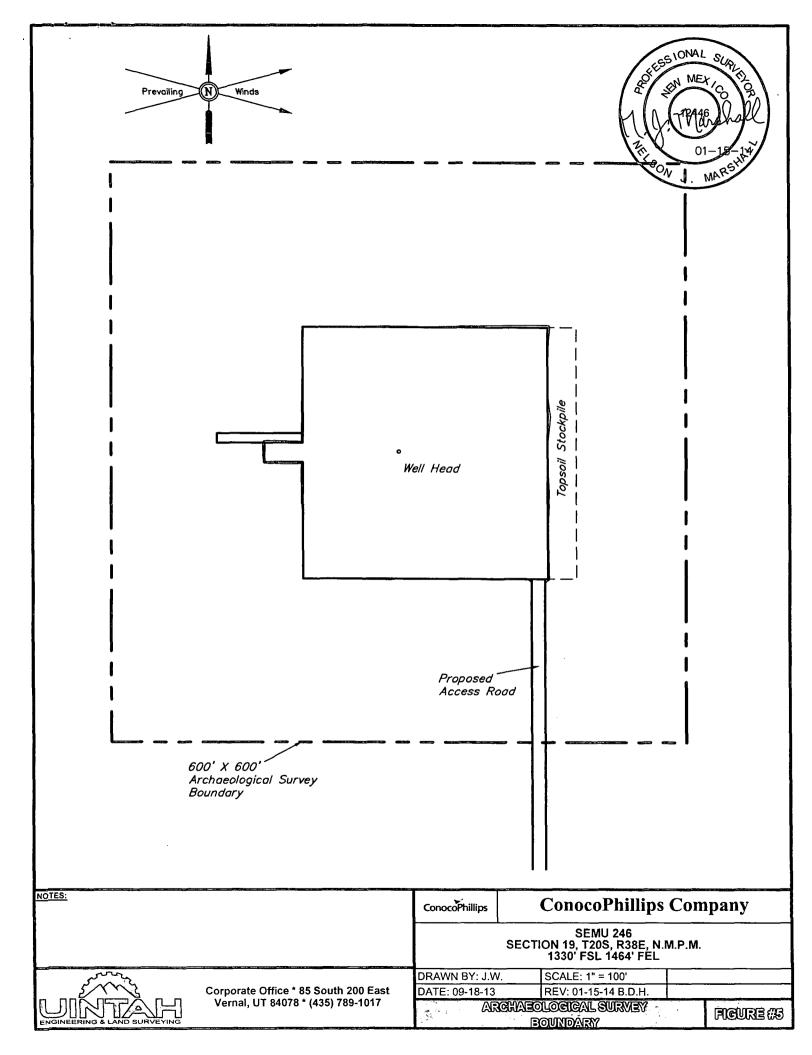



## ConocoPhillips Company SEMU 246 SECTION 19, T20S, R38E, N.M.P.M.


BEGINNING AT THE INTERSECTION OF U.S. HIGHWAY 62/U.S. HIGHWAY 180 AND HIGHWAY 18, PROCEED IN A SOUTHERLY DIRECTION FROM HOBBS, NEW MEXICO ALONG HIGHWAY 18 APPROXIMATELY 10.7 MILES TO THE JUNCTION OF THIS ROAD AND AN EXISTING ROAD TO THE WEST; TURN RIGHT AND PROCEED IN A WESTERLY DIRECTION APPROXIMATELY 3.5 MILES TO THE JUNCTION OF THIS ROAD AND AN EXISTING ROAD TO THE NORTH; TURN RIGHT AND PROCEED IN A NORTHERLY, THEN NORTHWESTERLY DIRECTION APPROXIMATELY 1.0 MILES TO THE JUNCTION OF THIS ROAD AND AN EXISTING ROAD TO THE EAST; TURN RIGHT AND PROCEED IN AN EASTERLY DIRECTION APPROXIMATELY 0.8 MILES TO THE BEGINNING OF THE PROPOSED ACCESS TO THE NORTH; FOLLOW ROAD FLAGS IN A NORTHERLY DIRECTION APPROXIMATELY 569' TO THE PROPOSED LOCATION.


TOTAL DISTANCE FROM HOBBS, NEW MEXICO TO THE PROPOSED LOCATION IS APPROXIMATELY 16.1 MILES.

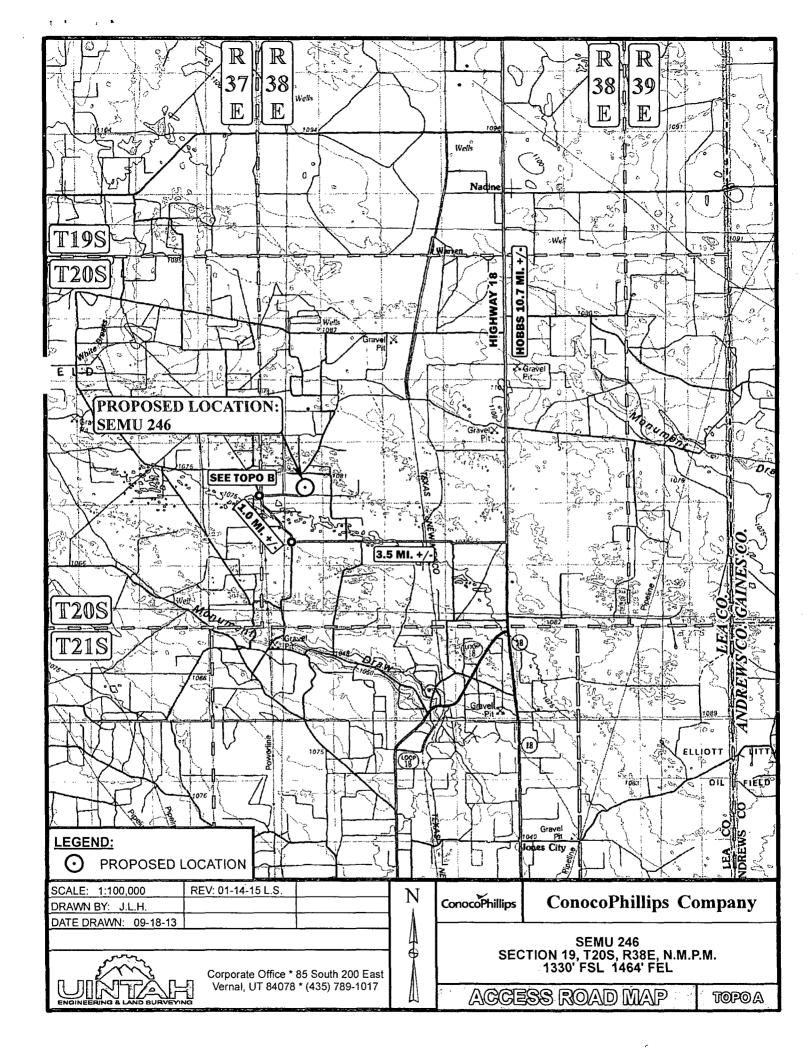


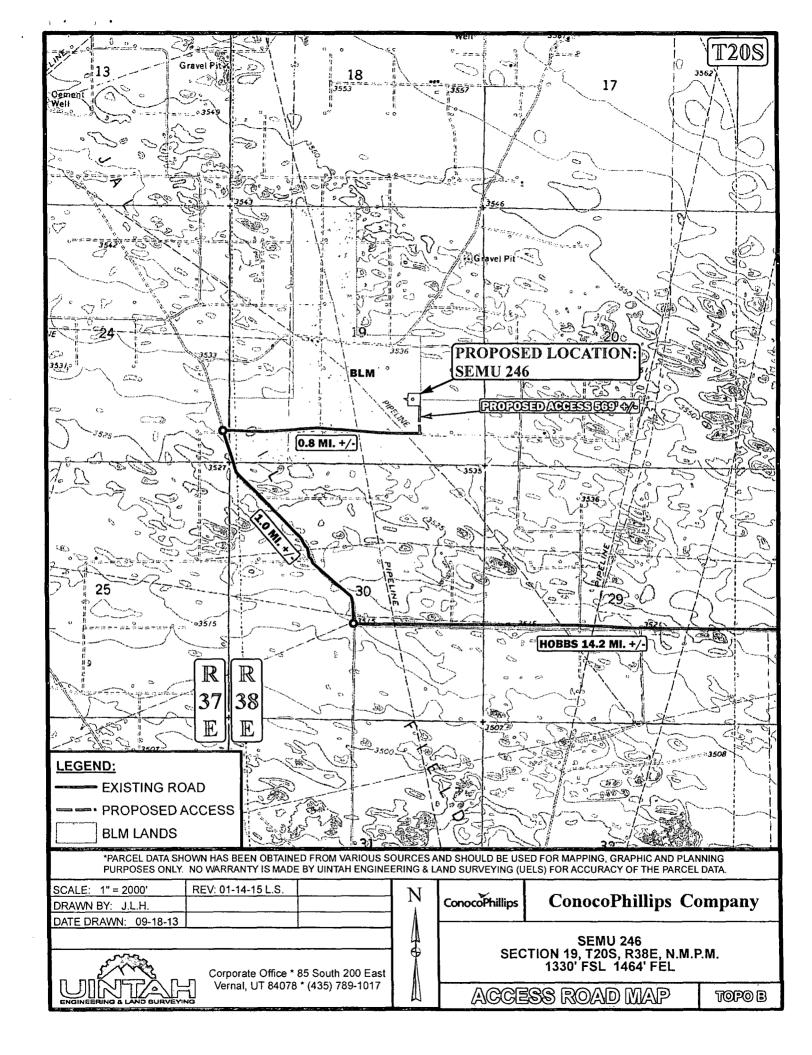

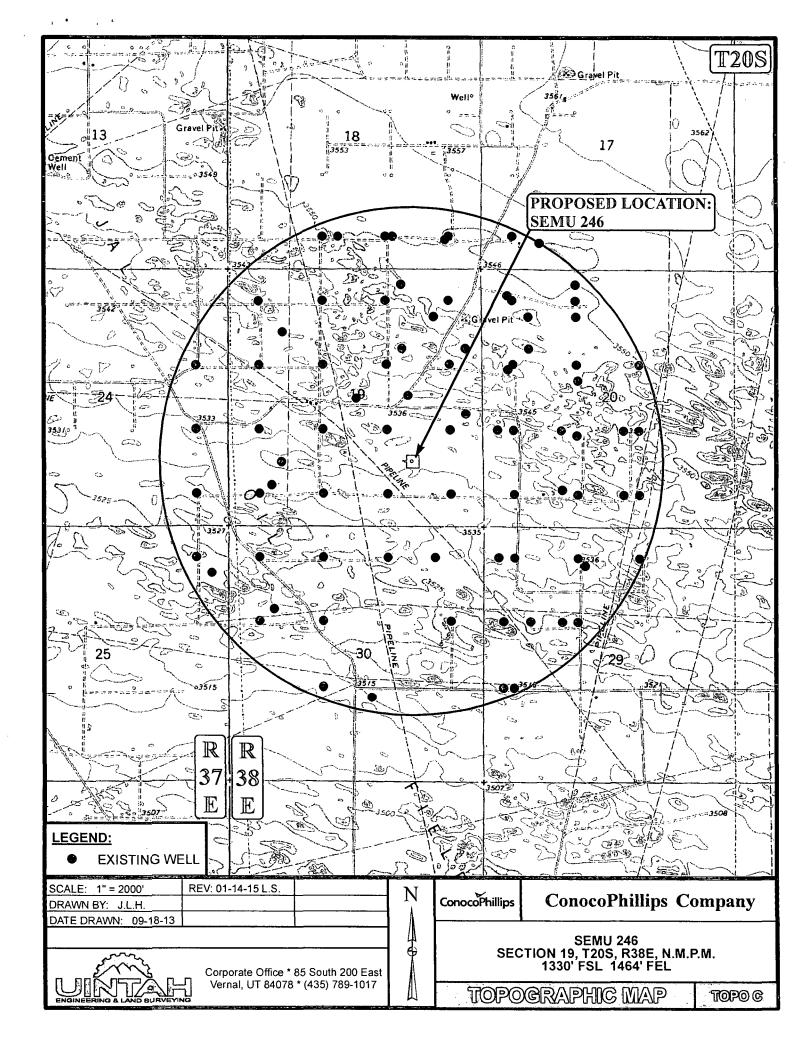

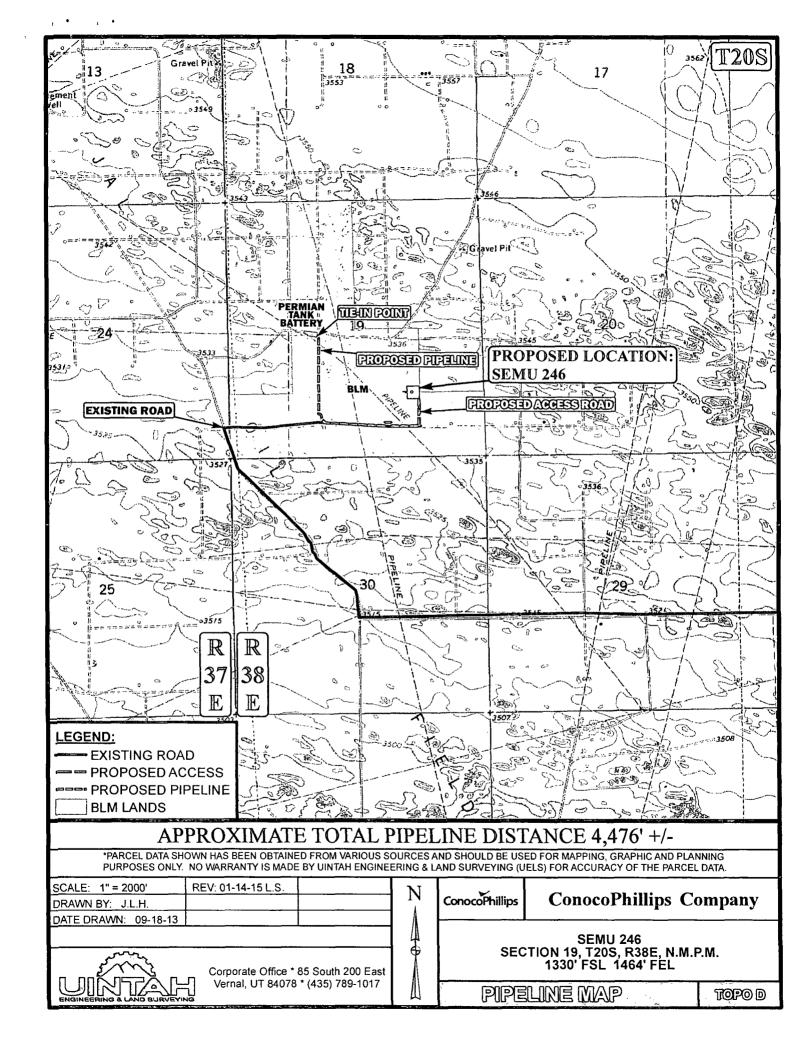

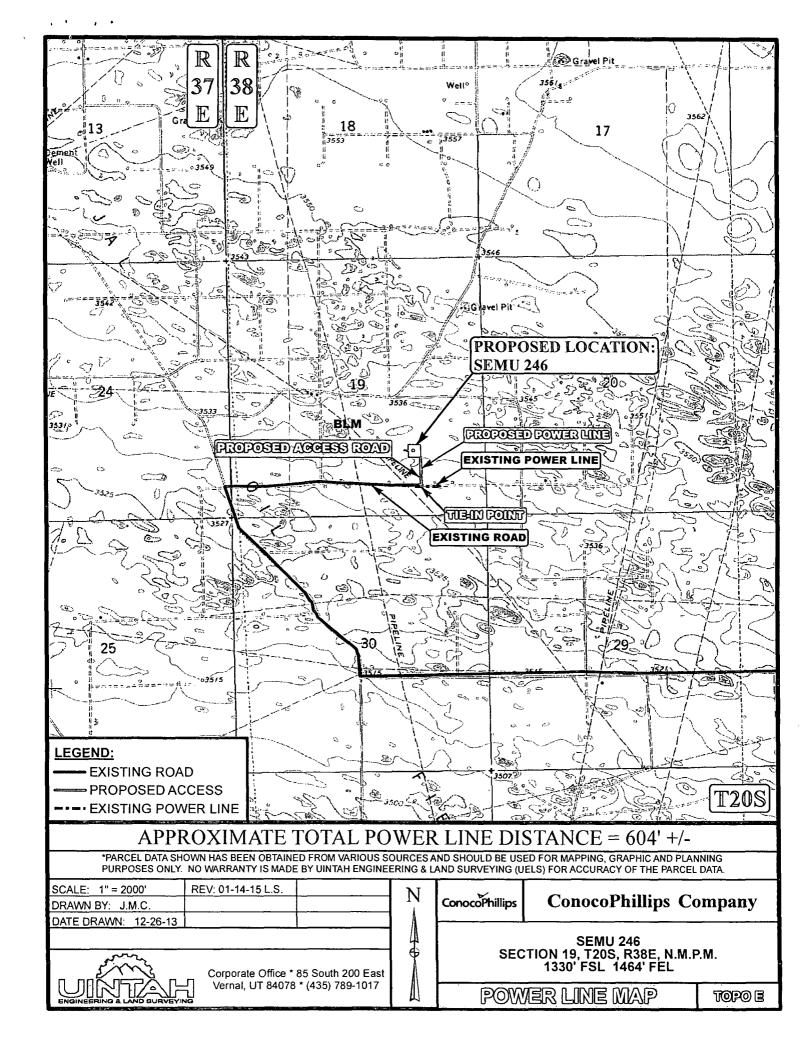

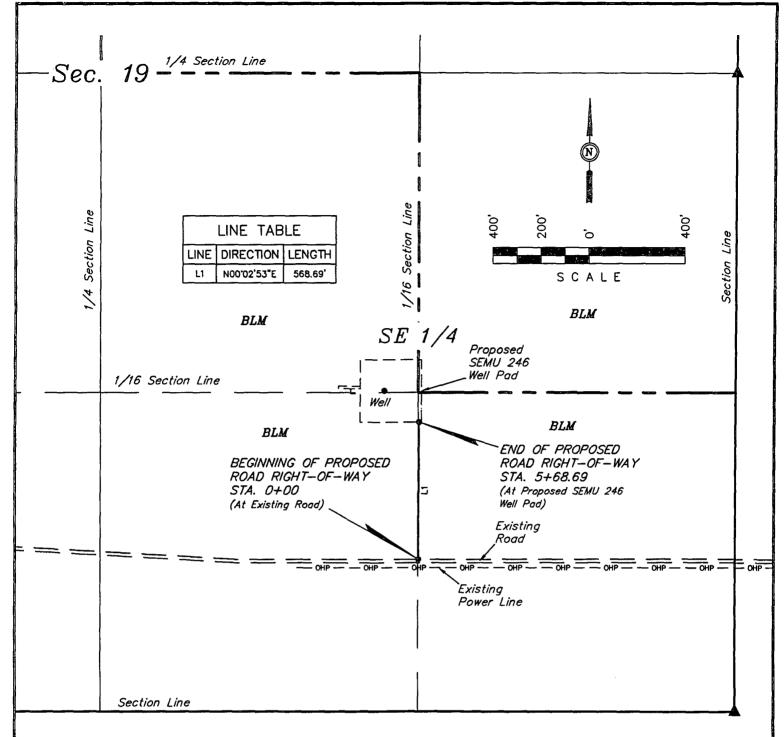

# ROAD RIGHT-OF-WAY DESCRIPTION

A 20' WDE RIGHT-OF-WAY 10' ON EACH SIDE OF THE FOLLOWING DESCRIBED CENTERLINE.

BEGINNING AT A POINT IN THE SE 1/4 SE 1/4 OF SECTION 19, T2OS, R38E, N.M.P.M., WHICH BEARS N47'42'37'W 1783.66' FROM THE SOUTHEAST CORNER OF SAID SECTION 19, THENCE NOO'02'53"E 568.69' TO A POINT IN THE SE 1/4 SE 1/4 OF SAID SECTION 19, WHICH BEARS N64'25'56"W 1463.24' FROM THE SOUTHEAST CORNER OF SAID SECTION 19. THE SIDE LINES OF SAID DESCRIBED RIGHT—OF—WAY BEING SHORTENED OR ELONGATED TO MEET THE GRANTOR'S PROPERTY LINES. BASIS OF BEARINGS IS A G.P.S. OBSERVATION. CONTAINS 0.261 ACRES MORE OR LESS.

▲ = SECTION CORNERS LOCATED.

RIGHT-OF-WAY LENGTHS						
PROPERTY OWNER FEET ACRES RODS						
BLM 568.69 0.261 34.47						

BEGINNING OF ROAD STA. 0+00 BEARS N47'42'37"W 1783.66' FROM THE SOUTHEAST CORNER OF SECTION 19, T20S, R38E, N.M.P.M.

END OF ROAD STA. 5+68.69 BEARS N64'25'56"W 1463.24' FROM THE SOUTHEAST CORNER OF SECTION 19, T20S, R38E, N.M.P.M.


### CERTIFICATE

THIS IS TO CERTIFY THAT THE ABOVE PLAT WAS PREPARED FROM FIELD NOTES OF ACTUAL SURVEYS MADE BY ME OR UNDER MY SUPERVISION AND THAT THE SAME ARE TRUE AND CORRECT TO THE BEST OF MY KNOWLEDGE AND BELIEF.

REGISTRATION NO. 12446

REGISTRATION NO. 12446
STATE OF MEW MEXICOLAR O1-15-14

NOTES:  The maximum grade of existing ground for the proposed access road is ±1%.		ConocoPhillips	ConocoPhillips Company		
		SE	SEMU 246 CTION 19, T20S, R38E, N.M.P.M. 1330' FSL 1464' FEL		
		DRAWN BY: J.W.	SCALE: 1" = 400'		
	Corporate Office * 85 South 200 East Vernal, UT 84078 * (435) 789-1017	DATE: 09-18-13	REV: 01-15-14 B.D.H.		
ENGINEERING & LAND SURVEYING		ACCE	S ROAD R-O-W	ENERGE EN	

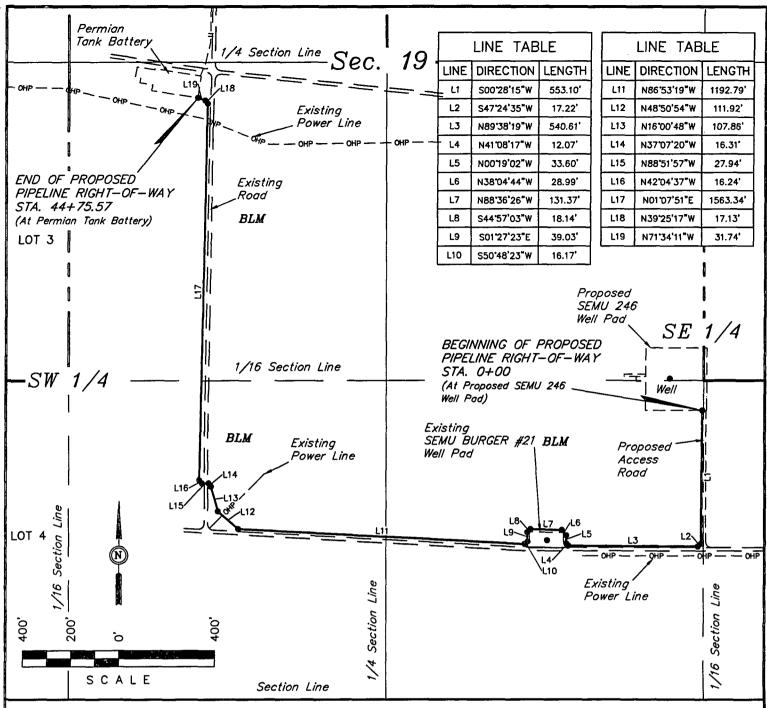

### PIPELINE RIGHT-OF-WAY DESCRIPTION

A 6' WIDE RIGHT-OF-WAY 3' ON EACH SIDE OF THE FOLLOWING DESCRIBED CENTERLINE.

BEGINNING AT A POINT IN THE SW 1/4 SE 1/4 OF SECTION 19, T20S, R38E, N.M.P.M., WHICH BEARS N47'53'03"W 1789.65' FROM THE SOUTHEAST CORNER OF SAID SECTION 19, THENCE S00'28'15"W 553.10'; THENCE S47'24'35"W 17.22'; THENCE N89'38'19"W 540.61'; THENCE N41'08'17"W 12.07'; THENCE N00'19'02"W 33.60'; THENCE N38'04'44"W 28.99'; THENCE N88'36'26"W 131.37'; THENCE S44'57'03"W 18.14'; THENCE S01'27'23"E 39.03'; THENCE S50'48'23"W 16.17'; THENCE N86'53'19"W 1192.79'; THENCE N48'50'54"W 111.92'; THENCE N16'00'48"W 107.86'; THENCE N37'07'20"W 16.31'; THENCE N88'51'57"W 27.94'; THENCE N42'04'37"W 16.24'; THENCE N01'07'51"E 1563.34'; THENCE N42'04'37"W 16.24'; THENCE N71'34'11"W 31.74' TO A POINT IN THE NE 1/4 SW 1/4 OF SAID SECTION 19, WHICH BEARS S85'26'48"E 1875.20' FROM THE WEST 1/4 CORNER OF SAID SECTION 19. THE SIDE LINES OF SAID DESCRIBED RIGHT—OF—WAY BEING SHORTENED OR ELONGATED TO MEET THE GRANTOR'S PROPERTY LINES. BASIS OF BEARINGS IS A G.P.S. OBSERVATION. CONTAINS 0.616 ACRES MORE OR LESS.

RIGHT-OF-WAY LENGTHS						
PROPERTY OWNER	PROPERTY OWNER FEET ACRES RODS					
BLM SE 1/4	2005.54	0.276	121.55			
BLM SW 1/4	2470.03	0.340	149.70			
TOTAL	4475.57	0.616	271.25			

BEGINNING OF PIPELINE STA. 0+00 BEARS N47'53'03"W 1789.65' FROM THE SOUTHEAST CORNER OF SECTION 19, T20S, R38E, N.M.P.M.

END OF PIPELINE STA. 44+75.57 BEARS S85'26'48"E 1875.20' FROM THE WEST 1/4 CORNER OF SECTION 19, T20S, R38E, N.M.P.M.

▲ = SECTION CORNERS LOCATED.

### CERTIFICATE


THIS IS TO CERTIFY THAT THE ABOVE PLAT WAS PREPARED FROM FIELD NOTES OF ACTUAL SURVEYS MADE BY ME OR UNDER MY SUPERVISION AND THAT THE SAME ARE TRUE AND CORRECT TO THE BEST OF MY KNOWLEDGE AND BELIEF.

BELIEF.

DELIEF.

DEL

NOTES:		ConocoPhillips	ConocoPhillips Company	
		SEMU 246 SECTION 19, T20S, R38E, N.M.P.M. 1330' FSL 1464' FEL		
and the same	<del></del>	DRAWN BY: J.W.	SCALE: 1" = 400'	
5 1 2 3 S	Corporate Office * 85 South 200 East	DATE: 09-18-13	REV: 01-15-14 B.D.H.	
ENGINEERING & LAND SURVEYING	Vernal, UT 84078 * (435) 789-1017	PIPE	ELINE R-O-W FIGURE 77	

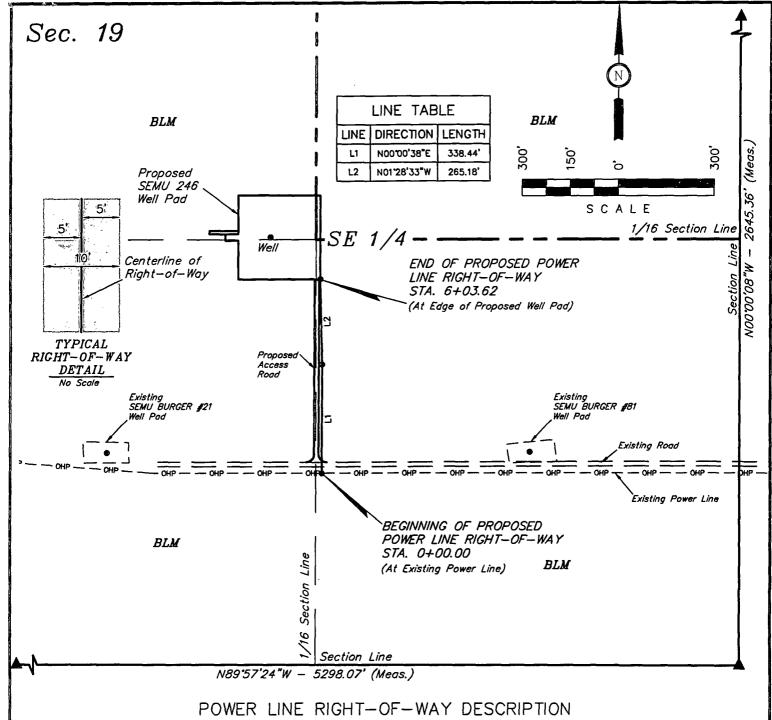

A 10' WIDE RIGHT-OF-WAY 5' ON EACH SIDE OF THE FOLLOWING DESCRIBED CENTERLINE.

BEGINNING AT A POINT IN THE SE 1/4 SE 1/4 OF SECTION 19, T20S, R38E, N.M.P.M., WHICH BEARS N65'23'33"W 1432.88' FROM THE SOUTHEAST CORNER OF SAID SECTION 19, THENCE N00'00'38"E 338.44'; THENCE N01'28'33"W 265.18' TO A POINT IN THE SE 1/4 SE 1/4 OF SAID SECTION 19, WHICH BEARS N47'29'40"W 1776.29' FROM THE SOUTHEAST CORNER OF SAID SECTION 19. THE SIDE LINES OF SAID DESCRIBED RIGHT-OF-WAY BEING SHORTENED OR ELONGATED TO MEET THE GRANTOR'S PROPERTY LINES. BASIS OF BEARINGS IS A G.P.S. OBSERVATION. CONTAINS 0.139 ACRES MORE OR LESS.

BEGINNING OF POWER LINE STA. 0+00 BEARS N65°23'33"W 1432.88' FROM THE SOUTHEAST CORNER OF SECTION 19, T20S, R38E, N.M.P.M.


END OF POWER LINE STA. 6+03.62 BEARS N47'29'40"W 1776.29' FROM THE SOUTHEAST CORNER OF SECTION 19, T20S, R38E, N.M.P.M.


RIGHT-OF-WAY LENGTHS					
DESCRIPTION	FEET	ACRES	RODS		
BLM	603.62	0.139	36.58		

▲ = SECTION CORNERS LOCATED.

CERTIFICATE SS ONAL SUPERIOR THAT THE ABOVE PLAT WAS MEREPARED FROM FIELD NOTES OF ACTUAL SURVEY MADE BY HE OR UNDER WAS SUPERVISION AND THAT THE SAME ARE TRUE AND CORRECT TO THE BEST OF MY KNOWLEDGE AND BELIEF.

REGISTRATION NO. 12446 STATE OF NEW MEXICON 1 1 15 14

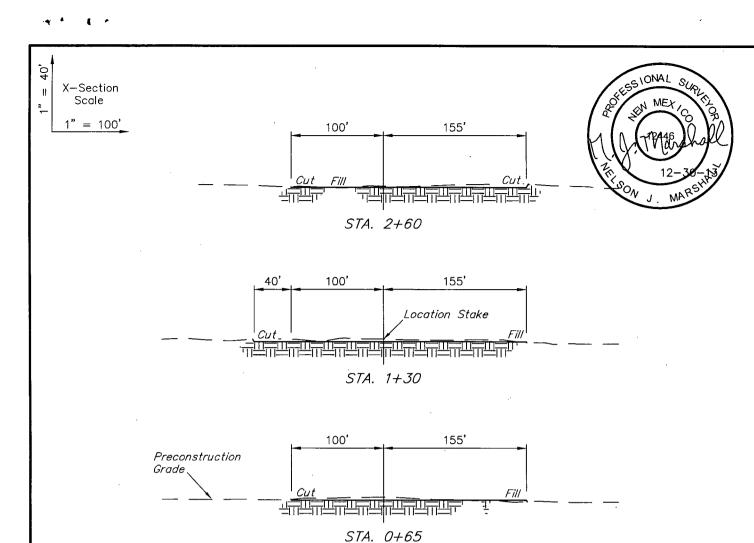

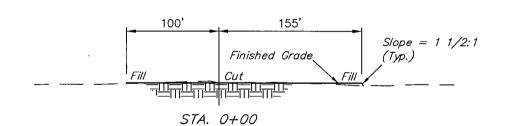

APPROXIMATE EARTHWORK QUANTITIES		APPROXIMATE SURFACE DIS	<b>FURBANCE AREAS</b>	
(6") TOPSOIL STRIPPING	1,260 Cu. Yds.		DISTANCE	ACRES
REMAINING LOCATION	570 Cu. Yds.	WELL SITE DISTURBANCE	NA	±1.738
TOTAL CUT	1,830 Cu. Yds.	ACCESS ROAD DISTURBANCE	±568.69'	±0.261
FILL	570 Cu. Yds.	PIPELINE DISTURBANCE	±4475.57'	±0.616
EXCESS MATERIAL	1,260 Cu. Yds.	POWER LINE DISTURBANCE	±603.62'	±0.139
TOPSOIL	1,260 Cu. Yds.	TOTAL DISTURDANCE	. = 0 ( = 00)	
EXCESS UNBALANCE	0 Cu. Yds.	TOTAL DISTURBANCE ±564		±2.754

EXCESS UNBALANCE (After Interim Rehabilitation)	0 Cu. Yds.				
NOTES:  Fill quantity includes 5% for compaction.  Topsoil should not be stripped below fini		ConocoPhillips	ConocoPhillips	Company	
		SEMU 246 SECTION 19, T20S, R38E, N.M.P.M. 1329' FSL 1464' FEL			
455		DRAWN BY: J.W.	SCALE: AS SHOWN		
	Corporate Office * 85 South 200 East	DATE: 09-18-13	REV: 12-30-13 B.D.H.		
ENGINEERING & LAND SURVEYING	Vernal, UT 84078 * (435) 789-1017	TYPICAL	. CROSS SECTION	S FIGURE #2	