District I
1625 N. French Dr., Hobbs, NM 88240
Phone: (575) 393-6161 Fax: (575) 393-0720
District II
811 S. First St., Artesia, NM 88210
Phone: (575) 748-1283 Fax: (575) 748-9720
District III
1000 Rio Brazos Road, Aztec, NM 87410
Phone: (505) 334-6178 Fax: (505) 334-6170
District IV
1220 S. St. Francis Dr., Sante Fe, NM 87505
Phone: (505) 476-3460 Fax: (505) 476-3462

State of New Mexico
Energy, Minerals & Natural Resources
Department
OIL CONSERVATION DIVISION
1220 South St. Francis Dr.
Sante Fe, NM 87505

FORM C-102
Revised August 1, 2011
Submit one copy to appropriate
District Office

☐ AMENDED REPORT

WELL LOCATION AND ACREAGE DEDICATION PLAT

[1]API Number	[2]Pool Code	[3]Pool Name
30-025-44546	~~97179~~ 17980	Dogie Draw;~~Delaware~~ WOLFCAMP

[4]Property Code	[5]Property Name	[6]Well Number
320549	LESLIE FED COM	215H

[7]OGRID No.	[8]Operator Name	[9]Elevation
228937	MATADOR PRODUCTION COMPANY	3313'

[10]Surface Location

UL or lot no.	Section	Township	Range	Lot Idn	Feet from the	North/South line	Feet from the	East/West line	County
M	17	25-S	35-E	-	295'	SOUTH	1162'	WEST	LEA

UL or lot no.	Section	Township	Range	Lot Idn	Feet from the	North/South line	Feet from the	East/West line	County
D	17	25-S	35-E	-	101'	NORTH	1253'	WEST	LEA

[12]Dedicated Acres	[13]Joint or Infill	[14]Consolidation Code	[15]Order No.
160			

No allowable will be assigned to this completion until all interests have been consolidated or a non-standard unit has been approved by the division.

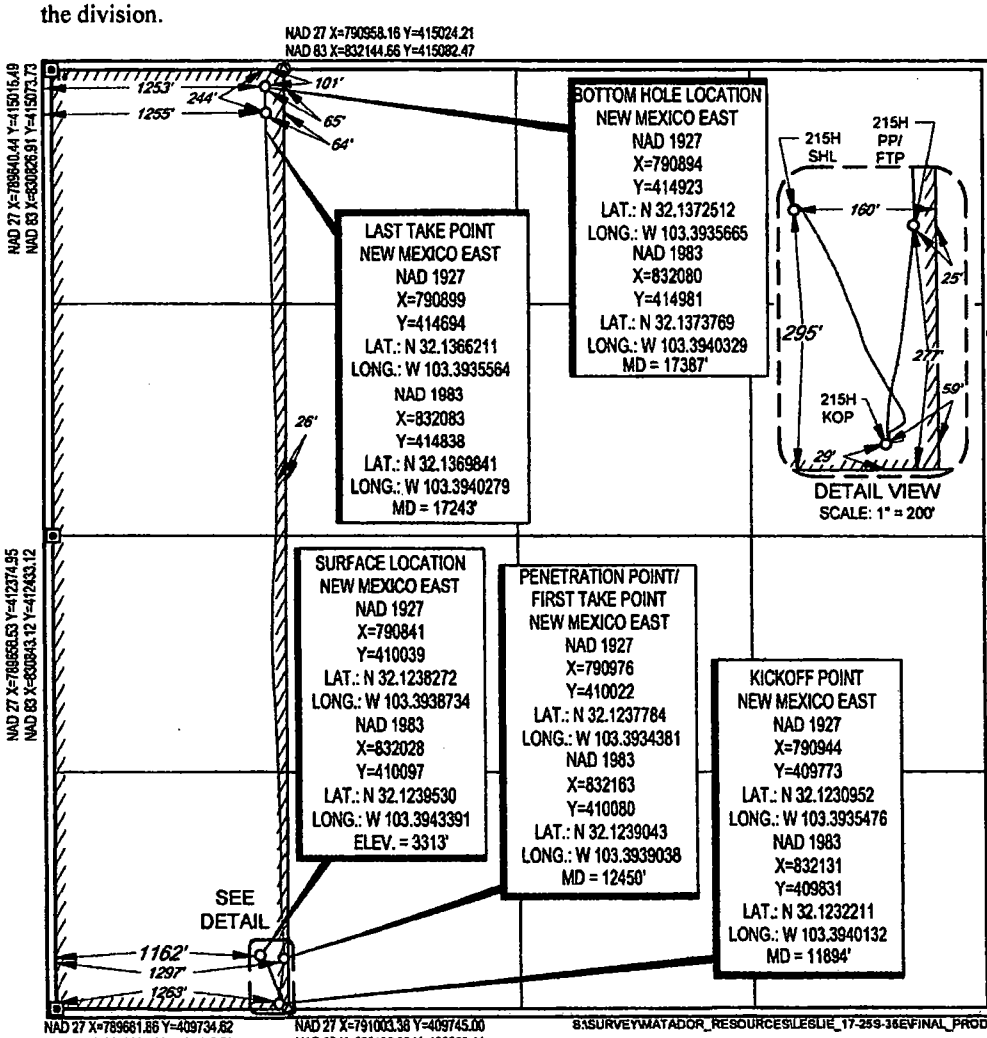

[17]OPERATOR CERTIFICATION

I hereby certify that the information contained herein is true and complete to the best of my knowledge and belief, and that this organization either owns a working interest or unleased mineral interest in the land including the proposed bottom hole location or has a right to drill this well at this location pursuant to a contract with an owner of such a mineral or working interest, or to a voluntary pooling agreement or a compulsory pooling order heretofore entered by the division.

Tammy R. Link 9/5/2019
Signature Date

Tammy R. Link
Printed Name

tlink@matadorresources.com
E-mail Address

[18]SURVEYOR CERTIFICATION

I hereby certify that the well location shown on this plat was plotted from field notes of actual surveys made by me or under my supervision, and that the same is true to the best of my belief.

11/28/2018
Date of Survey
Signature and Seal of Professional Surveyor

ANGEL M. BAEZA
NEW MEXICO
25116
PROFESSIONAL SURVEYOR

Certificate Number

S:\SURVEY\MATADOR_RESOURCES\LESLIE_17-25S-35E\FINAL_PRODUCTS\AD_LESLIE_FED_COM_215H.DWG 8/5/2019 11:51:18 AM jrichardson

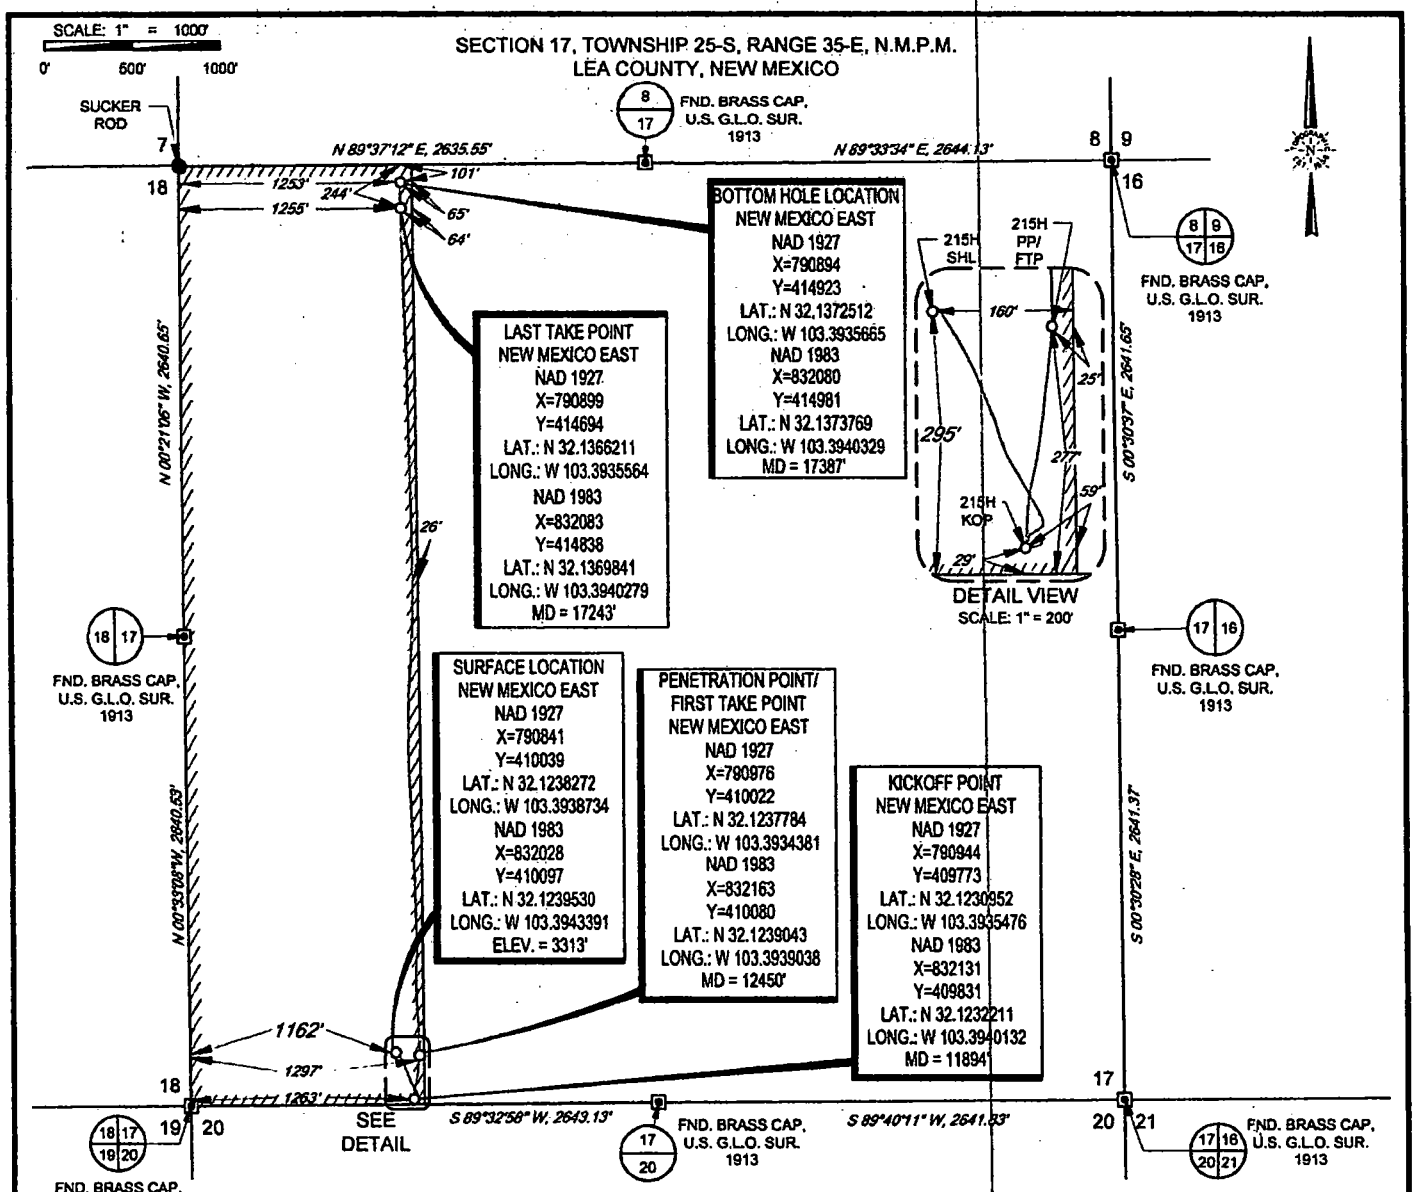

LEASE NAME & WELL NO.: LESLIE FED COM 215H

SECTION 17 TWP 25-S RGE 35-E SURVEY N.M.P.M.

COUNTY LEA STATE NM ELEVATION 3313'

DESCRIPTION 295' FSL & 1162' FWL

Matador PRODUCTION COMPANY

TOPOGRAPHIC
LOYALTY INNOVATION LEGACY
1400 EVERMAN PARKWAY, Ste. 146 - FT. WORTH, TEXAS 76140
TELEPHONE: (817) 744-7512 - FAX (817) 744-7554
2903 NORTH BIG SPRING - MIDLAND, TEXAS 79705
TELEPHONE: (432) 682-1653 OR (800) 767-1653 - FAX (432) 682-1743
WWW.TOPOGRAPHIC.COM

ANGEL M. BAEZA NEW MEXICO 25116 PROFESSIONAL SURVEYOR

Angel M. Baeza, P.S. No. 25116
SEPTEMBER 3, 2019

LESLIE FED COM 215H (AS-COMPLETED)	REVISION: INT	DATE
DATE: 09/03/19		
FILE: AD_LESLIE_FED_COM_215H		
DRAWN BY: A.M.D.		
SHEET: 1 OF 1		

NOTES:
1. ORIGINAL DOCUMENT SIZE: 8.5" X 11"
2. ALL BEARINGS, DISTANCES, AND COORDINATE VALUES CONTAINED HEREIN ARE GRID BASED UPON THE NEW MEXICO COORDINATE SYSTEM OF 1983, EAST ZONE, U.S. SURVEY FEET.
3. THIS WELL LOCATION SHOWN HEREON HAS BEEN SURVEYED ON THE GROUND UNDER MY SUPERVISION AND PREPARED ACCORDING TO THE EVIDENCE FOUND AT THE TIME OF SURVEY, AND DATA PROVIDED BY EOG RESOURCES, INC. THIS CERTIFICATION IS MADE AND LIMITED TO THOSE PERSONS OR ENTITIES SHOWN ON THE FACE OF THIS PLAT AND IS NON-TRANSFERABLE. THIS SURVEY IS CERTIFIED FOR THIS TRANSACTION ONLY.

B:\SURVEY\MATADOR_RESOURCES\LESLIE_17-25S-35E\FINAL_PRODUCTS\AD_LESLIE_FED_COM_215H.DWG 9/5/2019 11:51:19 AM jrichardson